

U.S. ROUTE 2
MARSHFIELD
F028-3(28)


C = 23 Sq Ft
F = 0 Sq Ft
R = 0 Sq Ft

REV. STA. 201+40 RT.
BEGIN 6" x 24" U.D.
H.F.B. @ 201+40 & 203+50
INSTALL FLUSHING BASIN

C = 0 Sq Ft
F = 136 Sq Ft
R = 0 Sq Ft

DATE	
BY	
SURVEYED	
PLOTTED	
AREA	
AREAS CHECKED	
FINAL SURVEY	
NOTE BOOK	
NO.	

DATE	10/86
BY	VT. SURVEY CONSULTANTS
SURVEYED	
PLOTTED	
AREA	
AREAS CHECKED	
ORIGINAL SURVEY	
NOTE BOOK	
NO.	

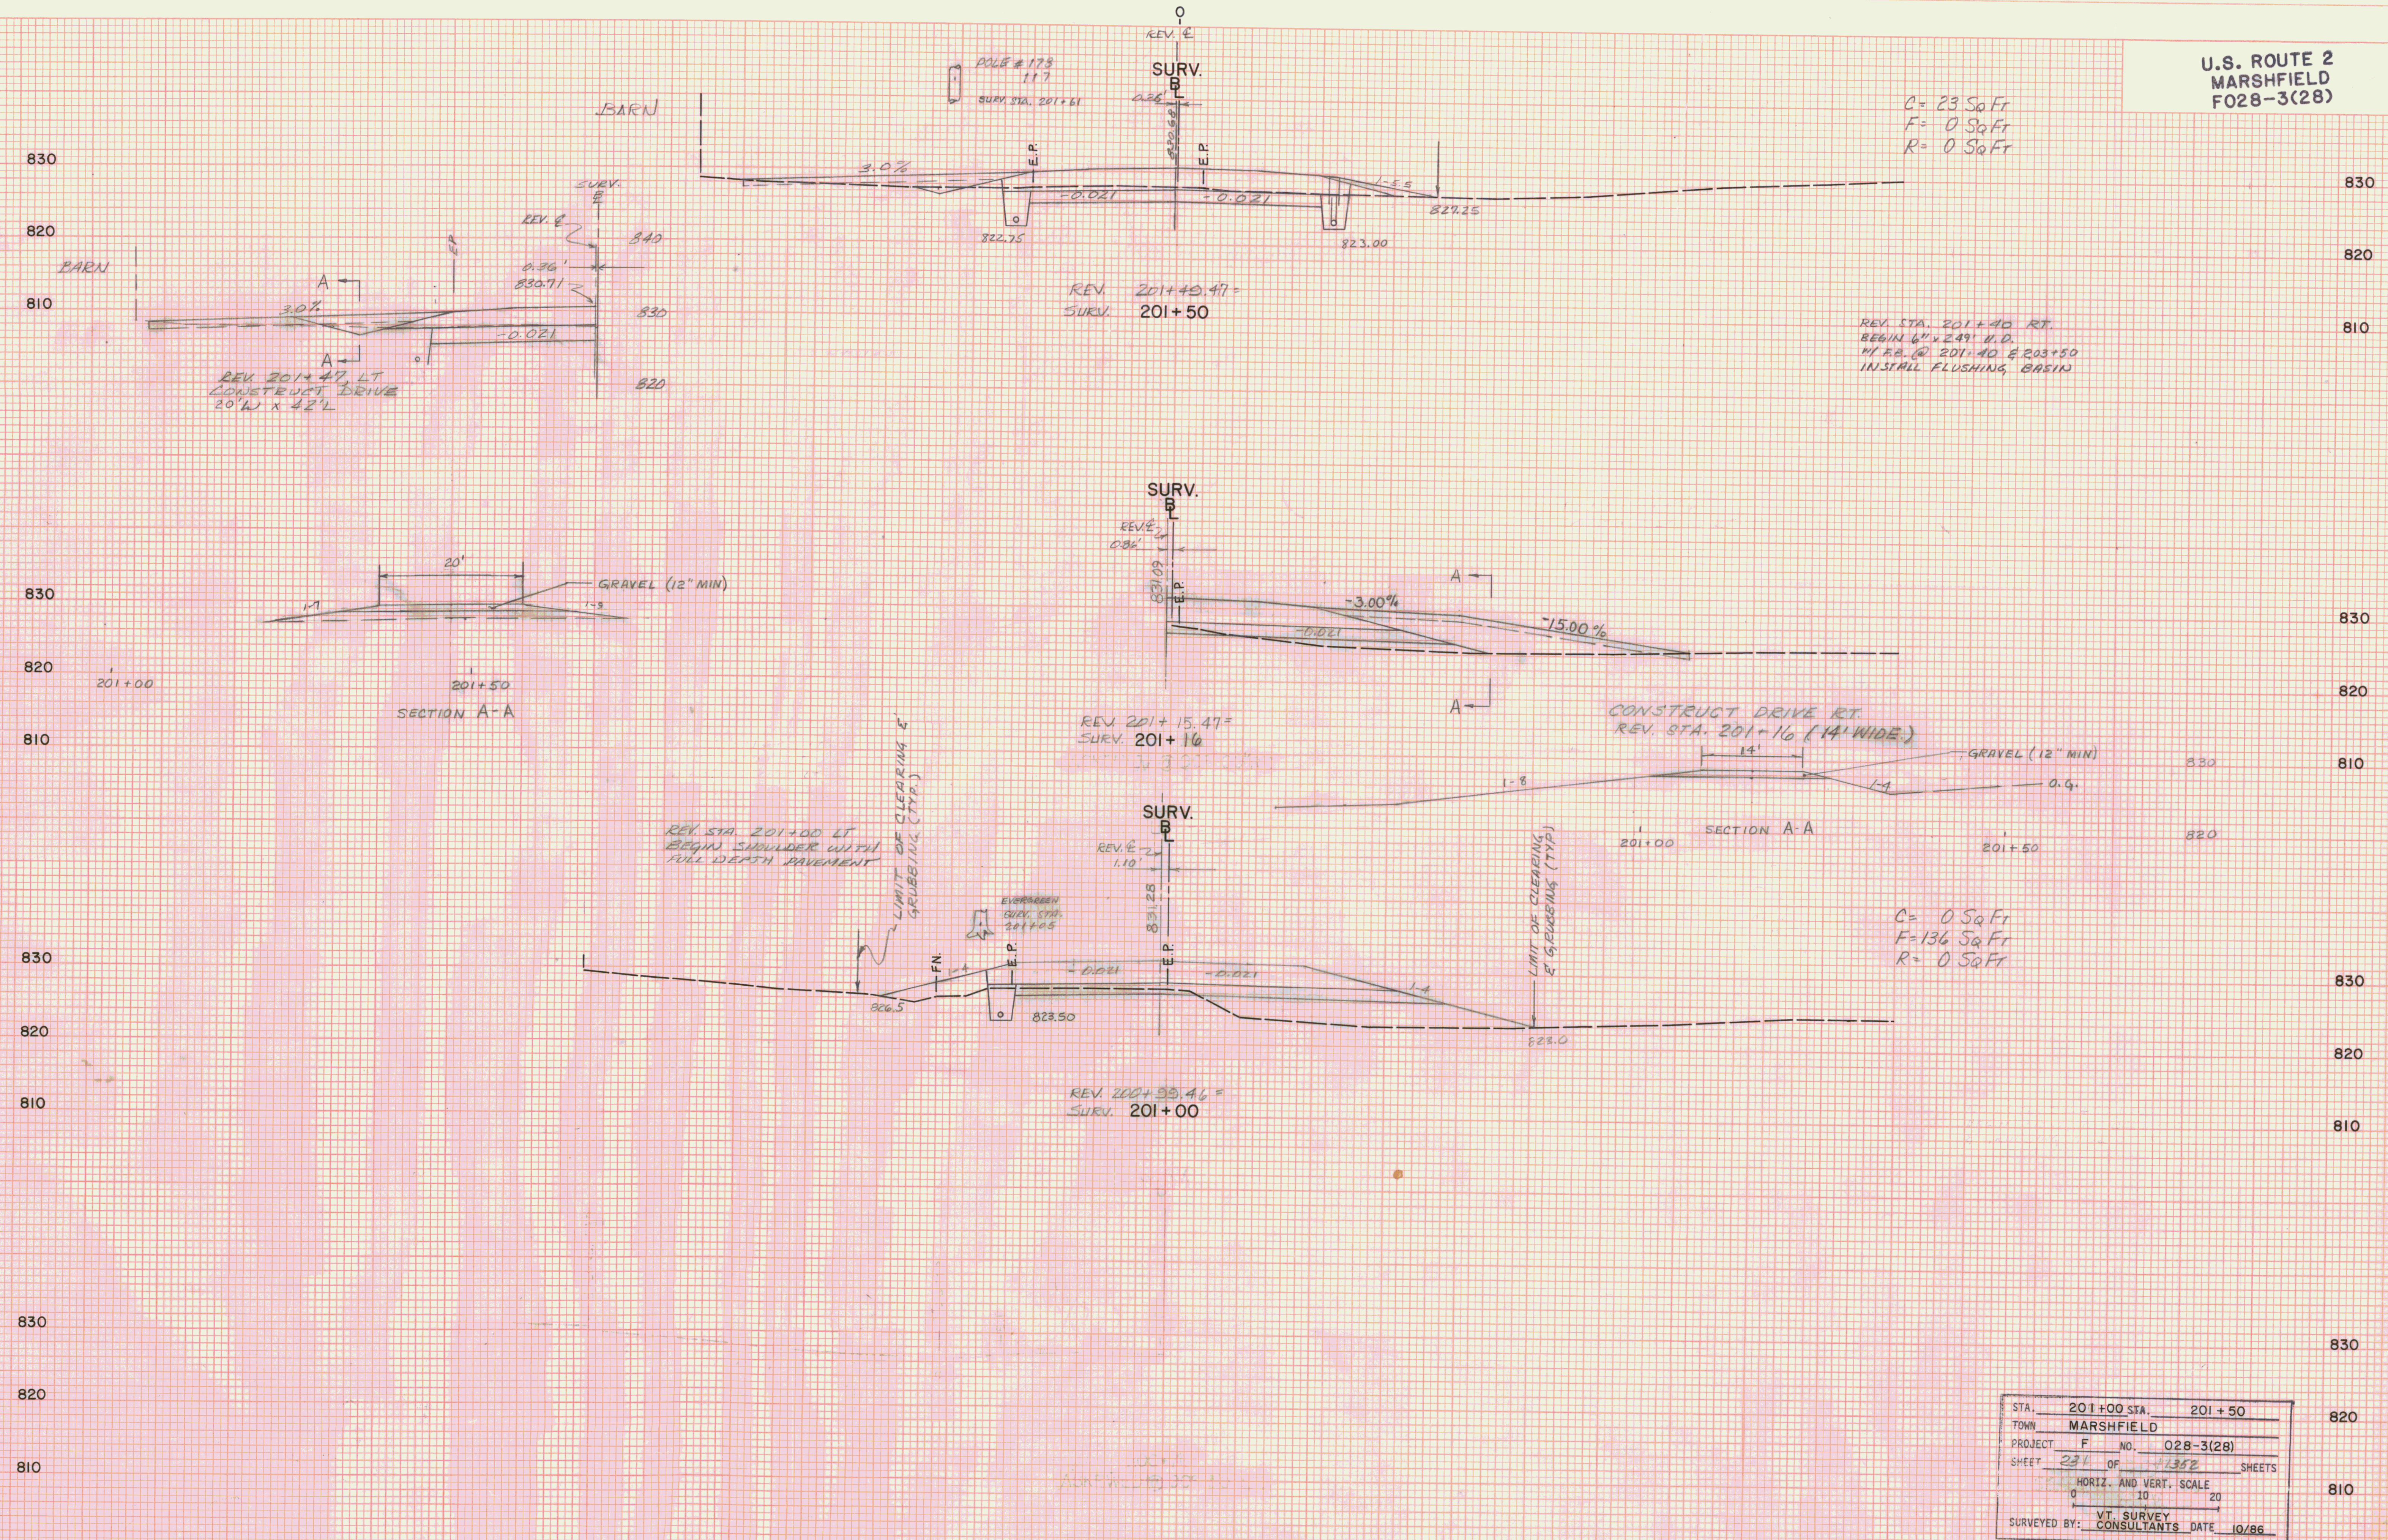

STA.	201+00 STA.	201+50
TOWN	MARSHFIELD	
PROJECT	F NO. 028-3(28)	
SHEET	231	OF 1352 SHEETS
HORIZ. AND VERT. SCALE		
0 10 20		
SURVEYED BY: VT. SURVEY CONSULTANTS DATE 10/86		