

FINAL SURVEY		BY	DATE
SURVEYED			
PLOTTED			
TEMPLATE			
AREAS			
AREAS CHECKED			
NO.			

ORIGINAL SURVEY	SURVEYED	BY	DATE
NOTED BOOK	PLOTTED	VT. SURVEY CONSULT.	10-86
	TEMPLATE	BRYANT ASSOC.	11-86
	AREAS		
	ADDITIONAL COMMENTS		

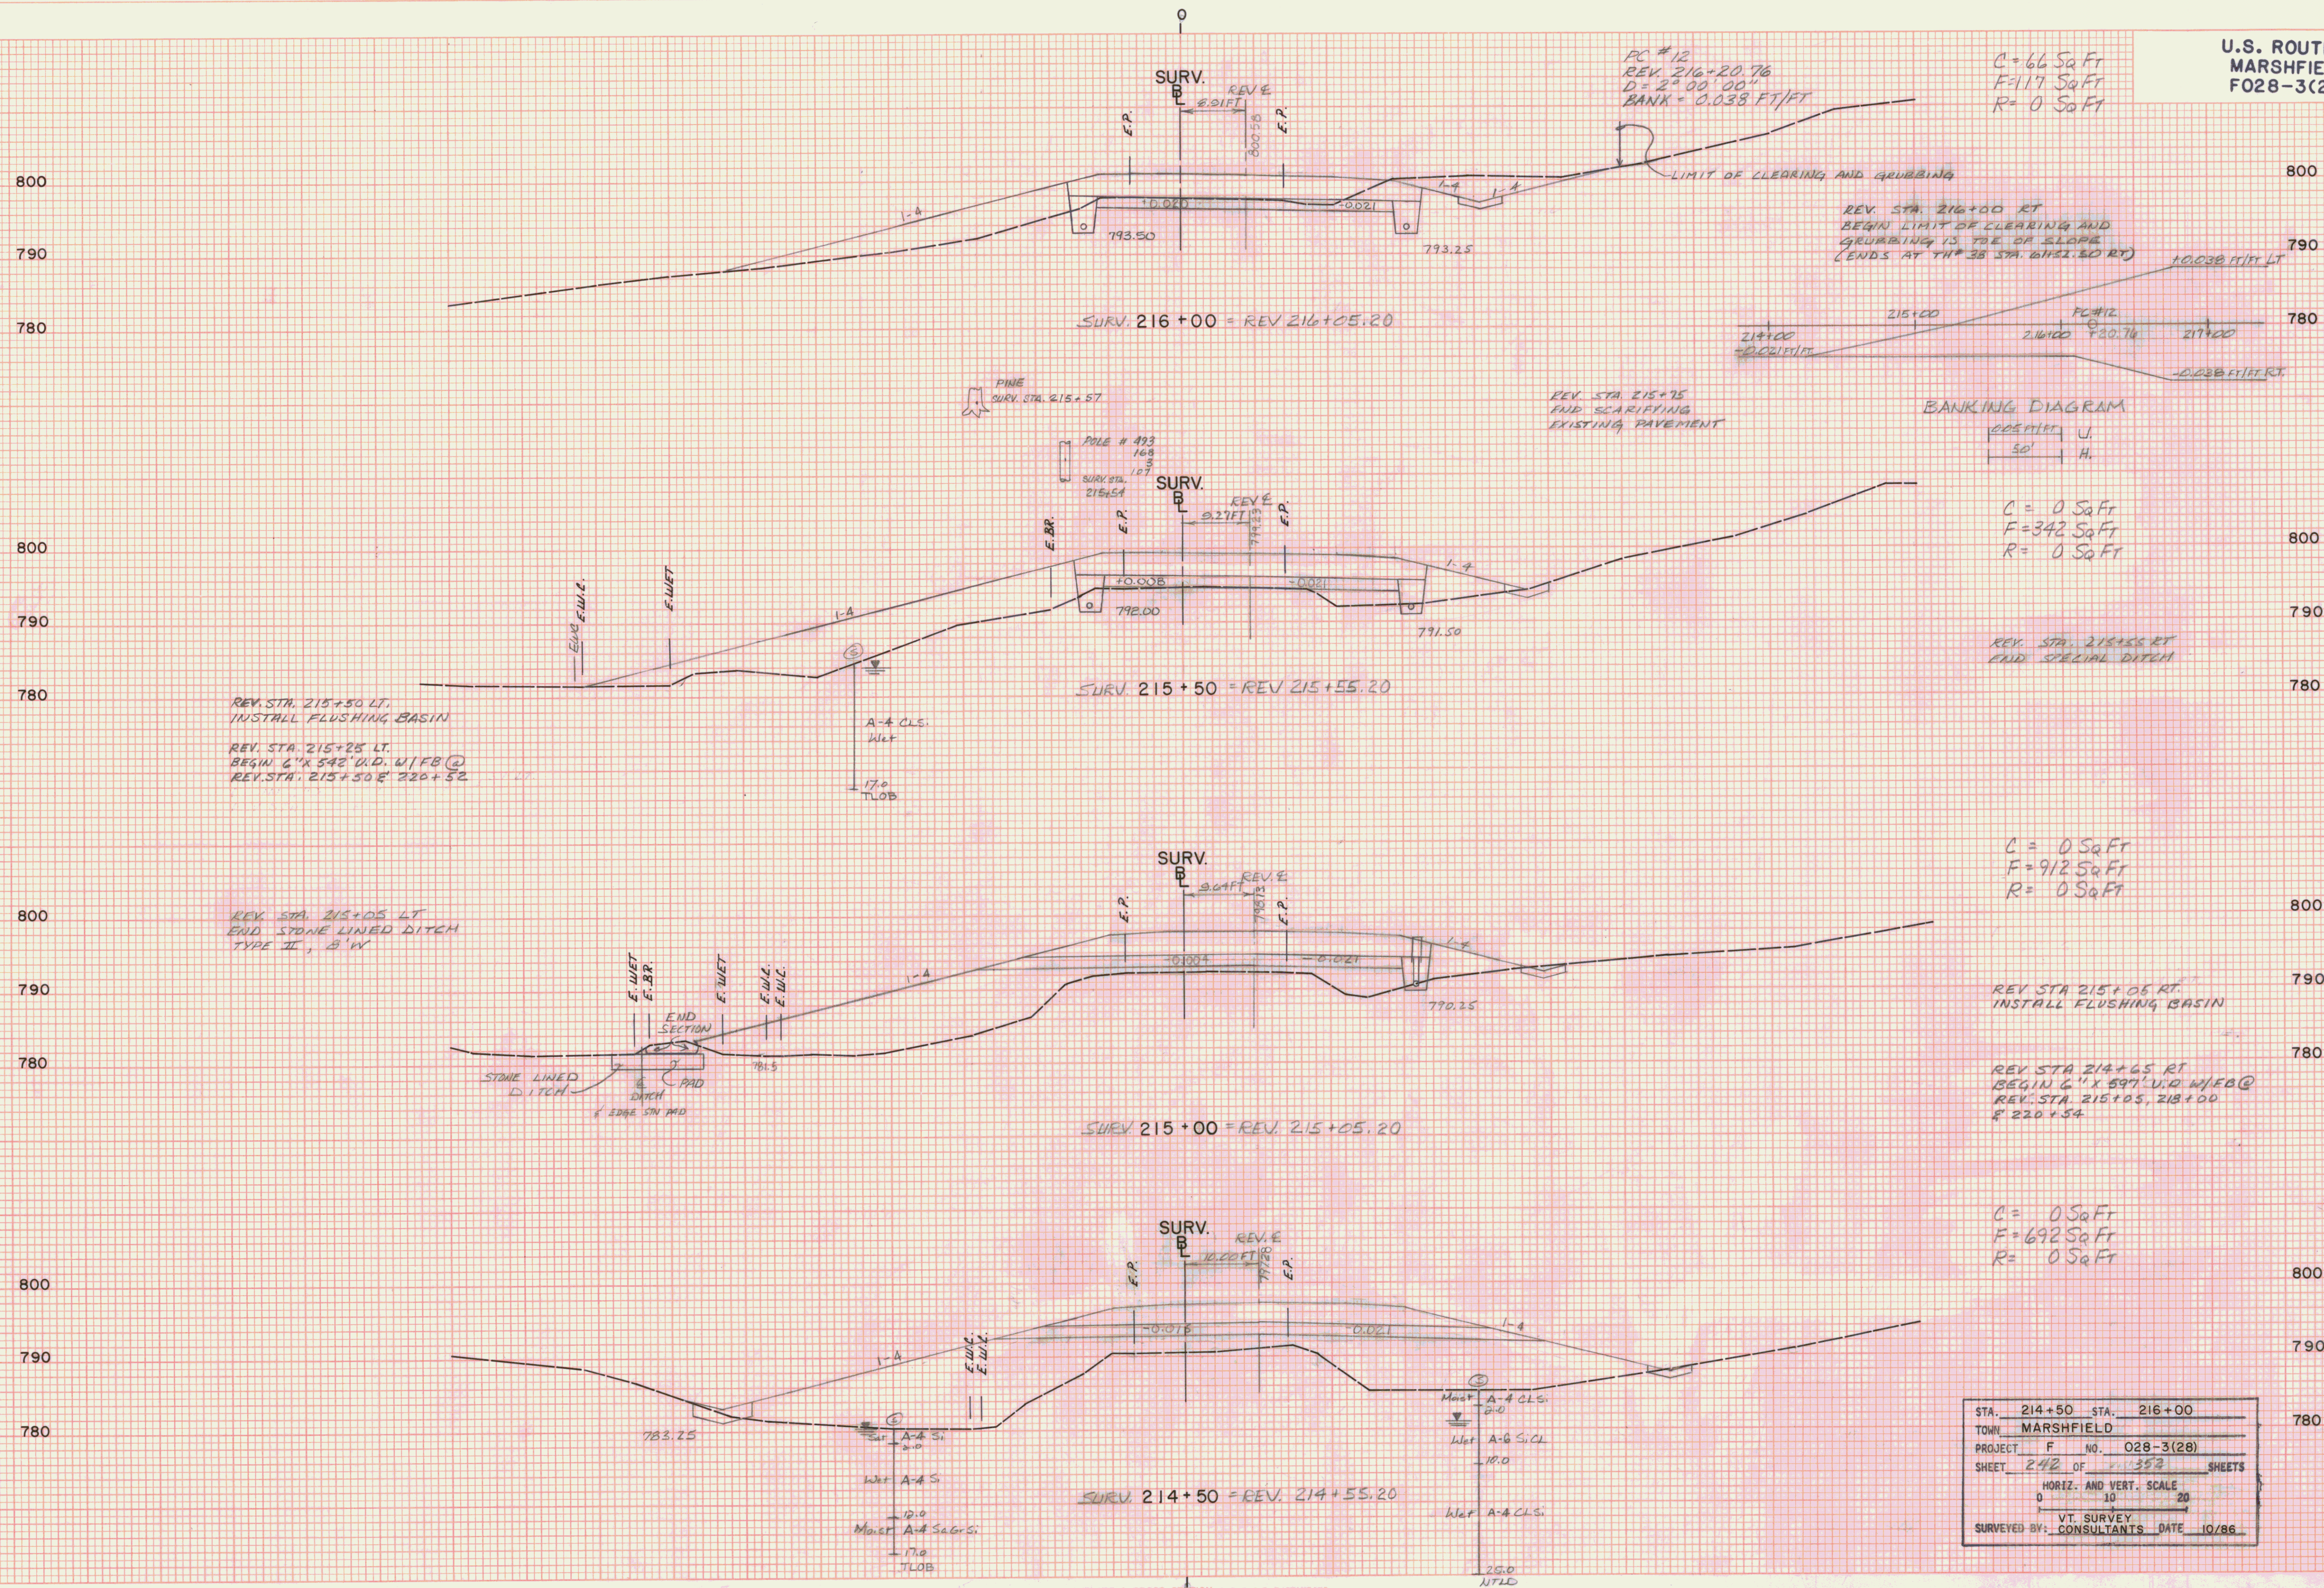


PLATE 3 CROSS SECTION O. P. R. & R. E. STANDARD
DETZEN CORPORATION