


TH #23 REAVER MEADOWS ROAD
E.P.O.T. 248+58.57, 20' LT
BEGIN APPROACH CONSTRUCTION

U.S. ROUTE 2
MARSHFIELD
FO28-3(28)

C = 39 Sq Ft
F = 42 Sq Ft
R = 0.5 Sq Ft

@ STA 248+50 RT.
BEGIN STL BEAM GUARD RAIL
@ STA 248+25 ~ 248+50 RT.
BEGIN BREAKAWAY CABLE
TERMINAL

C = 68 Sq Ft
F = 23 Sq Ft
R = 0.5 Sq Ft

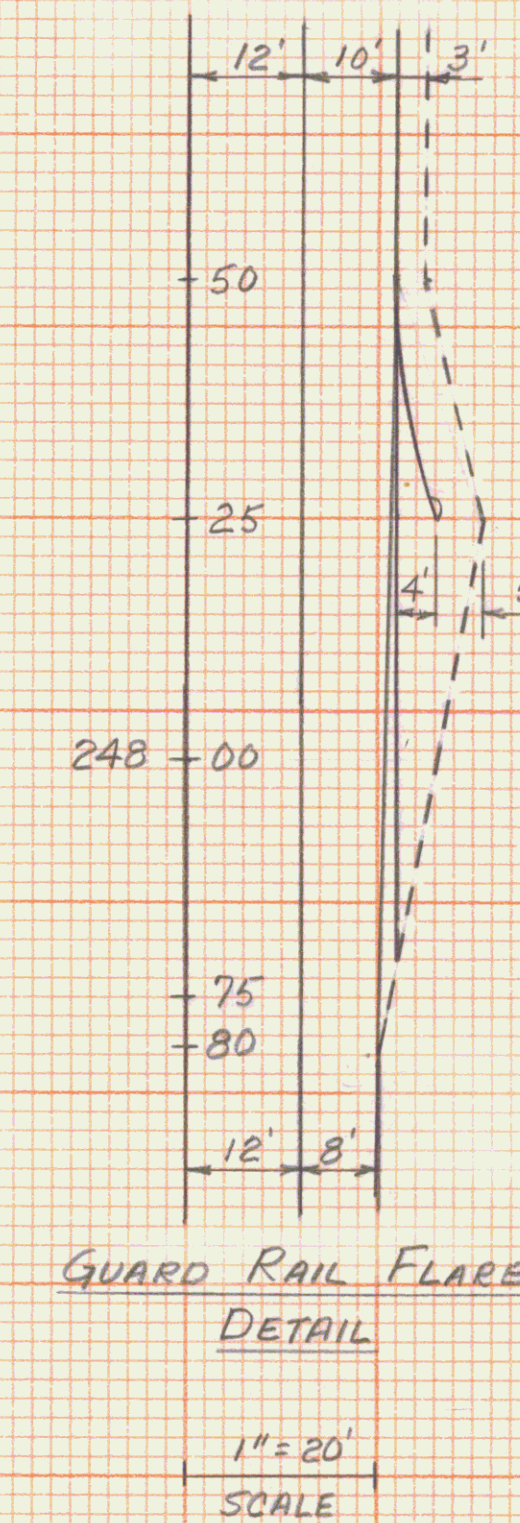

@ STA 247+51 RT.
BEGIN 6" X 237' UD W/FB @
@ STA 247+51 & 249+50
INSTALL FLUSHING BASIN

C = 141 Sq Ft
F = 9 Sq Ft
R = 0.5 Sq Ft

@ STA 247+50 RT.
END 6" X 398' UD W/FB @
REV STA 244+00 @ @ STA 247+00
INSTALL FLUSHING BASIN

C = 170 Sq Ft
F = 12 Sq Ft
R = 0.5 Sq Ft

LIMIT OF CLEARING AND GRUBBING (TYP)
(E 42' MIN LT AND/OR RT)

STA. 247+00	STA. 248+50
TOWN	MARSHFIELD
PROJECT	F NO. 028-3(28)
SHEET	264 OF 352 SHEETS
HORIZ. AND VERT. SCALE	
0 10 20	
VT. SURVEY CONSULTANTS DATE 10/86	

SCALE: 1" = 10'
H & V