


|             |  |
|-------------|--|
| DATE        |  |
| BY          |  |
| REVIEWED    |  |
| PLANNED     |  |
| DESIGNED    |  |
| CONSTRUCTED |  |
| MAINTAINED  |  |
| NO.         |  |

|             |                    |
|-------------|--------------------|
| DATE        | 10-86              |
| BY          | VI. SURVEY CONSULT |
| REVIEWED    |                    |
| PLANNED     |                    |
| DESIGNED    |                    |
| CONSTRUCTED |                    |
| MAINTAINED  |                    |
| NO.         |                    |

790  
780  
770  
790  
780  
770  
STA 251+06 LT  
END REMOVAL & DISPOSAL  
OF GUARD RAIL

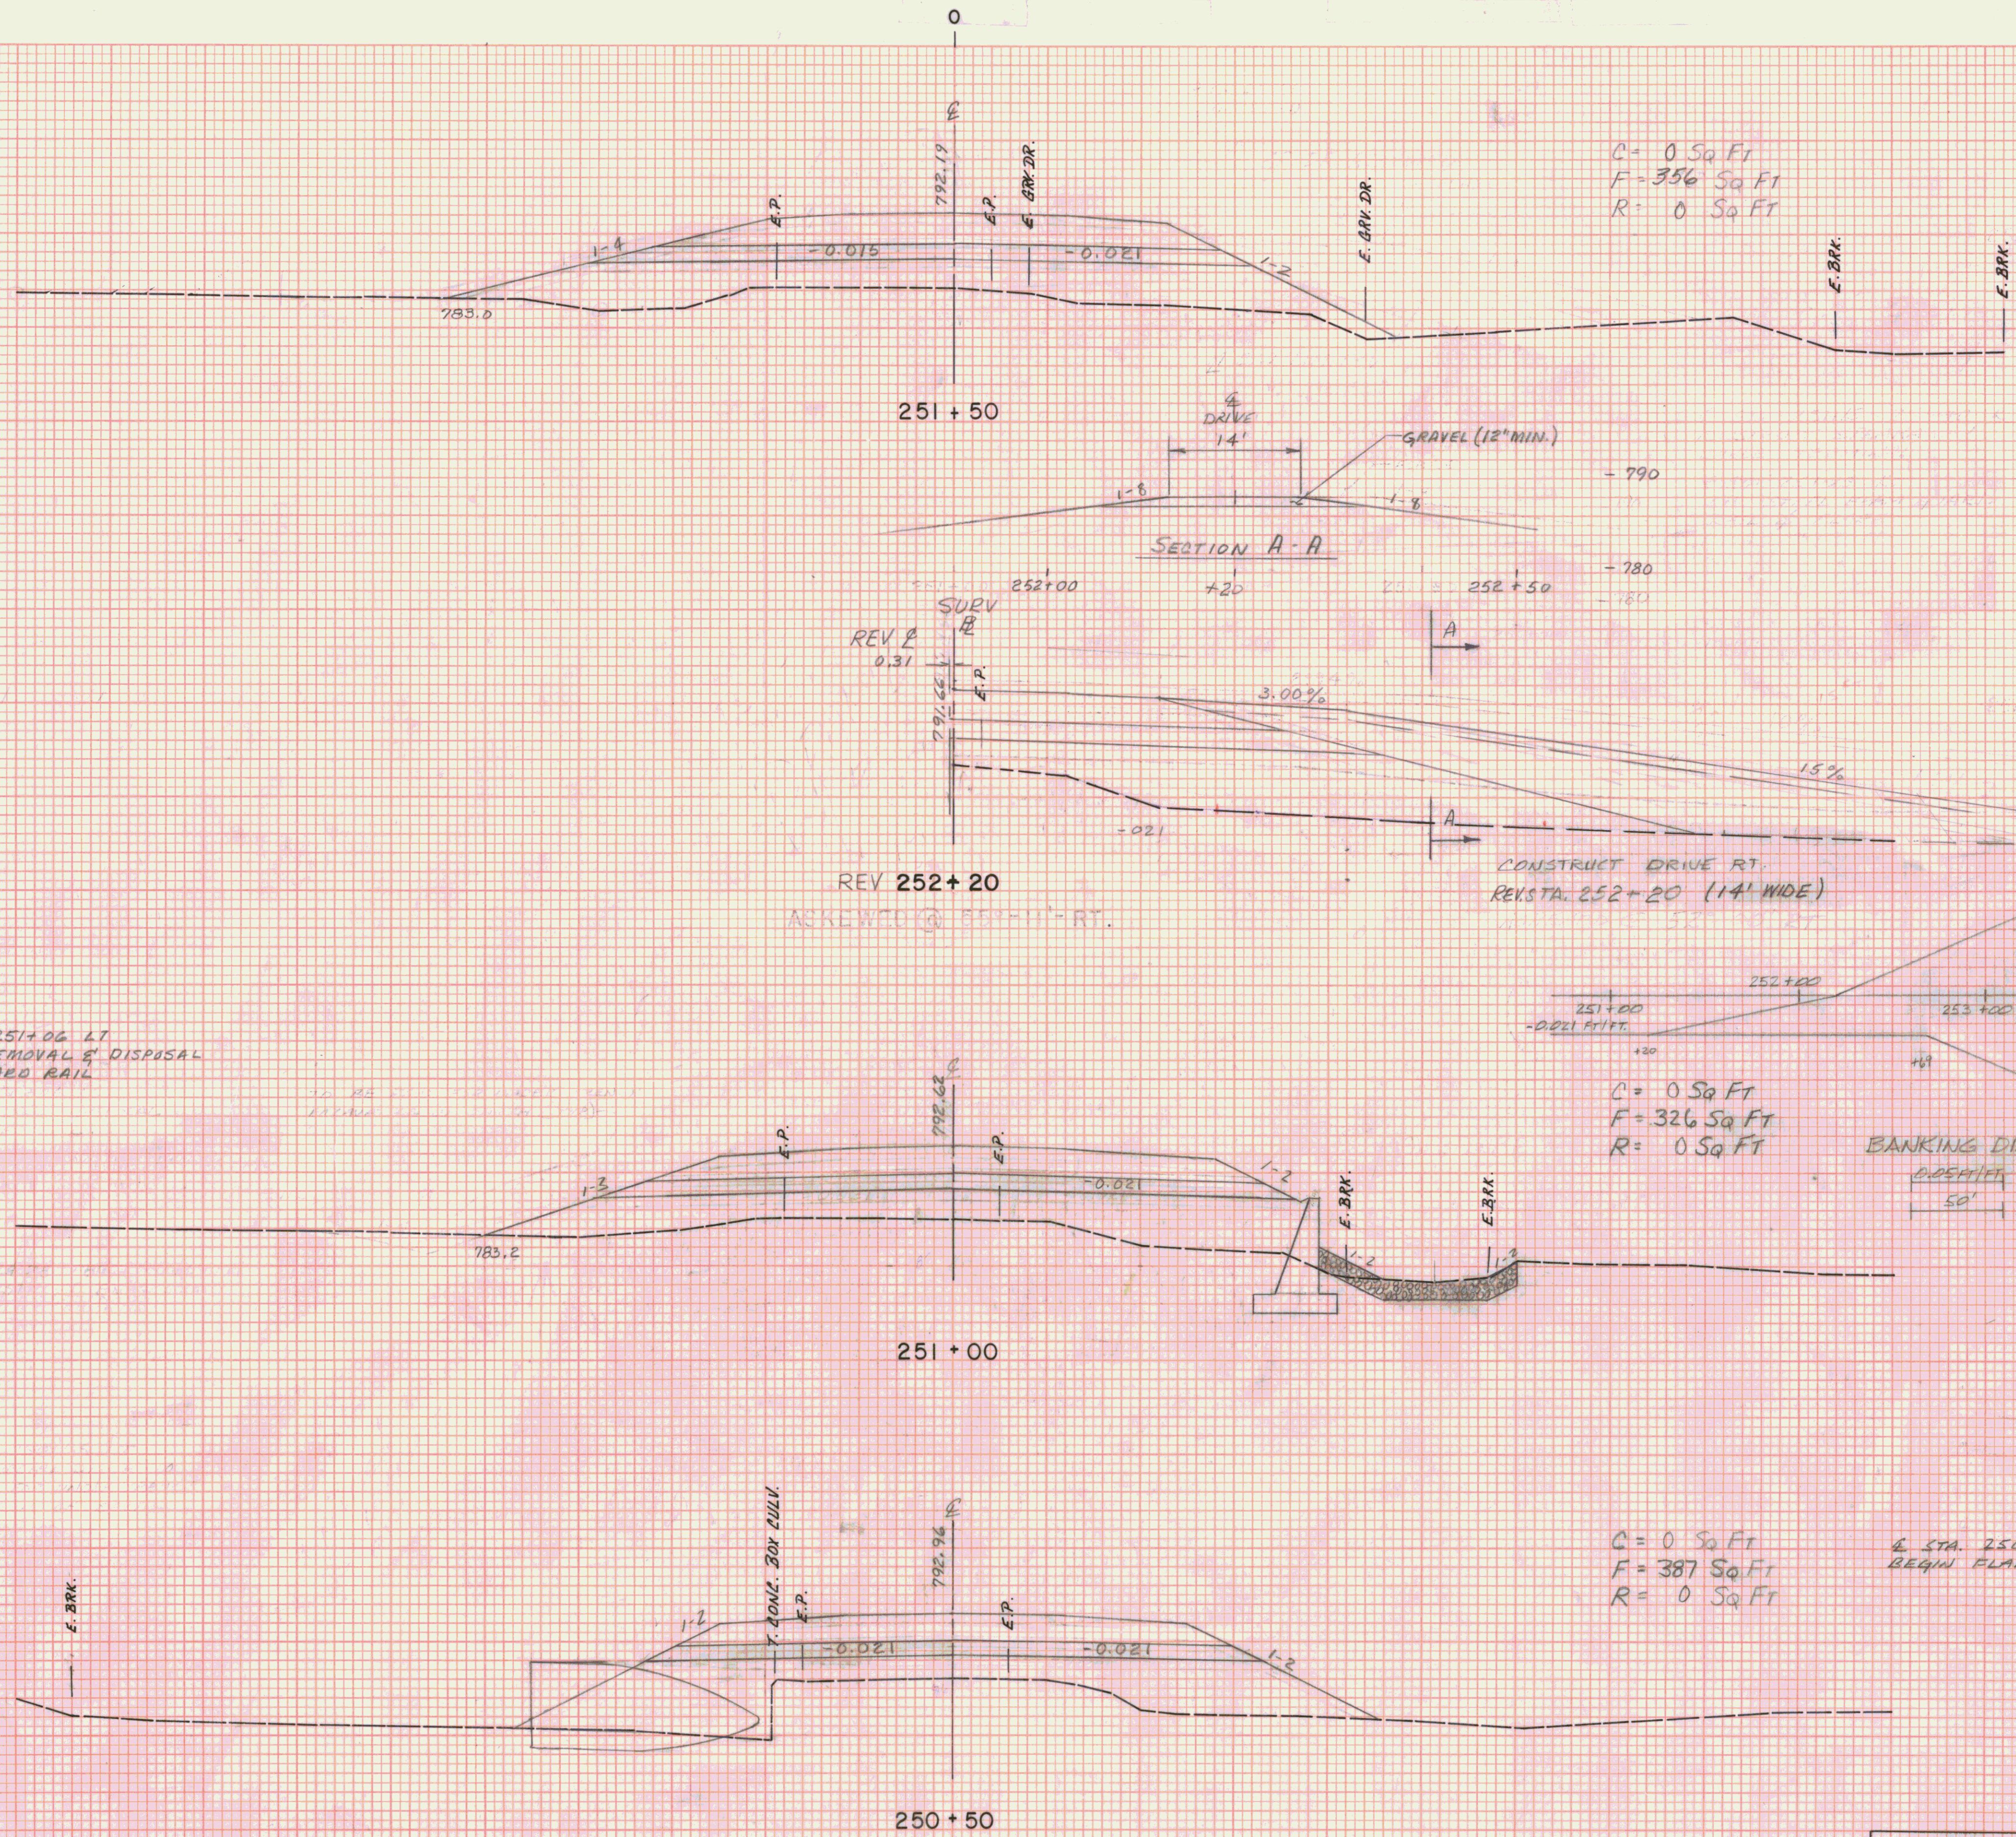

C = 0 Sq Ft  
F = 356 Sq Ft  
R = 0 Sq Ft

C = 0 Sq Ft  
F = 326 Sq Ft  
R = 0 Sq Ft

C = 0 Sq Ft  
F = 387 Sq Ft  
R = 0 Sq Ft

BANKING DIAGRAM  
0.02% V.  
50' H.

STA 251+14 RT  
END REMOVAL & DISPOSAL  
OF GUARD RAIL

STA 250+65 RT  
BEGIN FLARE

|                                     |                 |     |            |
|-------------------------------------|-----------------|-----|------------|
| STA                                 | 250+50          | STA | 251+50     |
| TOWN                                | MARSHFIELD      |     |            |
| PROJECT                             | F NO. 028-3(28) |     |            |
| SHEET                               | 210             | OF  | 218 SHEETS |
| HORIZ AND VERT. SCALE               |                 |     |            |
| 0 10 20                             |                 |     |            |
| VT. SURVEY                          |                 |     |            |
| SURVEYED BY: CONSULTANTS DATE 10/86 |                 |     |            |