


FINAL SURVEY NOTE BOOK No.	BY	DATE	SURVEYED PLOTED AREA	AREA CHECKED

4 STA. 250+08 ASKEWED 66°-00' RT.
NEW 98' X 15'-6" X 9'-5" CMPPA (0.109)
W/ CRADLE HEADWALL @ INLET AND
OUTLET, STRUCTURAL STEEL BAFFLES @
INVERT SPACED ACCORDING TO LAYOUT AND
FILLED 2' DEPTH OF NATURAL STREAMBED
MATERIAL. SEE BR-130 PI AND DETAIL
SHEETS.

4 STA. 250+57,
EXISTING 8'x4' BOX CULVERT
(TO BE REMOVED)

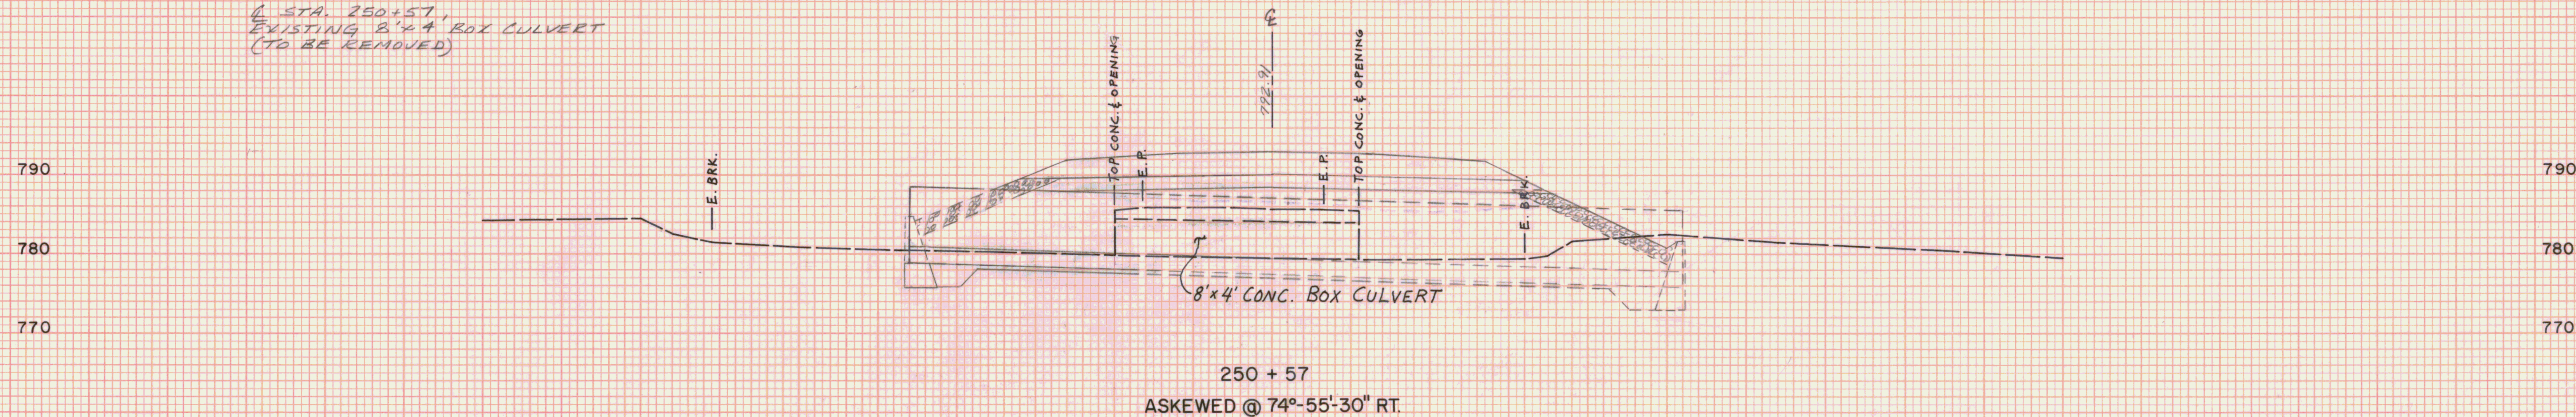

ORIGINAL SURVEY NOTE BOOK No.	BY	DATE	SURVEYED PLOTED AREA	AREA CHECKED

VT. SURVEY CONSULTANTS
BRYANT ASSOC.
12/86
1/87

STA. 250+57	STA. 251+20
TOWN MARSHFIELD	
PROJECT F	NO. 028-3(28)
SHEET 266A OF 413	SHEETS
HORIZ. AND VERT. SCALE 0 10 20	
VT. SURVEY CONSULTANTS DATE 10/86	