


C = 0 Sq Ft
F = 350 Sq Ft
R = 0 Sq Ft

C = 0 Sq Ft
F = 399 Sq Ft
R = 0 Sq Ft

C = 0 Sq Ft
F = 429 Sq Ft
R = 0 Sq Ft

DATE
BY
SURVEYED
PLATTED
AREA
FINAL SURVEY NOTE BOOK NO.

DATE
BY
SURVEYED
PLATTED
AREA
ORIGINAL SURVEY NOTE BOOK NO.

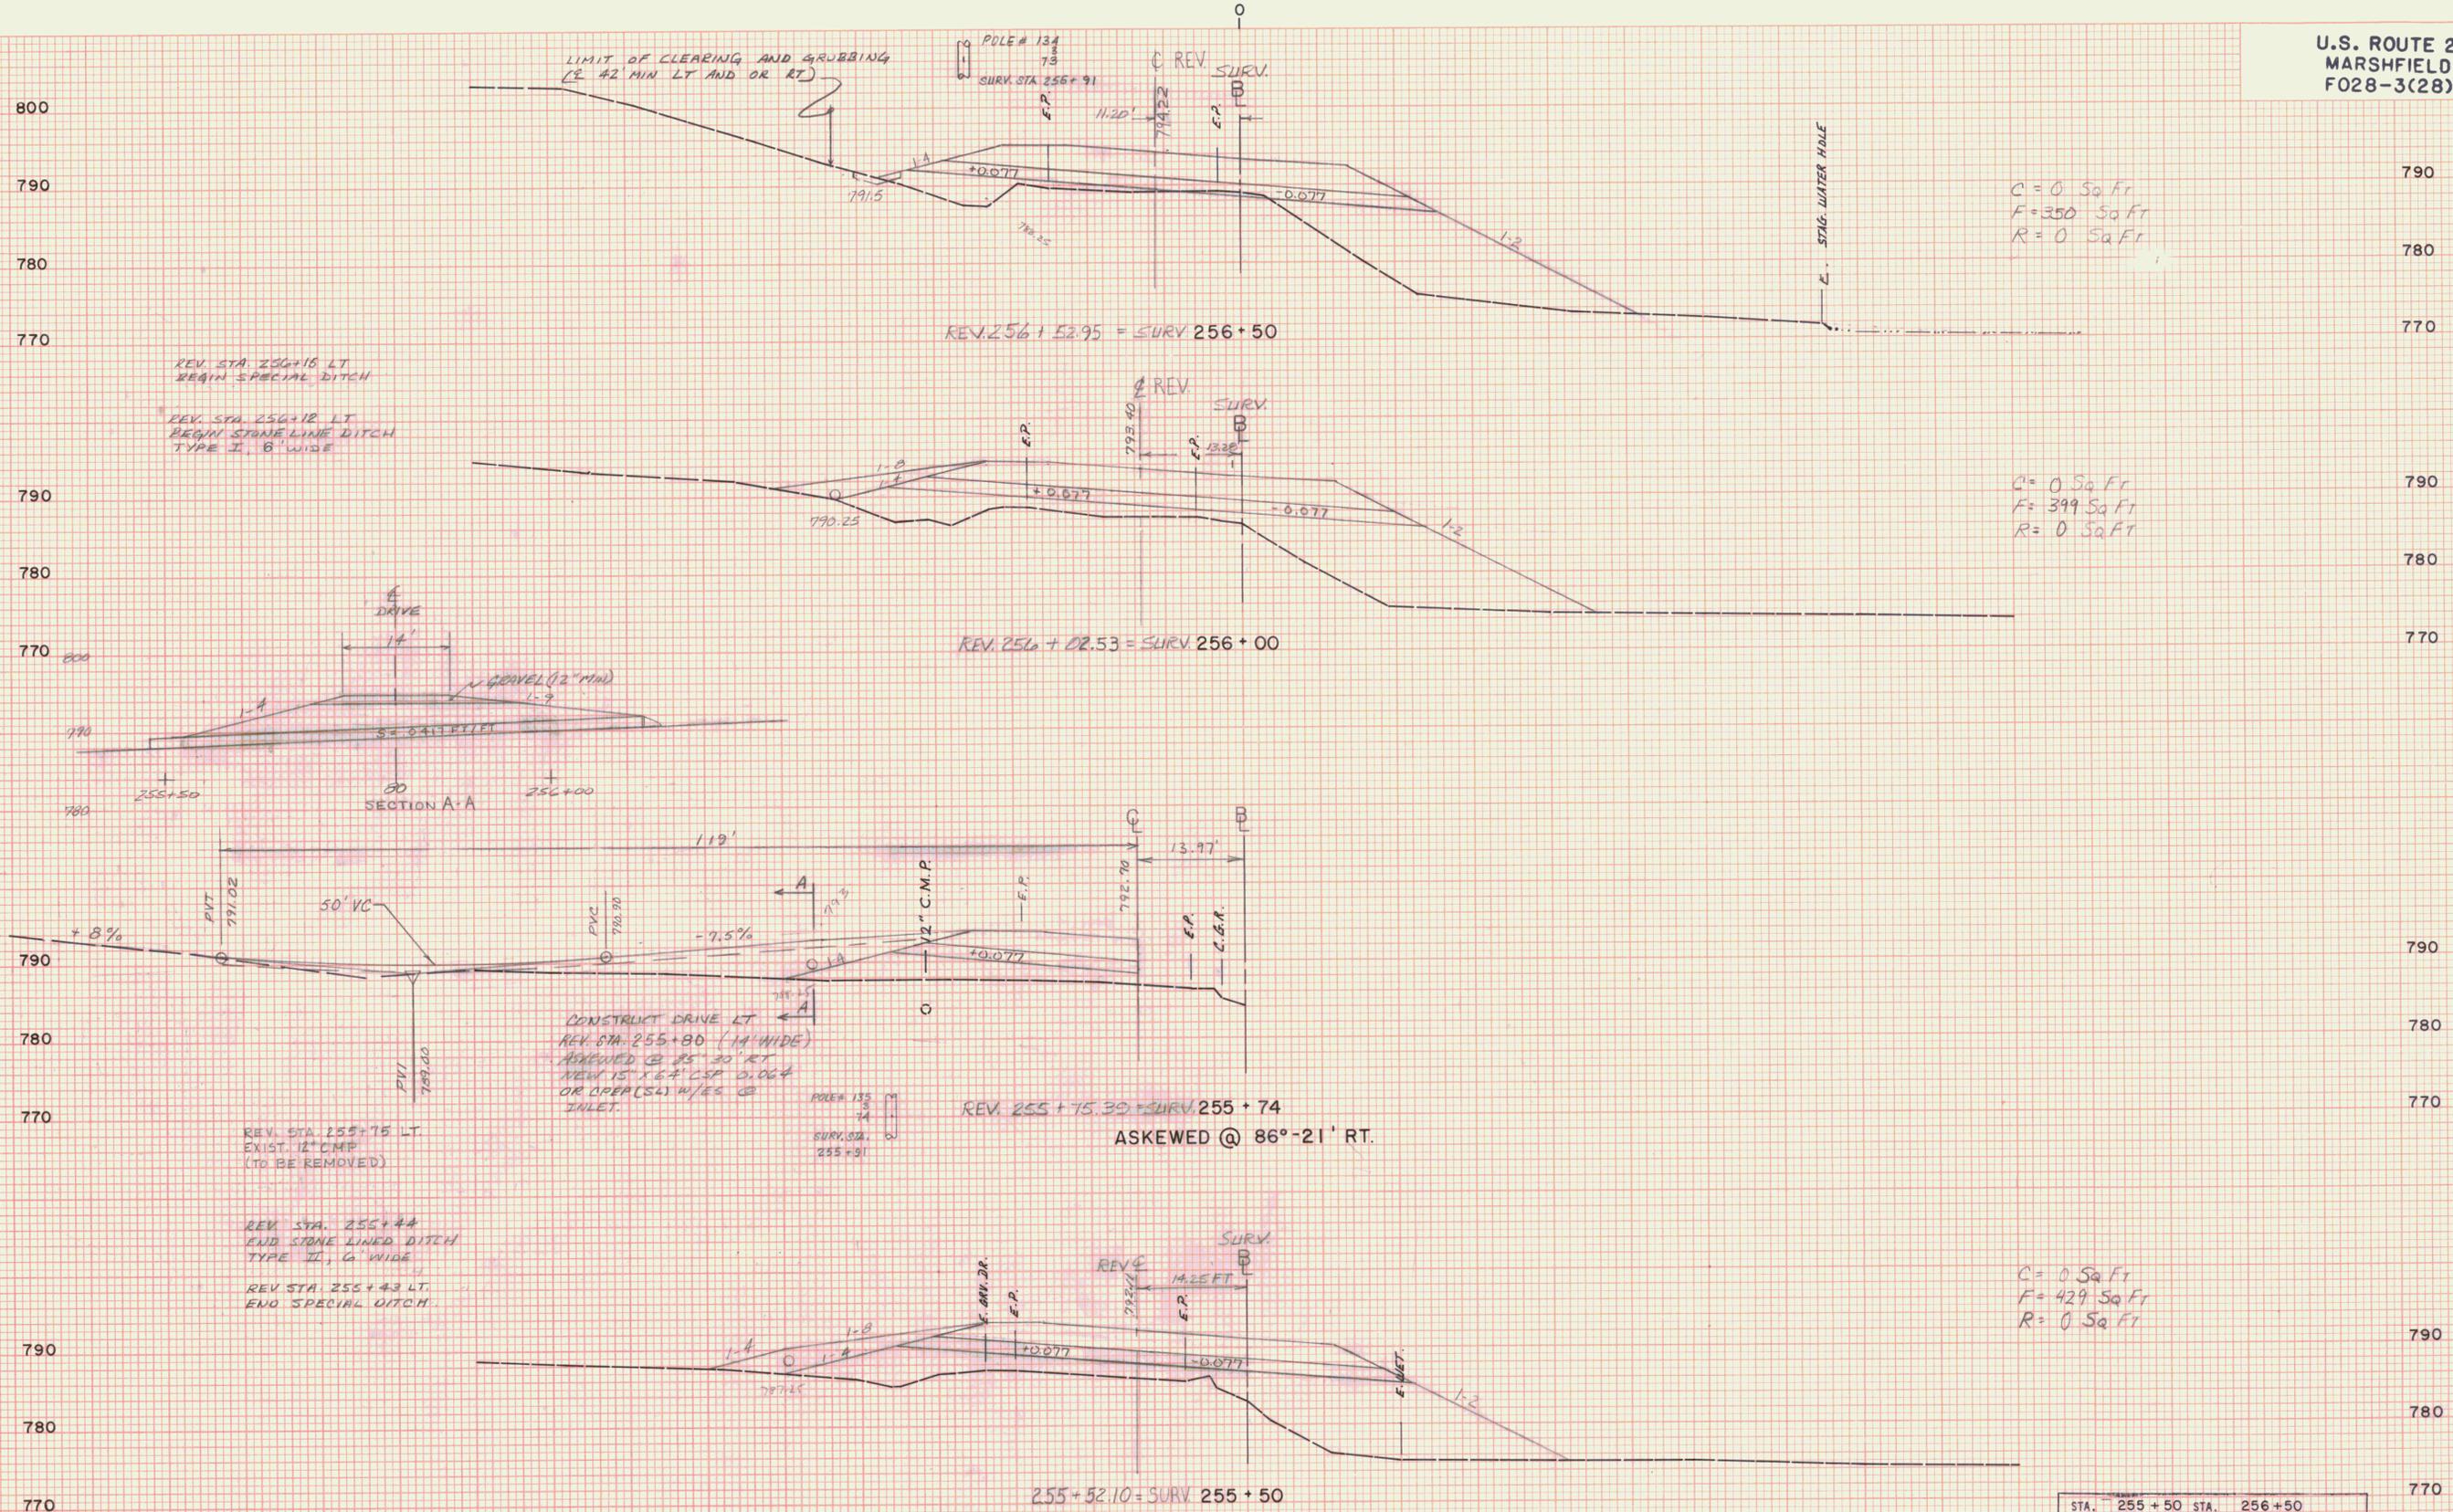

REV. STA. 256+16 LT
BEGIN SPECIAL DITCH

REV. STA. 256+12 LT
BEGIN STONE LINE DITCH
TYPE I, 6' WIDE

DRIVE
14'

GRAVEL (12" MIN)
1:4

SECTION A-A

255+50 256+00

CONSTRUCT DRIVE LT
REV. STA. 255+80 (14' WIDE)
ASKEWED @ 85° 30' RT
NEW 15" x 6" CSP D. OG 4
OR OPER (S4) W/ES @
INLET.

REV. STA. 255+75 LT
EXIST. 12" C.M.P.
(TO BE REMOVED)

REV. STA. 255+44
END STONE LINED DITCH
TYPE II, 6' WIDE

REV. STA. 255+43 LT
END SPECIAL DITCH

REV. 256+52.95 = SURV 256+50

REV. 256+02.53 = SURV 256+00

REV. 255+75.39 = SURV 255+74
ASKEWED @ 86°-21' RT.

255+52.10 = SURV 255+50

STA.	255+50	STA.	256+50
TOWN	MARSHFIELD		
PROJECT	F	NO.	028-3(28)
SHEET	270	OF	350
SHEETS			
HORIZ. AND VERT. SCALE			
0 10 20			
VT. SURVEY			
SURVEYED BY: CONSULTANTS DATE 10/86			