

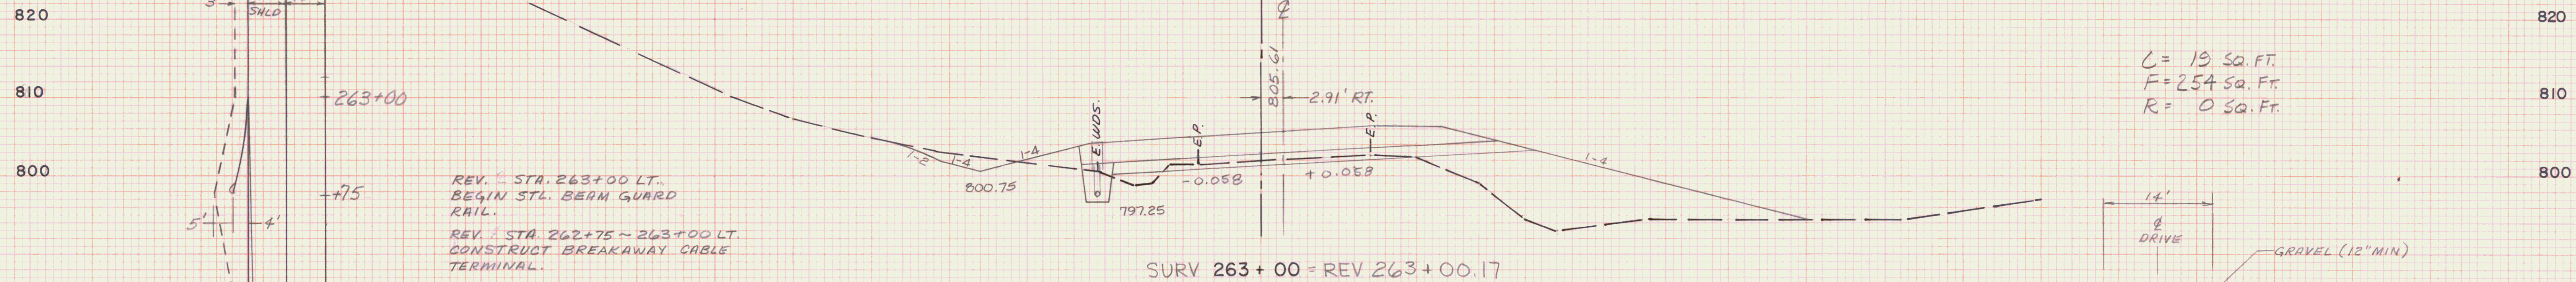
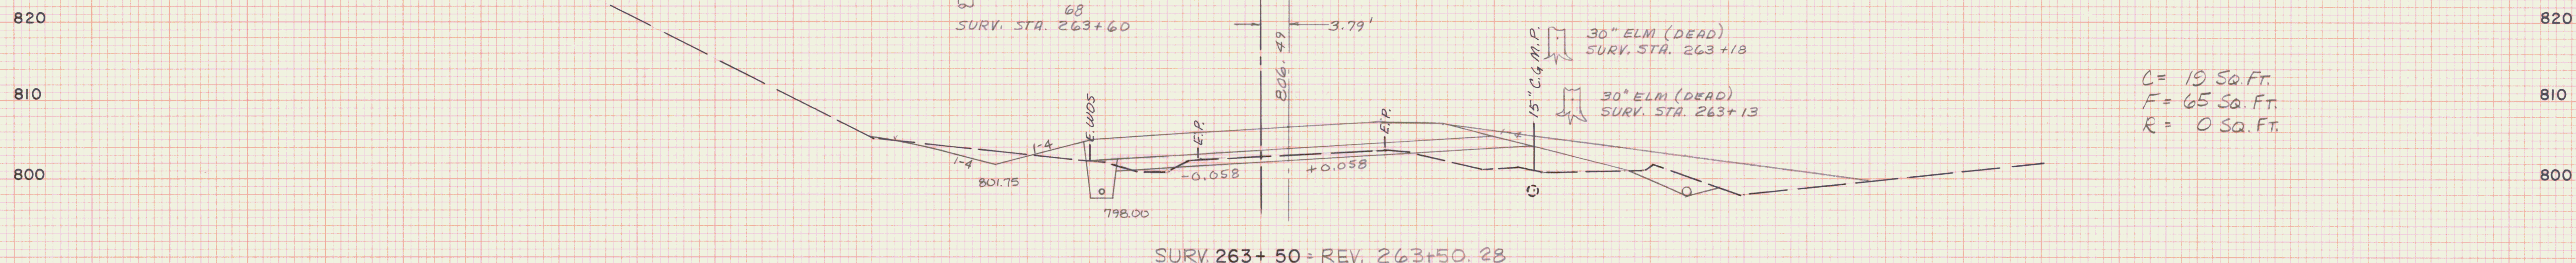


DATE	
BY	
SURVEYED	
NOTED	
TEMPLATE	
AREAS	
CHECKED	
NO.	

DATE	
BY	
SURVEYED	
NOTED	
TEMPLATE	
AREAS	
CHECKED	
NO.	

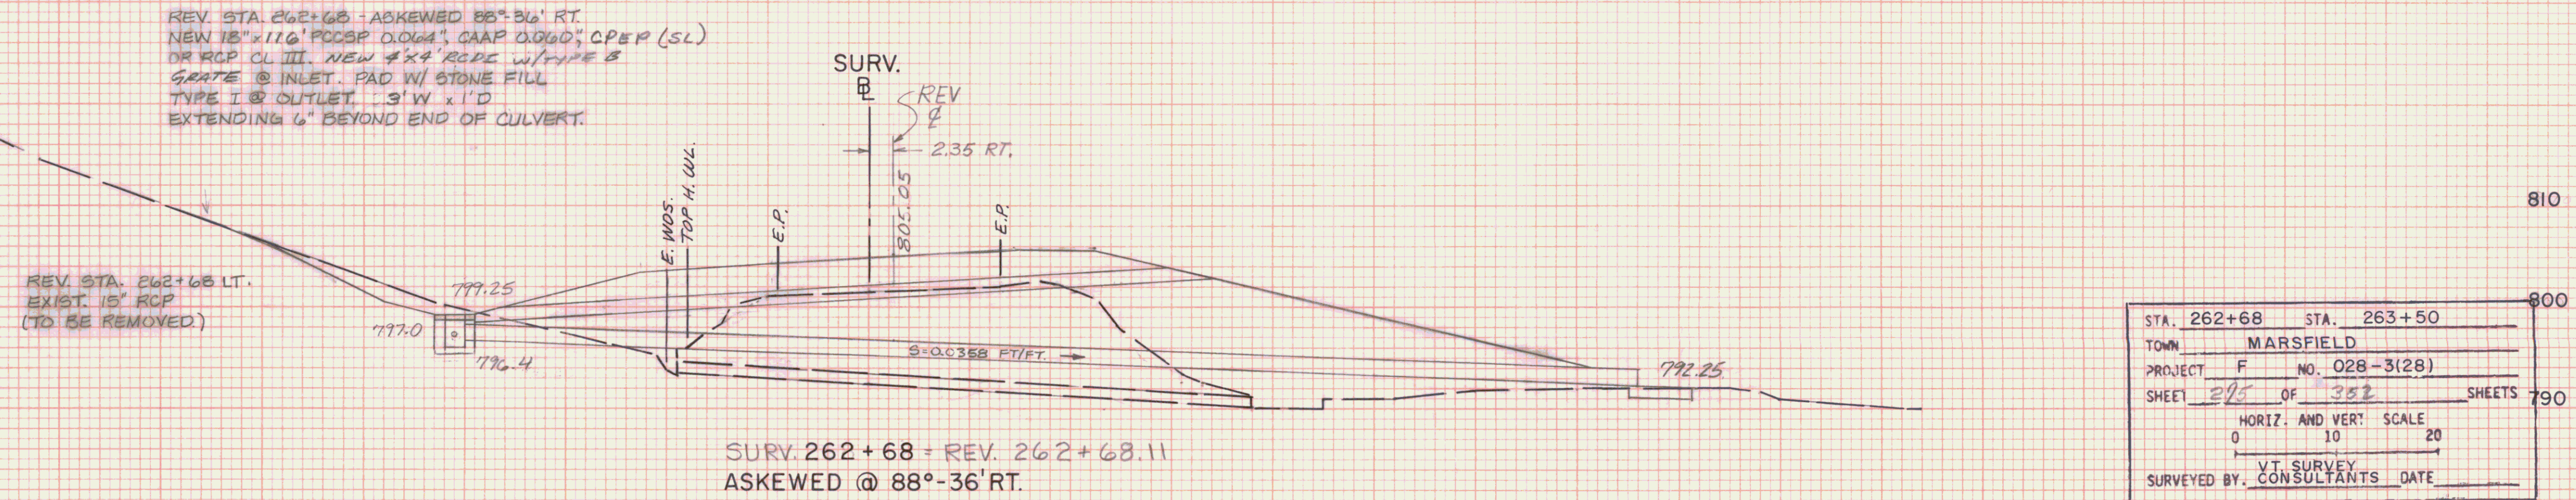

GUARD RAIL FLARE DETAIL
SCALE 1"=20'

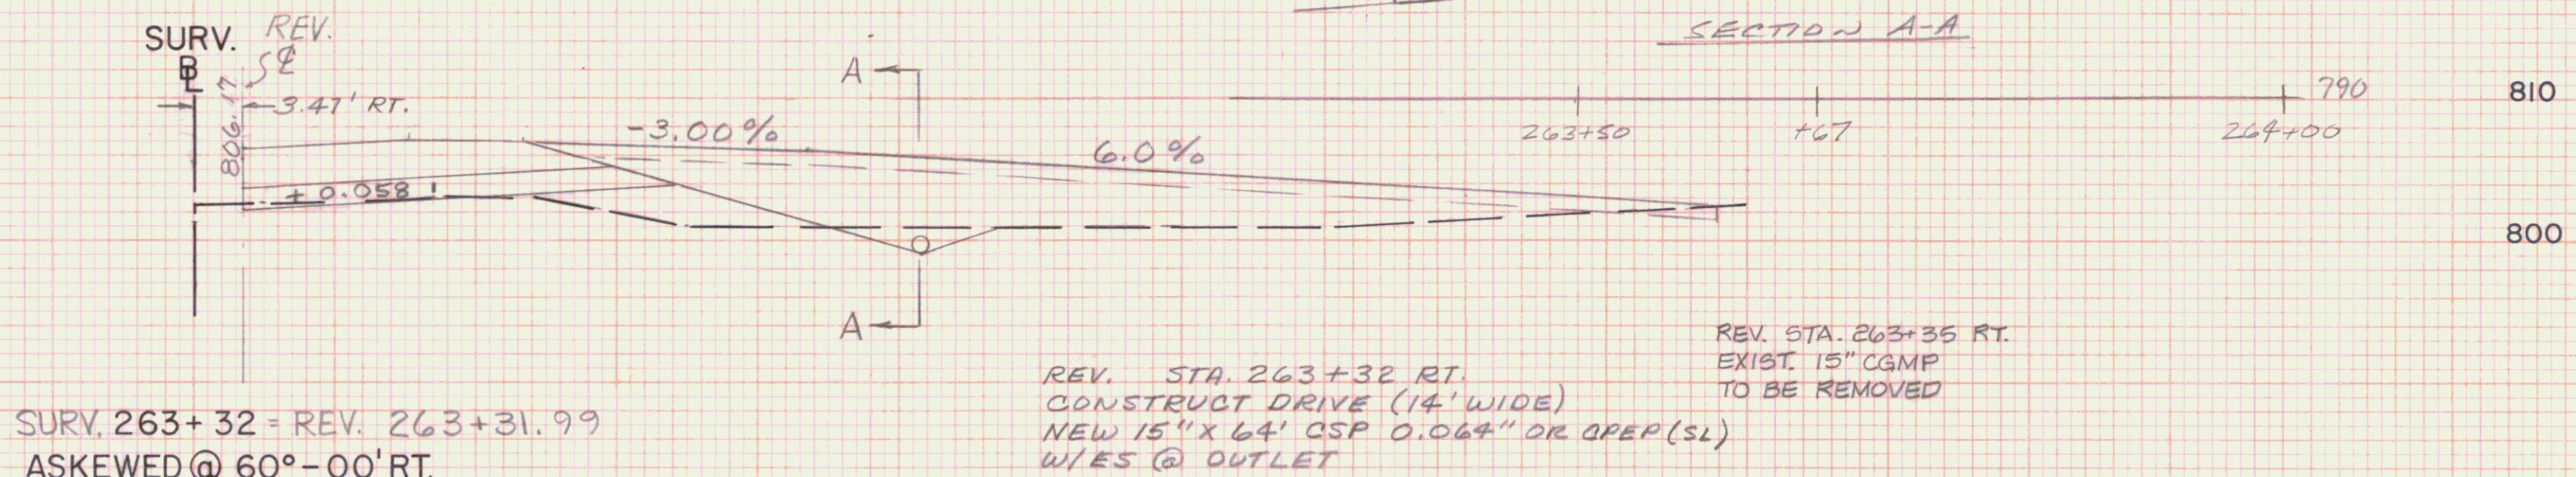

STA. 262+68	STA. 263+50
TOWN	MARSFIELD
PROJECT	F NO. 028-3(28)
SHEET	205 OF 352 SHEETS
HORIZ. AND VERT. SCALE	10 20
SURVEYED BY.	VT. SURVEY CONSULTANTS DATE