

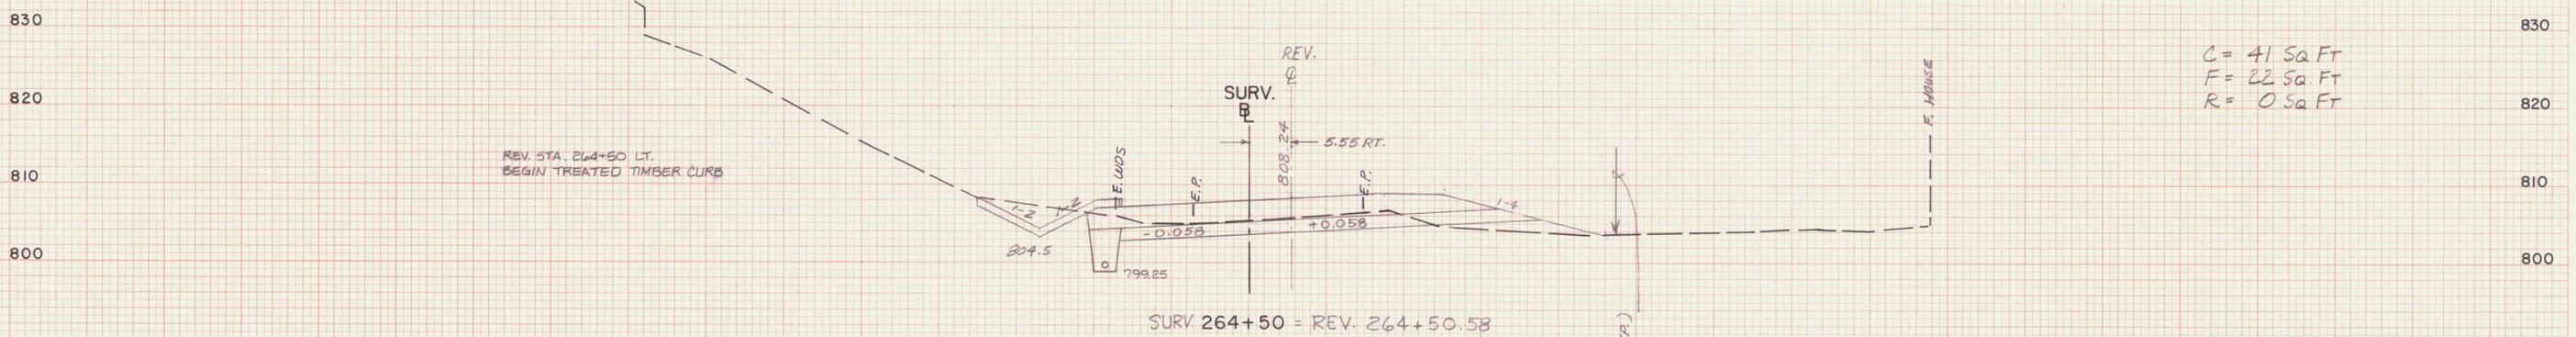
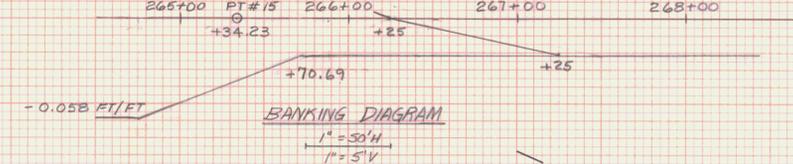


PT # 15
STA. 265+34.23
D=3°30'00"
BANK=0.058 FT/FT

C=64 Sq. Ft.
F=9 Sq. Ft.
R=0 Sq. Ft.

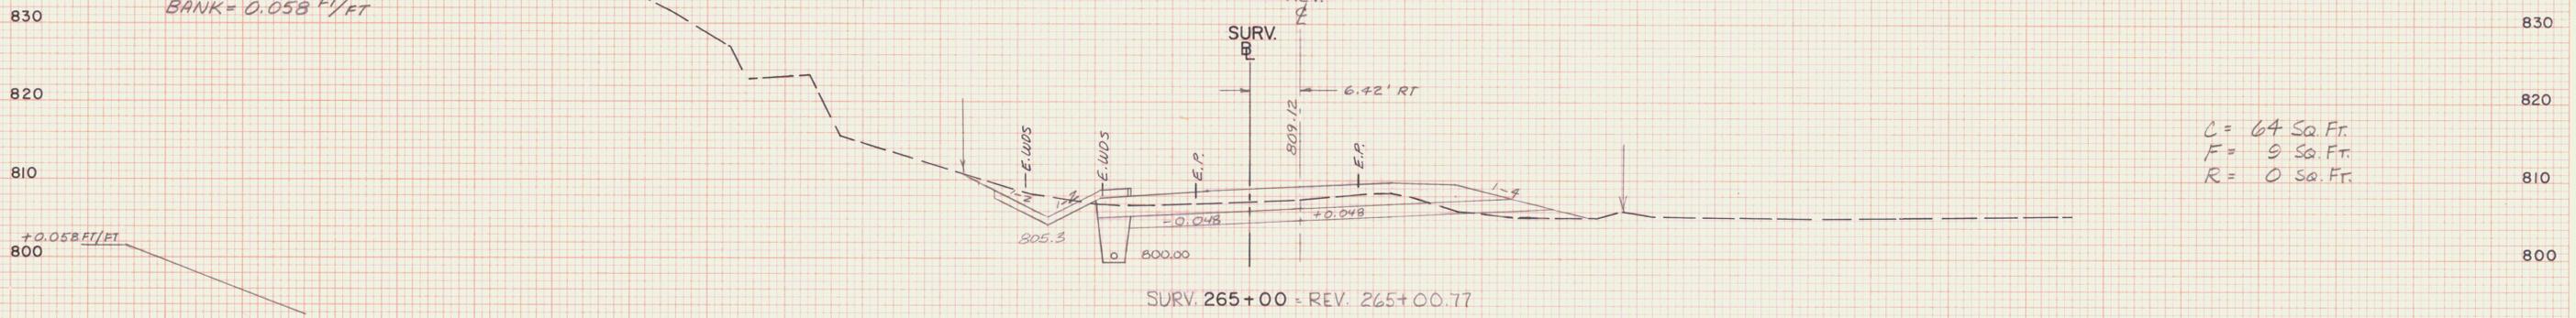

C=41 Sq. Ft.
F=22 Sq. Ft.
R=0 Sq. Ft.

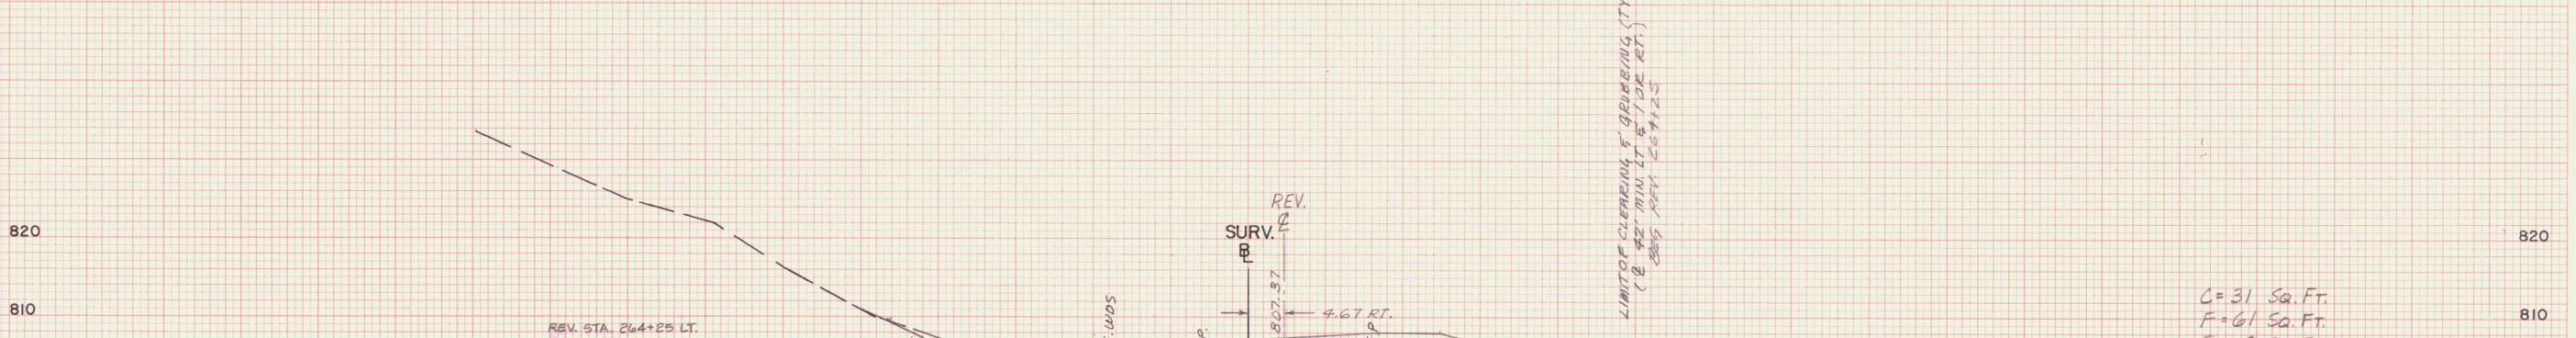

C=31 Sq. Ft.
F=61 Sq. Ft.
R=0 Sq. Ft.

STA. 264+00	STA. 265+00
TOWN	MARSHFIELD
PROJECT	F NO. 028-3(28)
SHEET	276 OF 352 SHEETS
HORIZ. AND VER. SCALE	
0 10 20	
SURVEYED BY	
VT. SURVEY CONSULTANTS	
DATE	

DATE
BY
PROJECT
NOTED
TRIP
NO. 028-3(28)
NO.

DATE
BY
PROJECT
NOTED
TRIP
NO. 028-3(28)
NO.