

FINAL SURVEY	BY	DATE	SURVEYED
			PLOTTED
NOTE BOOK	TEMPLATE		
	AREAS		
	AREAS CHECKED		
No.	No.		

ORIGINAL SURVEY	SURVEYED _____	BY	DATE
	PLOTTED _____		
	TEMPLATE _____		
	AREAS _____		
NOTE BOOK	AREAS CHECKED _____		
No.			

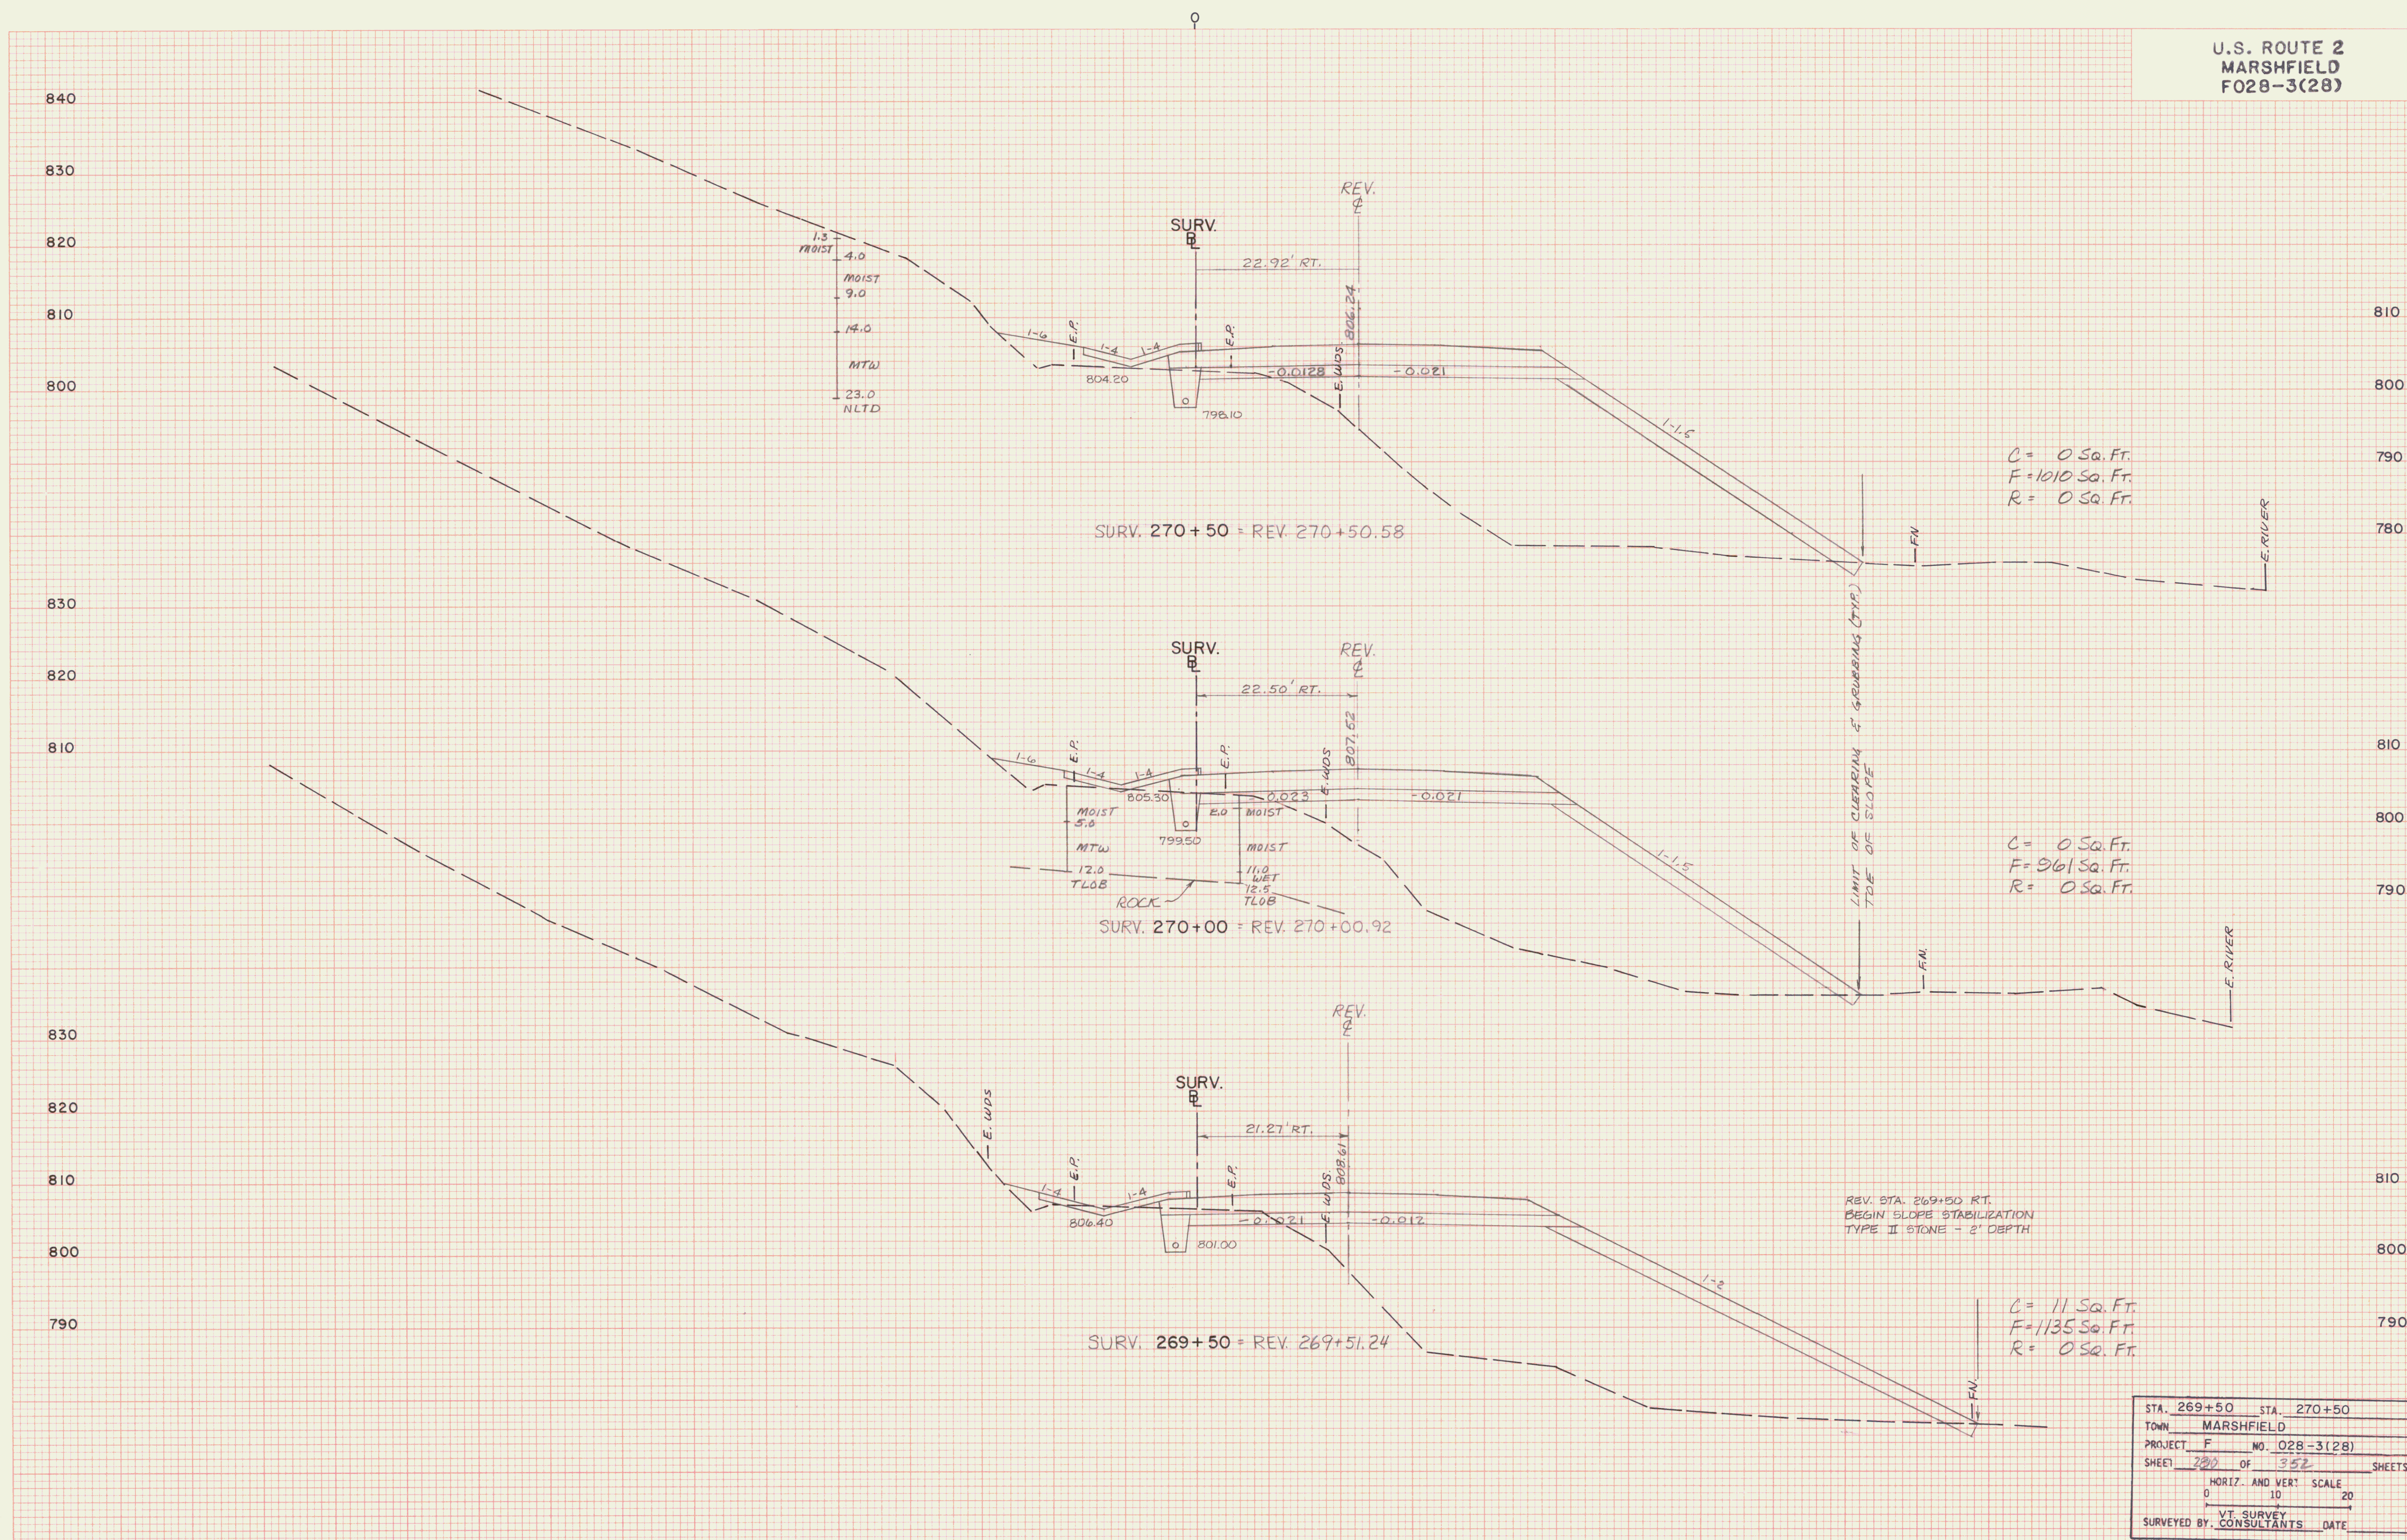


PLATE 3 CROSS SECTION O. P. R. & R. E. STANDARD
DETZEN CORPORATION

STA. 269+50 STA. 270+50
TOWN MARSHFIELD
PROJECT F MO. 028-3(28)
SHEET 280 OF 352 SHEETS
HORIZ. AND VERT SCALE
0 10 20
V.T. SURVEY
SURVEYED BY CONSULTANTS DATE