

FINAL SURVEY	DATE	
	BY	
	REVIEWED PLOTTER	
	NO. _____	

ORIGINAL SURVEY	DATE	
	BY	
	REVIEWED PLOTTER	
	NO. _____	

U.S. ROUTE 2
MARSHFIELD
FO28-3(28)

810

800

790

810

800

790

810

800

790

820

810

800

810

800

790

810

800

790

810


800

790

820

810

800

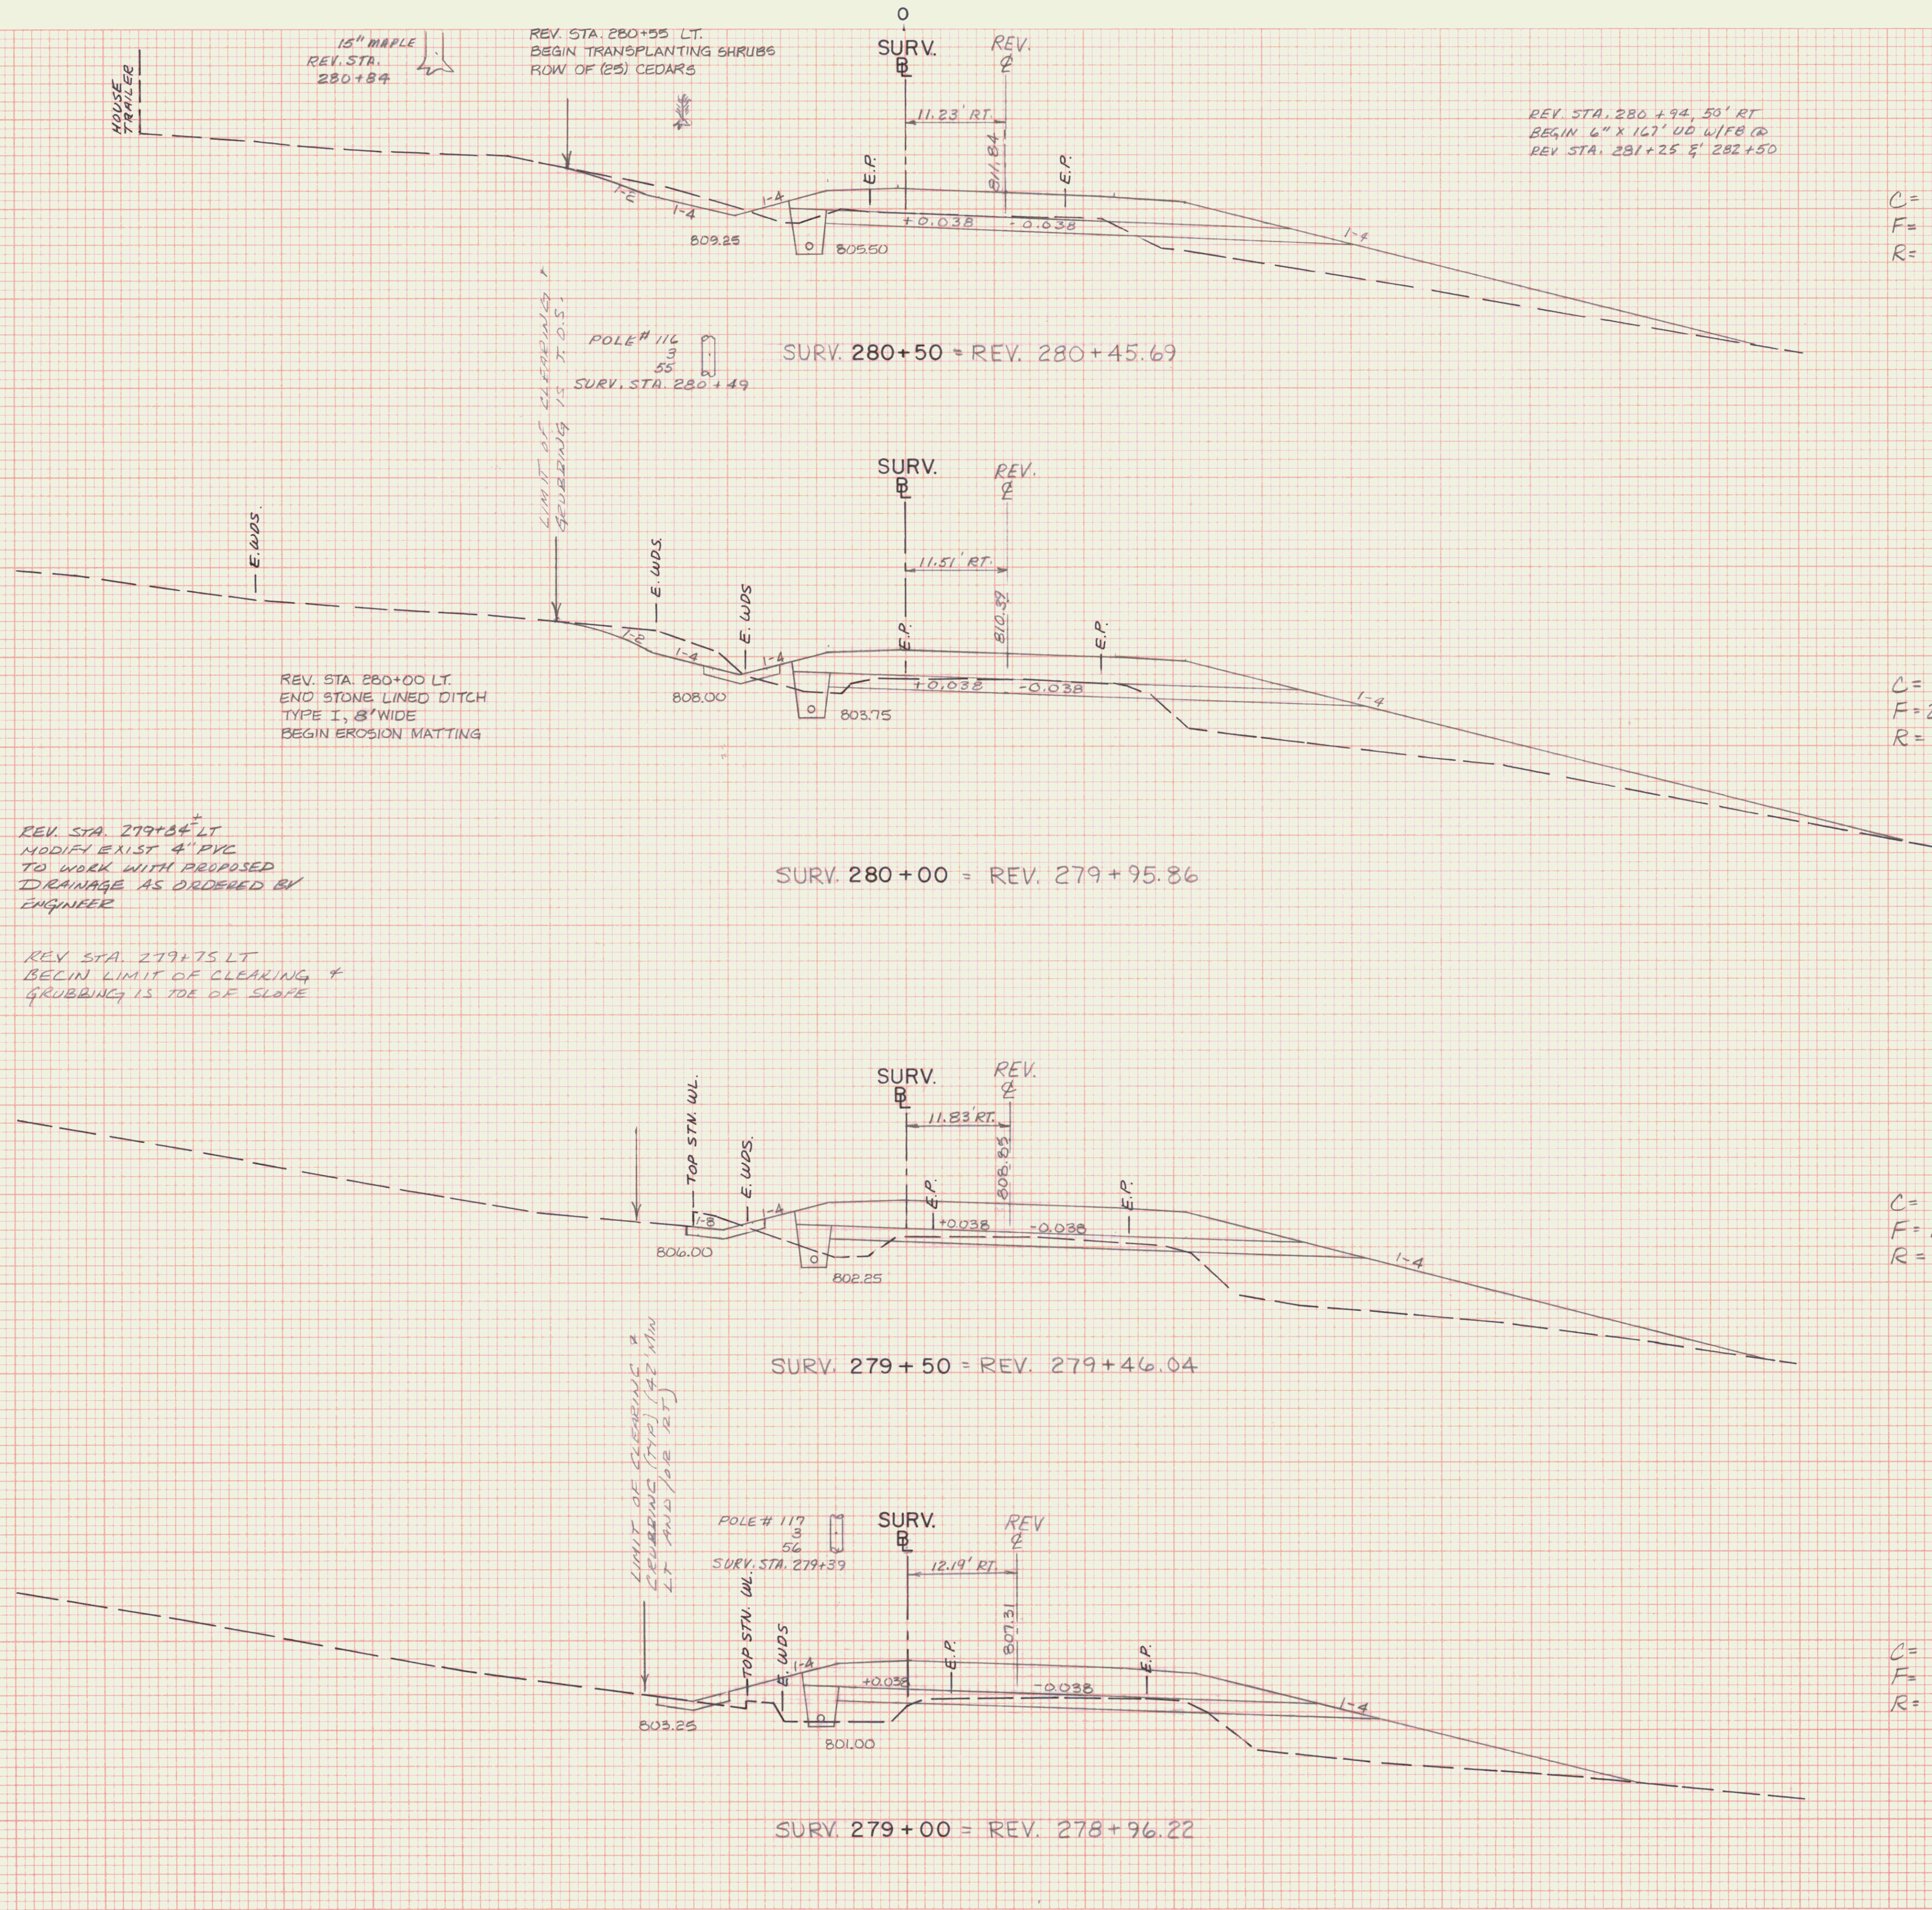

C = 25 Sq. Ft.
F = 154 Sq. Ft.
R = 0 Sq. Ft.

C = 31 Sq. Ft.
F = 226 Sq. Ft.
R = 0 Sq. Ft.

C = 5 Sq. Ft.
F = 231 Sq. Ft.
R = 0 Sq. Ft.

C = 0 Sq. Ft.
F = 191 Sq. Ft.
R = 0 Sq. Ft.

STA. 279+00	STA. 280+50
TOWN	MARSHFIELD
PROJECT	F NO. 028-3(28)
SHEET	288 OF 388 SHEETS
HORIZ. SCALE	AND VERT. SCALE
0	10 20
VT. SURVEY	
SURVEYED BY	CONSULTANT DATE