



DATE: _____ BY: _____
 NO. _____
 ORIGINAL SURVEY NOTE BOOK NO. _____
 CHECKED BY: _____


DATE: _____ BY: _____
 NO. _____
 ORIGINAL SURVEY NOTE BOOK NO. _____
 CHECKED BY: _____

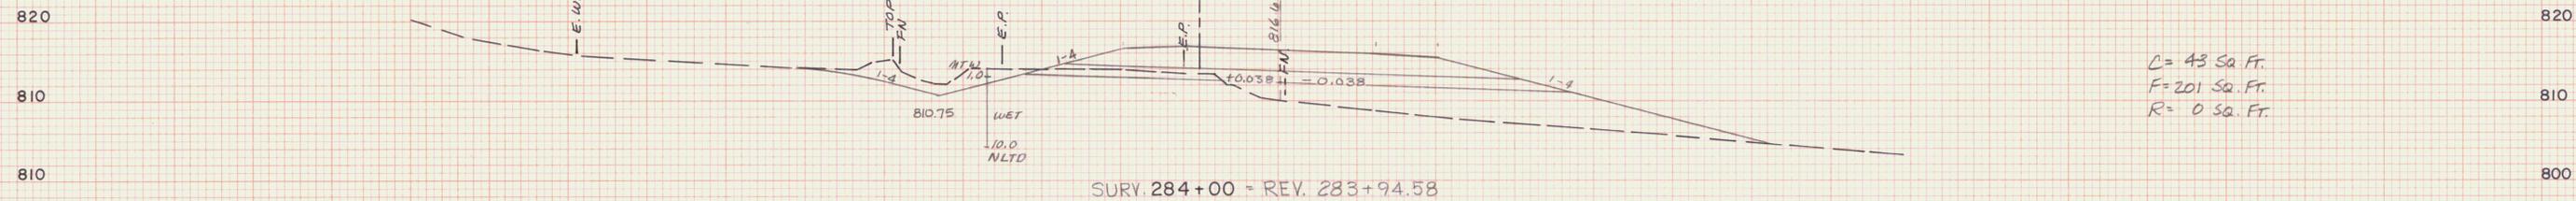


C = 43 Sq. Ft.
 F = 201 Sq. Ft.
 R = 0 Sq. Ft.

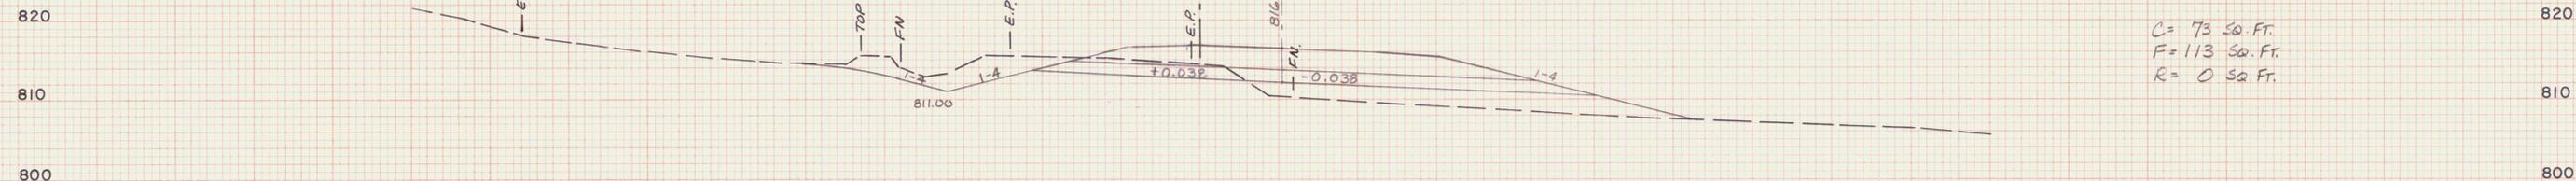

C = 73 Sq. Ft.
 F = 113 Sq. Ft.
 R = 0 Sq. Ft.

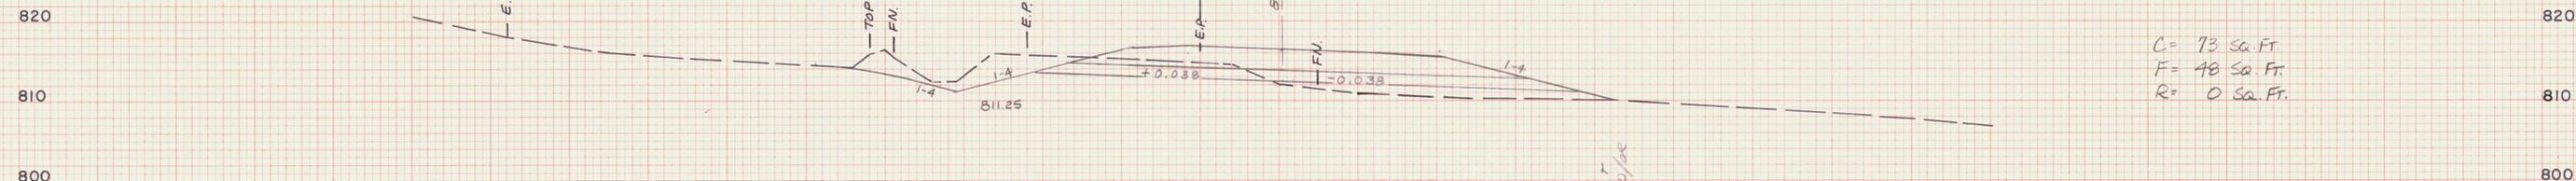

C = 73 Sq. Ft.
 F = 48 Sq. Ft.
 R = 0 Sq. Ft.

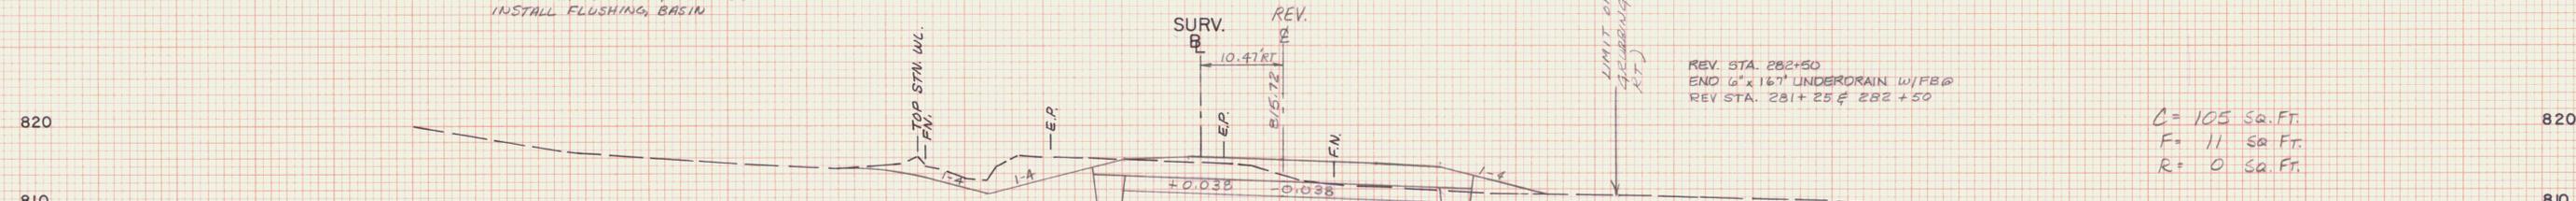

REV. STA. 282+50
 END 6" x 16" UNDERDRAIN W/FB @
 REV. STA. 281+25 & 282+50

C = 105 Sq. Ft.
 F = 11 Sq. Ft.
 R = 0 Sq. Ft.

REV. STA. 282+50 LT.
 END 6" x 453' UD W/FB @
 REV. STA. 278+44 & 282+50
 INSTALL FLUSHING BASIN

STA. 282+50	STA. 284+00
TOWN	MARSHFIELD
PROJECT	F NO. 028-3(28)
SHEET	290 OF 362 SHEETS
HORIZ. SCALE	1" = 10'
AND VER. SCALE	1" = 20'
VT. SURVEY	
SURVEYED BY: CONSULTANTS DATE	