

REV. STA. 296+25  
END SCARIFYING  
EXISTING PAVEMENT

REV. STA. 296+01 LT  
BEGIN REMOVAL & DISPOSAL  
OF GUARD RAIL.

C = 0 Sq Ft  
F = 198 Sq Ft  
R = 0 Sq Ft

SURV. 296 + 00 = REV. 295 + 97.14

SURV. 295 + 80 = REV. 295 + 74.79  
ASKEWED @ 72°-02' LT.

SURV. 295 + 50 = REV. 295 + 47.13

SURV. 295 + 00 = REV. 294 + 96.95

C = 0 Sq Ft  
F = 247 Sq Ft  
R = 0 Sq Ft



C = 0 Sq Ft  
F = 283 Sq Ft  
R = 0 Sq Ft

REV. STA. 295+95 RT.  
BEGIN REMOVAL & DISPOSAL  
OF GUARD RAIL

REV. STA. 296+50 RT  
END FLARE & CONTINUE  
GUARD RAIL

REV. STA. 296+00 RT.  
BEGIN STL. BEAM GUARD  
RAIL & FLARE

REV. STA. 295+75 ~ 296+00 RT  
CONSTRUCT BREAKAWAY CABLE  
TERMINAL

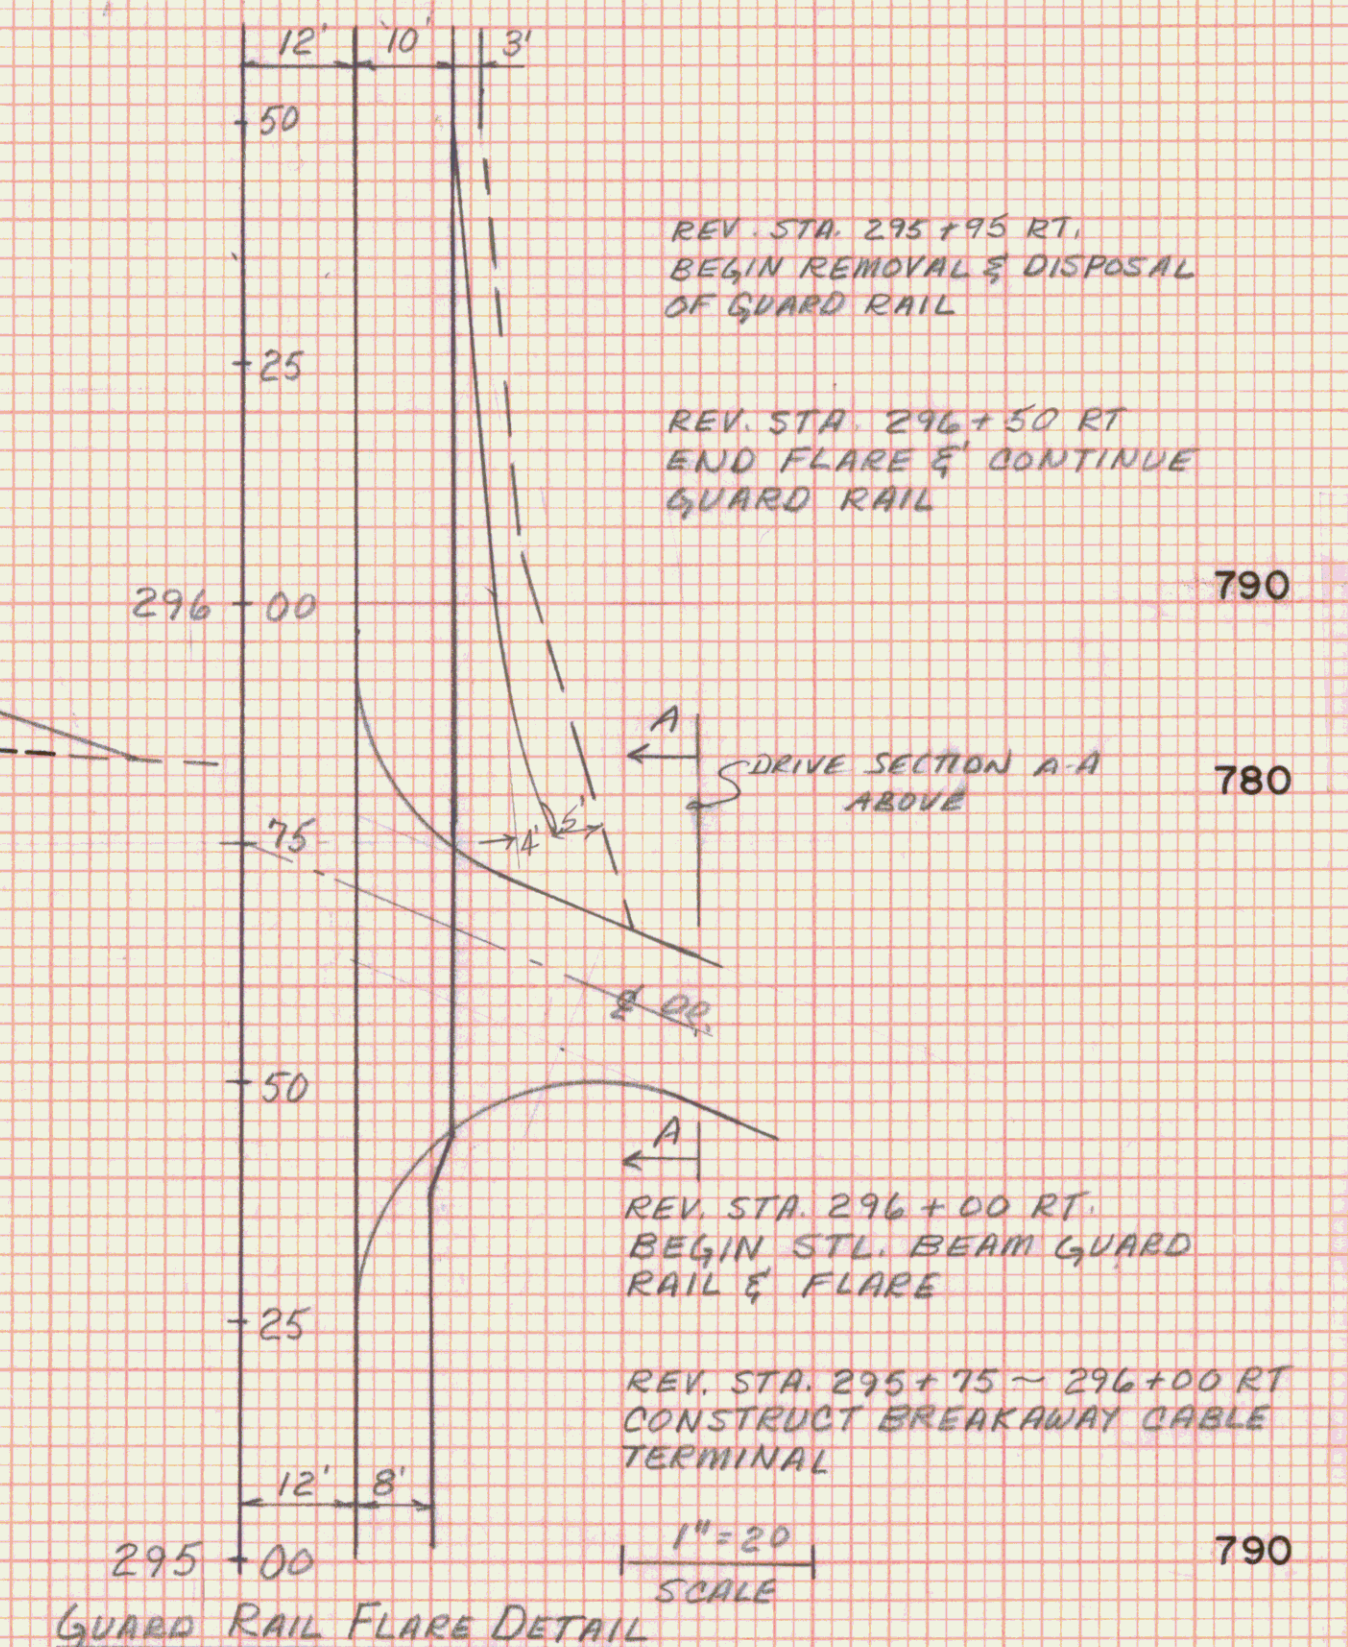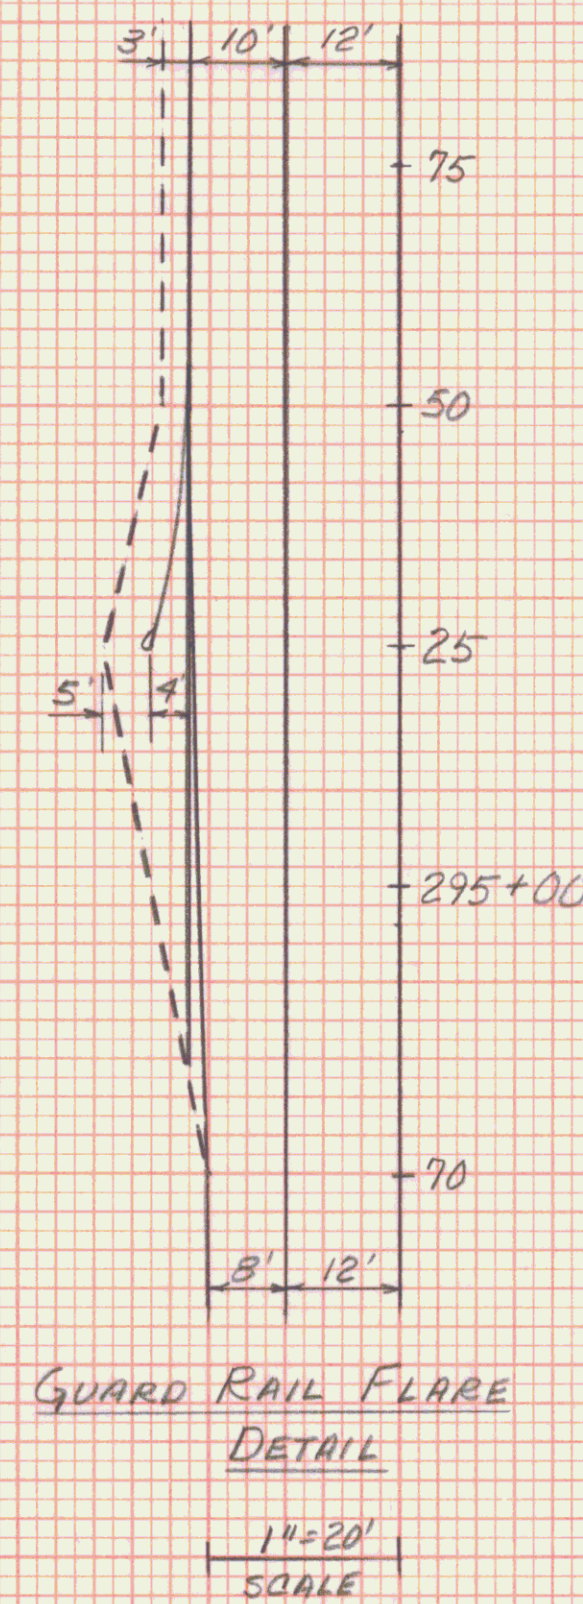

|                          |            |            |           |
|--------------------------|------------|------------|-----------|
| STA.                     | 295+00     | STA.       | 296+00    |
| TOWN                     | MARSHFIELD |            |           |
| PROJECT                  | F          | NO.        | 028-3(28) |
| SHEET                    | 297        | OF         | 352       |
| HORIZ. AND VERT. SCALE   |            |            |           |
| 0 10 20                  |            |            |           |
| VT. SURVEY               |            |            |           |
| SURVEYED BY: CONSULTANTS |            | DATE 10/86 |           |