


DATE	BY
SURVEYED	PLANNED
NO.	NO.
FINAL SURVEY	NOTE BOOK

DATE	BY
10/86	
VT. SURVEY CONSULTANTS	BRYANT ASSOC.
SURVEYED	PLANNED
NO.	NO.
ORIGINAL SURVEY	NOTE BOOK

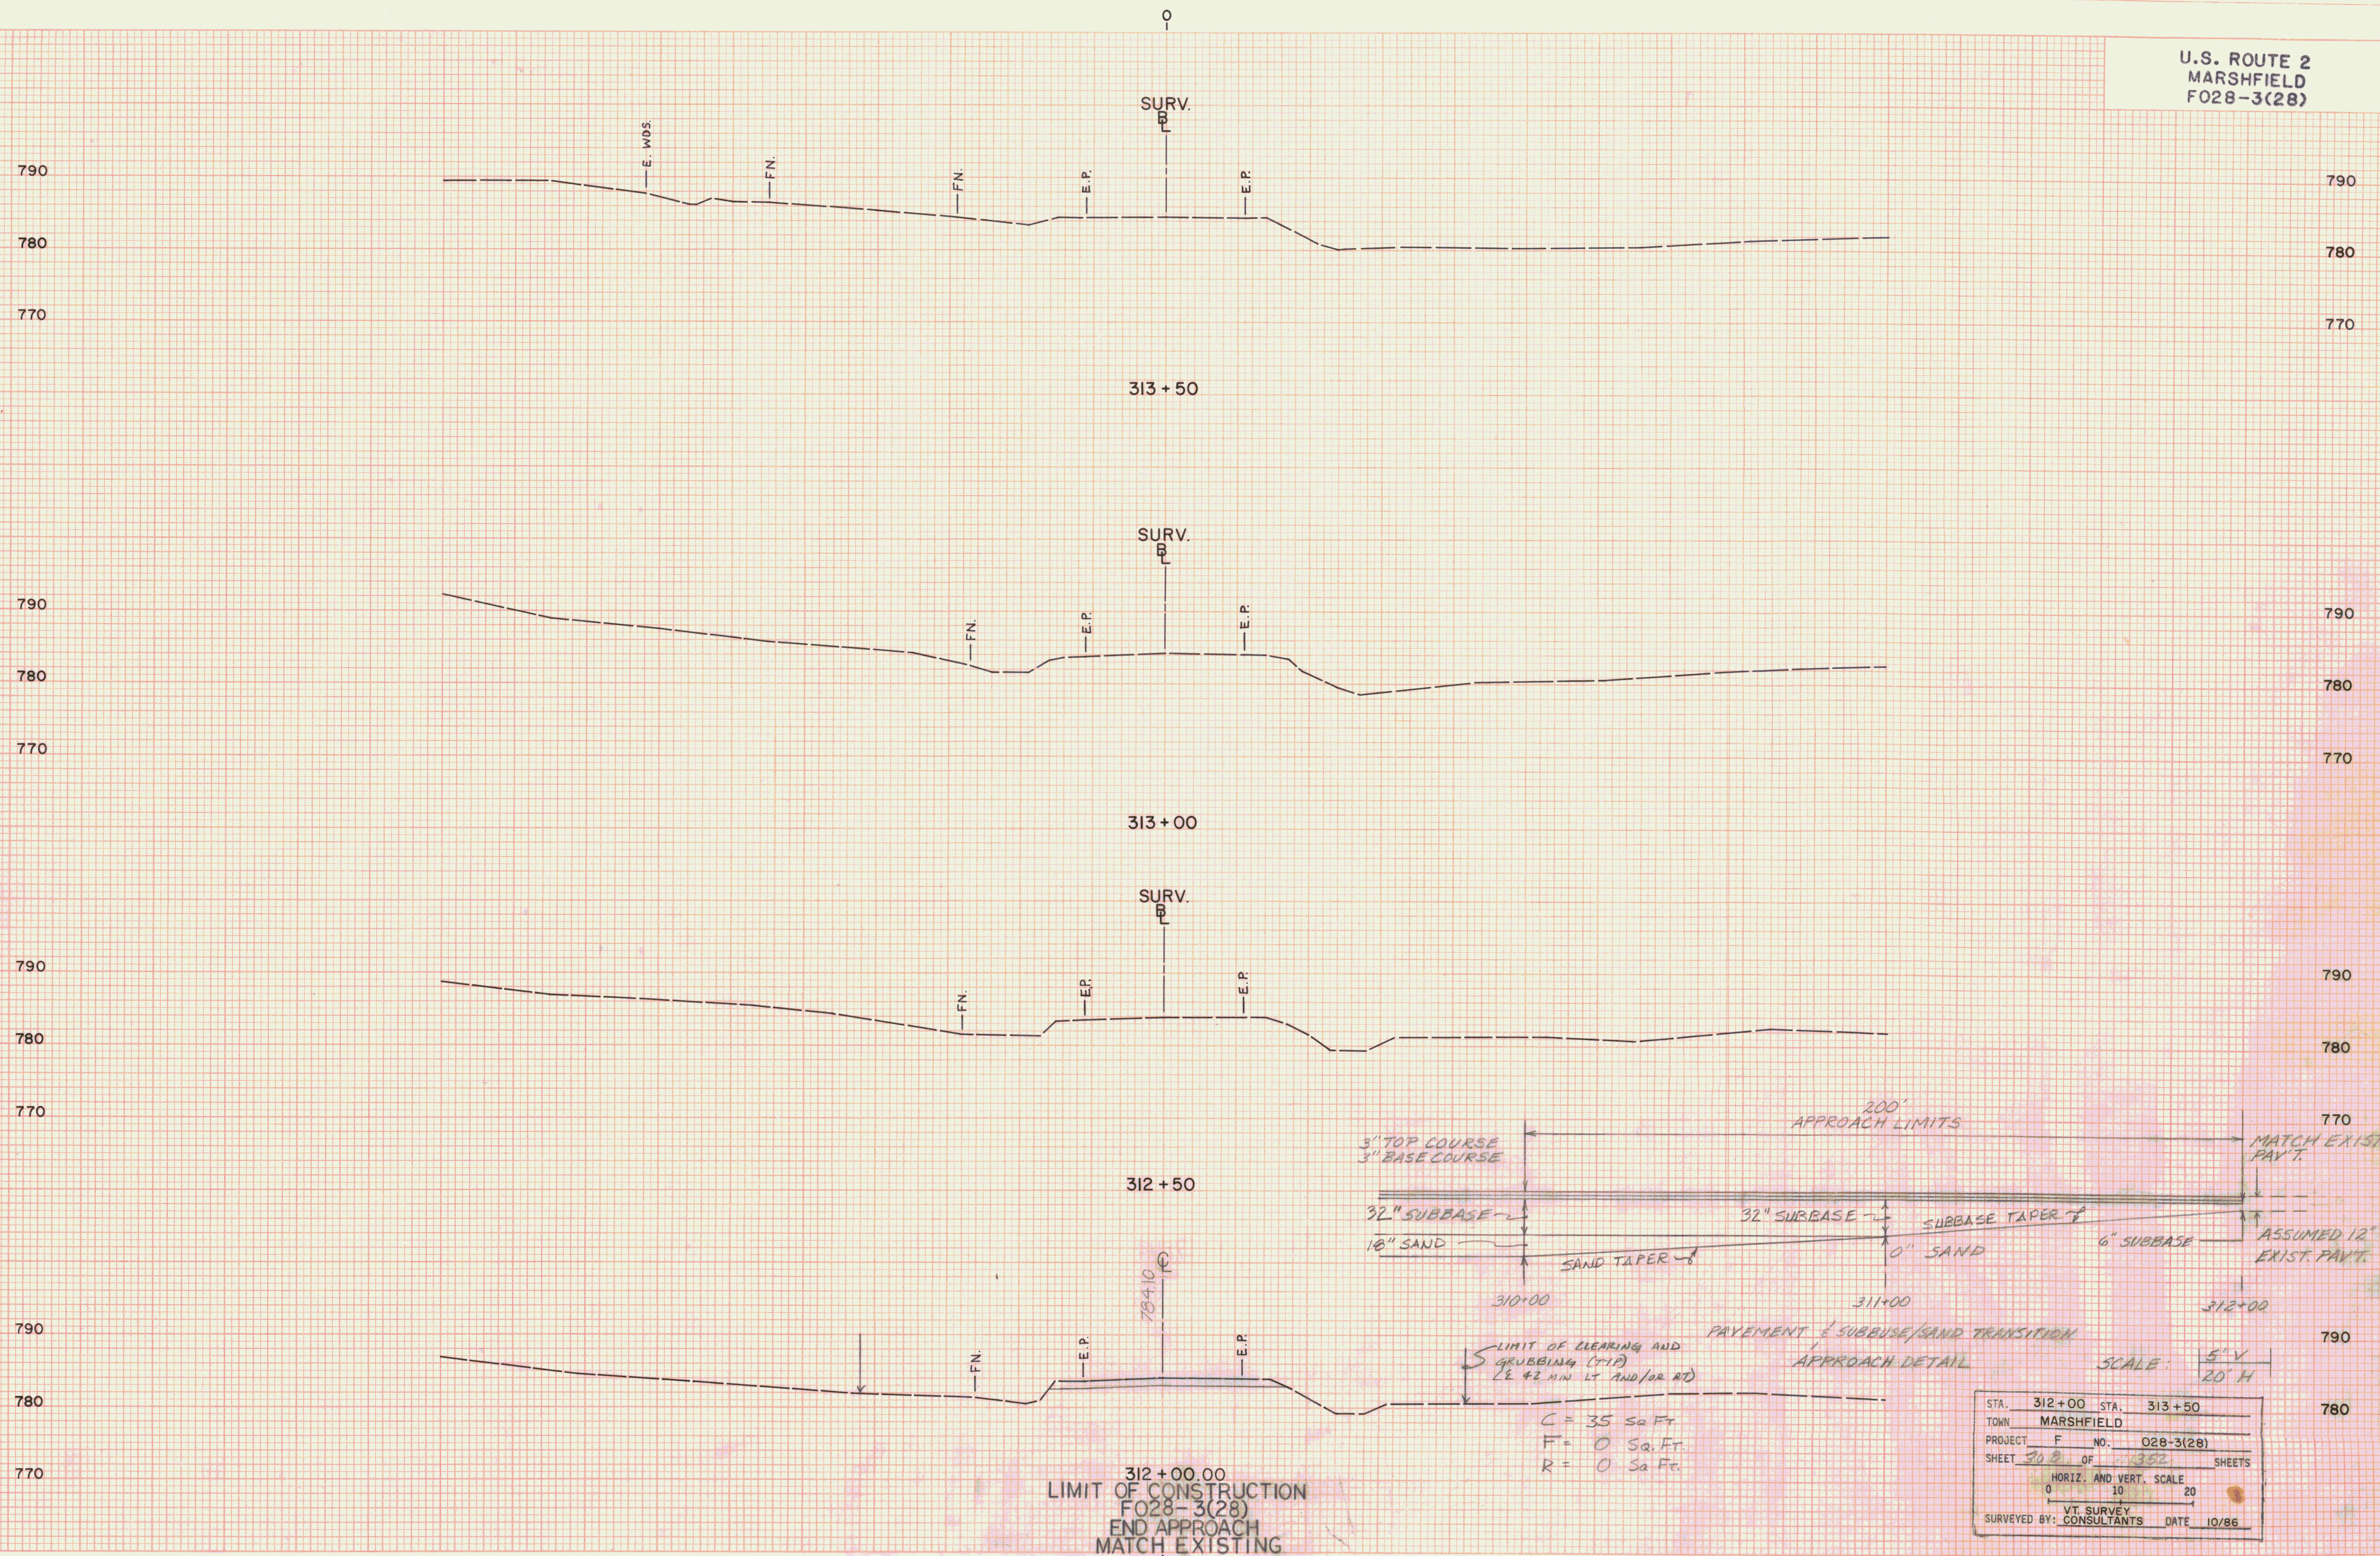

312+00.00
LIMIT OF CONSTRUCTION
F028-3(28)
END APPROACH
MATCH EXISTING

C = 35 Sq. Ft.
F = 0 Sq. Ft.
R = 0 Sq. Ft.

STA.	312+00	STA.	313+50
TOWN	MARSHFIELD		
PROJECT	F	NO.	028-3(28)
SHEET	308	OF	352
HORIZ. AND VERT. SCALE		SHEETS	
0 10 20			
VT. SURVEY		DATE 10/86	
SURVEYED BY: CONSULTANTS			