

T.H. 57

REV. P.O.T. 95 + 25.71 = T.H. 57 REV. P.O.T. 9 + 74.39

FINAL SURVEY NOTE BOOK NO. \_\_\_\_\_

DATE \_\_\_\_\_

BY \_\_\_\_\_

REVISED \_\_\_\_\_

PLOTTED \_\_\_\_\_

AREA CHECKED \_\_\_\_\_

ORIGINAL SURVEY NOTE BOOK NO. \_\_\_\_\_

DATE 12/18/86

BY VT. SURVEY CONSULTANTS ASSOC.


REVISED \_\_\_\_\_

PLOTTED \_\_\_\_\_


AREA CHECKED \_\_\_\_\_

770  
760  
750

770  
760  
750

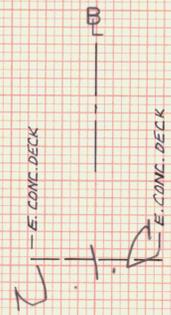

11 + 50

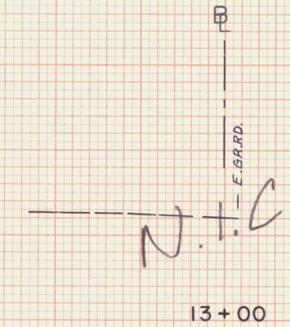


13 + 00

770  
760  
750

770  
760  
750

REV. STA. 11 + 17.59 LT.  
END STEEL BEAM GUARD RAIL  
REV. STA. 11 + 18.59 LT.  
END REMOVAL OF GUARD RAIL  
END TAPER

BARN

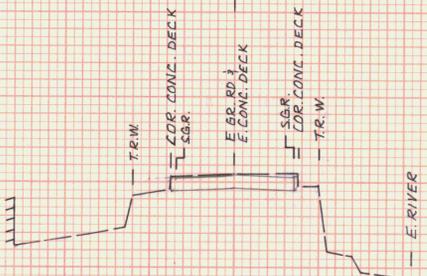


REV. STA. 11 + 17.09 RT.  
END STEEL BEAM GUARD RAIL  
REV. STA. 11 + 18.59 RT.  
END REMOVAL OF GUARD RAIL

RTIC 23 SF  
RTIC 0

SURV. 11 + 18.11 = REV. 11 + 18.59  
LIMIT OF CONSTRUCTION  
MATCH EXIST.


770  
760  
750

770  
760  
750

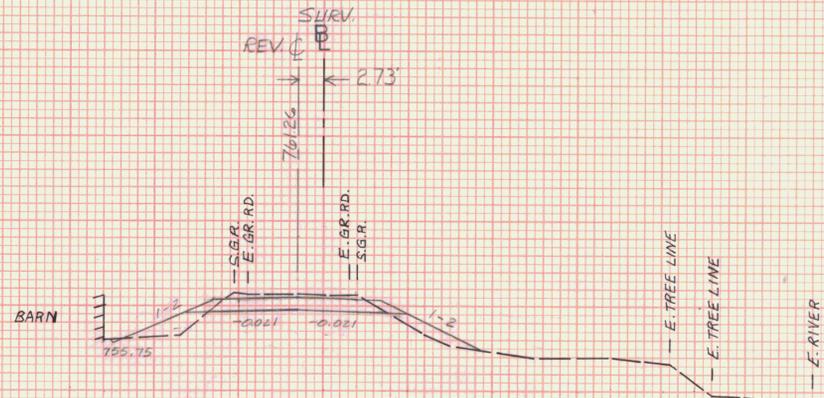


REV. 11 + 00.27 = SURV. 11 + 00


RTIC 36 SF  
RTIC 24 SF  
RTIC 0

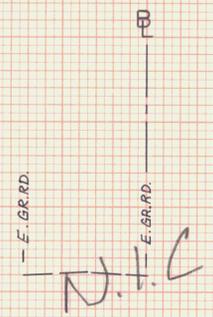

12 + 50

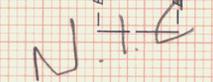

12 + 00

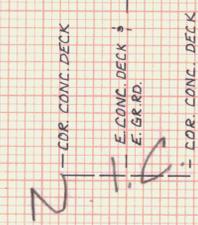

11 + 77.4

T.H. #57 2 OF 2

STA.	11 + 00	STA.	13 + 00
TOWN	MARSHFIELD		
PROJECT	F	NO.	028-3(28)
SHEET	310	OF	41358
SHEETS			
HORIZ. AND VERT. SCALE			
0 10 20			
VT. SURVEY			
SURVEYED BY: CONSULTANTS DATE 12/86			