
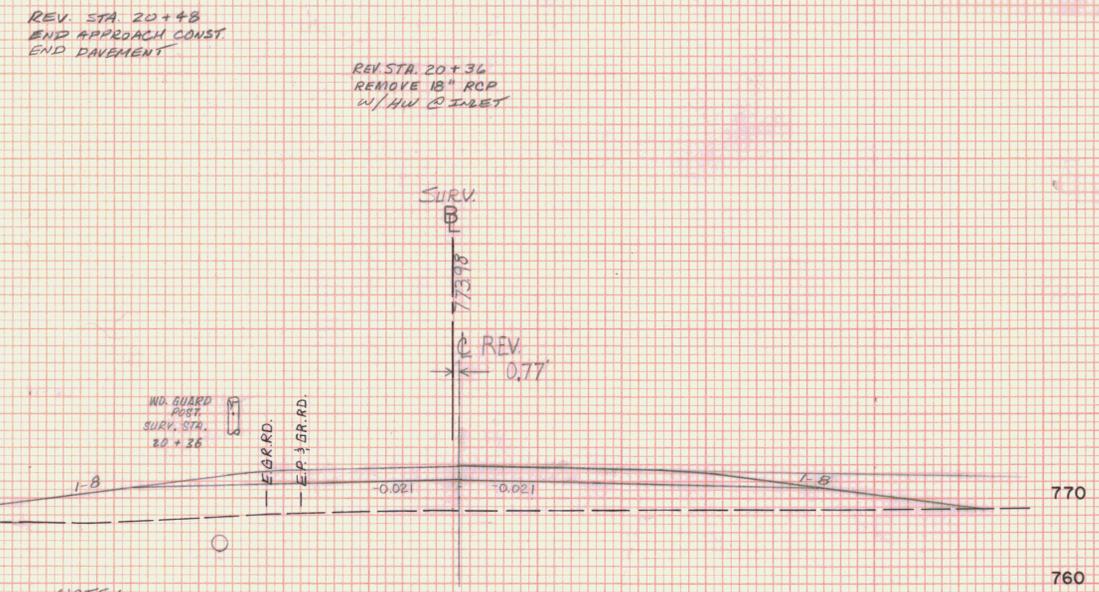
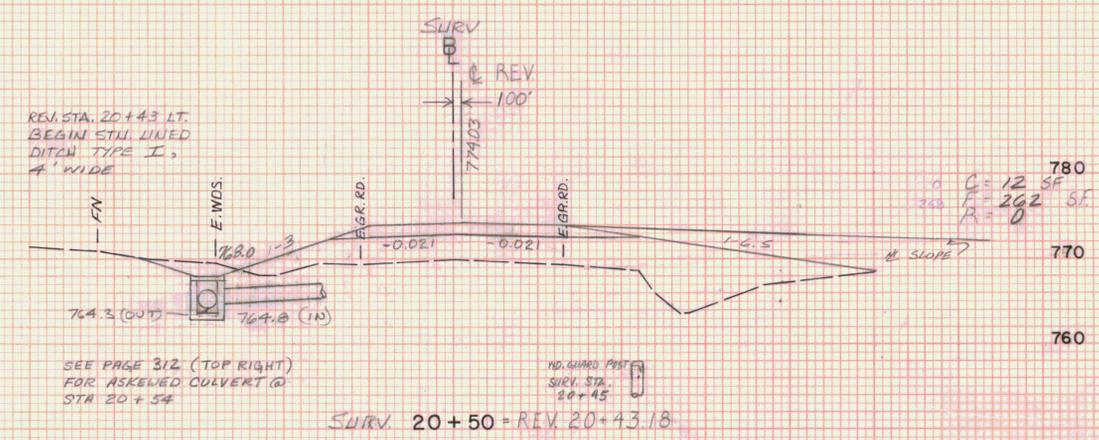
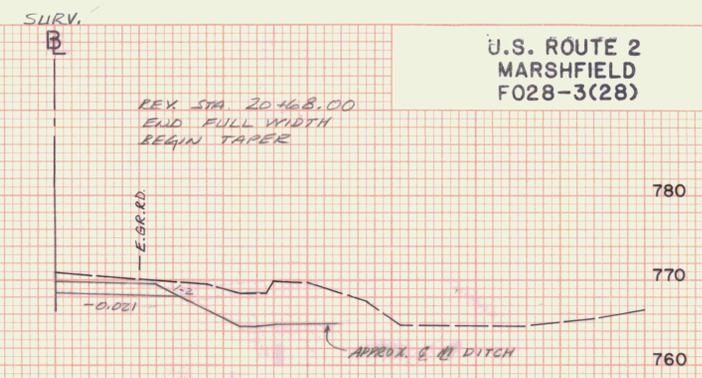
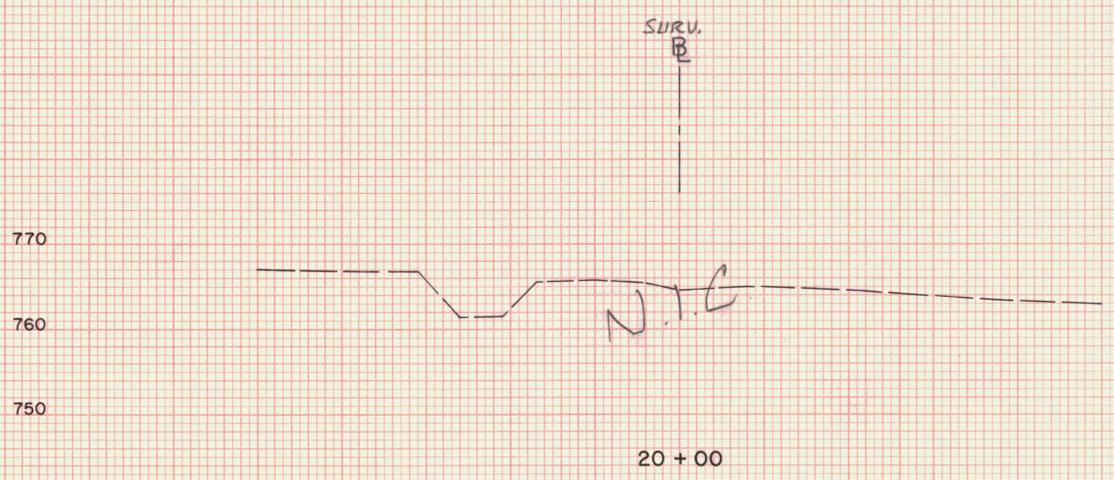
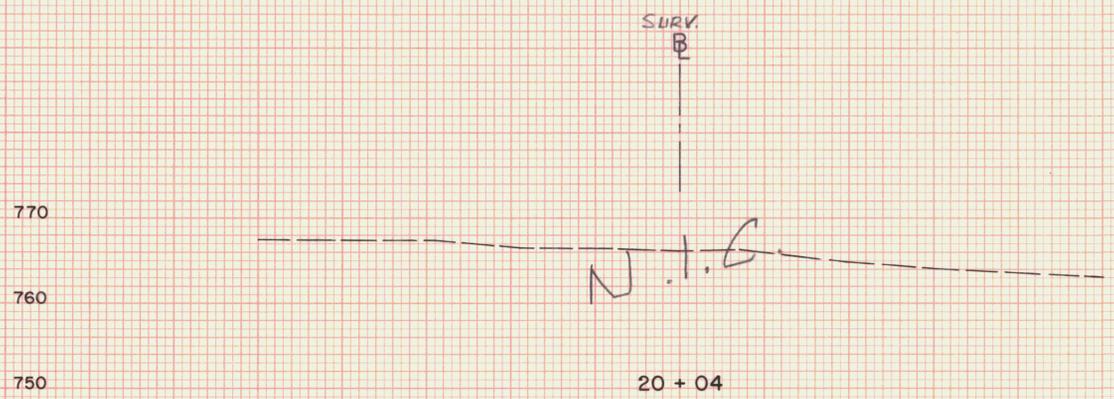


DATE
BY
REVISED
PLOTTED
AREA
NO.

DATE
BY
VT. SURVEY CONSULTANTS
BRYANT ASSOC.
REVISED
PLOTTED
AREA
NO.

T.H. 56
REV. P.O.T. 104+04.24 = T.H. 56 REV. P.O.T. 20+00.00

U.S. ROUTE 2
MARSHFIELD
FO28-3(28)

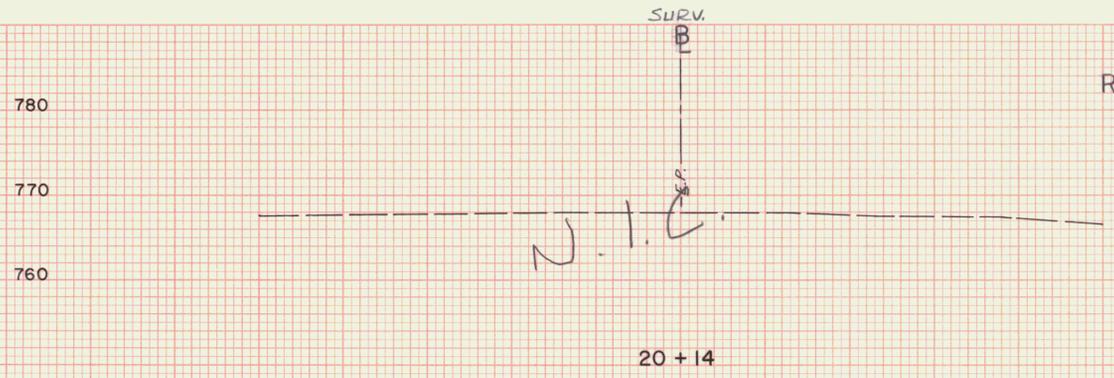

REV. STA. 20+46.00
END FULL WIDTH
BEGIN TAPER

APPROX. 6" DITCH

NOTE:
THIS SECTION IS NOT TO
BE USED FOR EARTHWORK

REV. STA. 20+43.18
BEGIN STRIP LINED
DITCH TYPE I,
4' WIDE

SEE PAGE 312 (TOP RIGHT)
FOR ASKEWED CULVERT @
STA 20+54

REV. STA. 20+48
END APPROACH CONST.
END PAVEMENT

REV. STA. 20+36
REMOVE 18" RCP
W/ HW @ J-BET

NOTE:
THIS SECTION IS NOT TO BE
USED FOR EARTHWORK
(BEGIN @ SURV. 20+50)

T.H. #56 1 OF 2

STA.	20+00	STA.	20+58
TOWN	MARSHFIELD		
PROJECT	F	NO.	028-3(28)
SHEET	311	OF	352 SHEETS
HORIZ. AND VERT. SCALE			
1" = 20'			
SURVEYED BY: VT. SURVEY CONSULTANTS			
DATE: 12/86			