
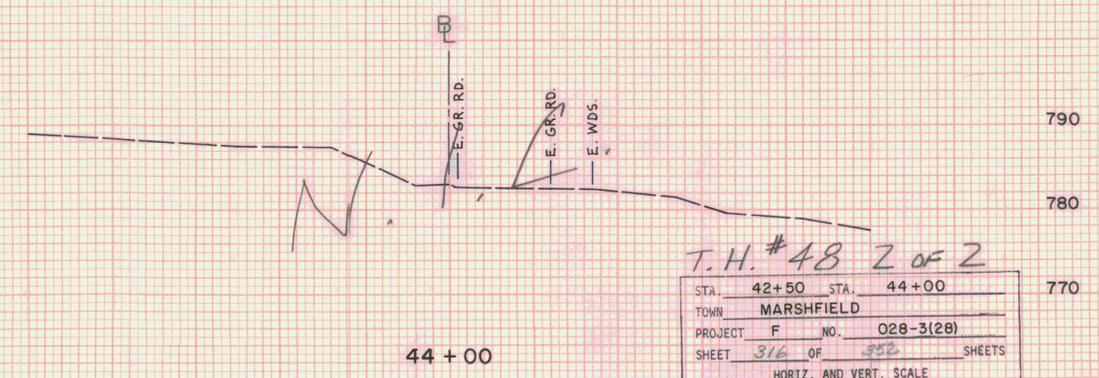
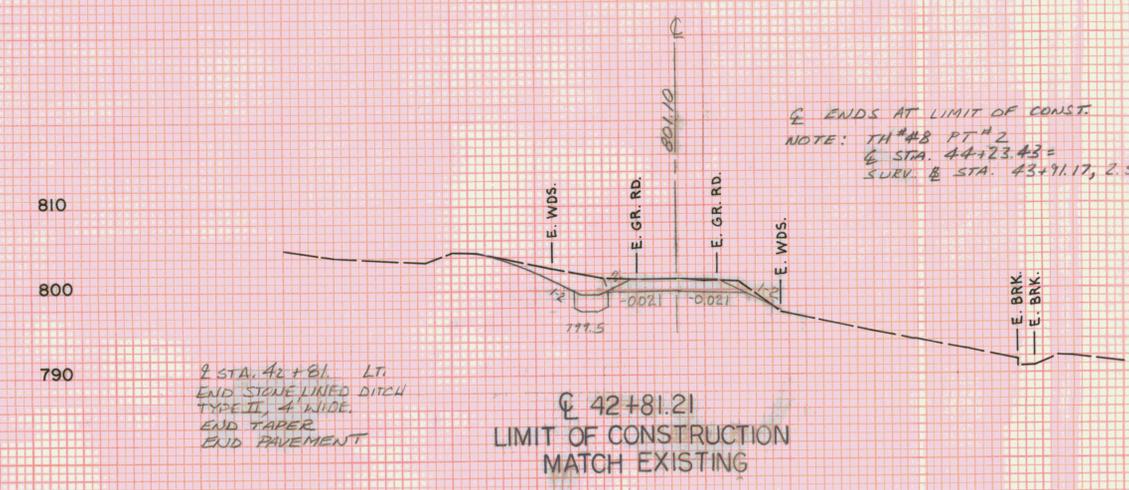
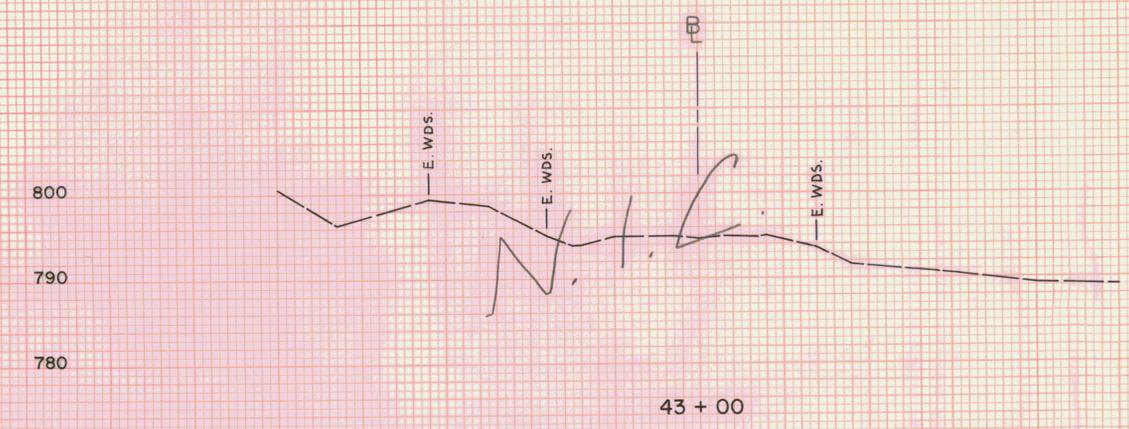


T.H. 48
REV. P.O.T. 125+25.54 = T.H. 48 C P.O.T. 39+81.49

FINAL SURVEY NOTE BOOK No. []
 INVENTED BY []
 PLOTTED BY []
 TRIMMED BY []
 AREA CHECKED BY []

VT. SURVEY CONSULTANTS BRYANT ASSOC. 7/86
 ORIGINAL SURVEY NOTE BOOK No. []
 SURVEYED BY []
 TRIMMED BY []
 AREA CHECKED BY []

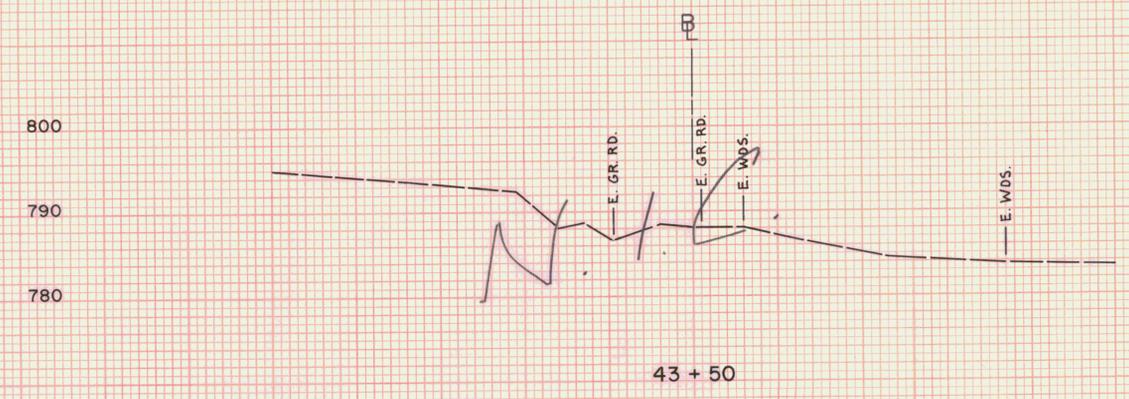

T.H. #48 2 OF 2

STA. 42+50	STA. 44+00
TOWN MARSHFIELD	
PROJECT F	NO. 028-3(28)
SHEET 316	OF 352 SHEETS
HORIZ. AND VERT. SCALE	
0	10 20
VT. SURVEY CONSULTANTS DATE 12/86	