


T.H. 55

SURV. STA. 141+59.84 = T.H. 55 @ STA. 50+60.48  
REV. POT. 141+25.00 = T.H. 55 REV. POT. 50+00.00


DATE	
BY	
REVIEWED	
PLOTTED	
AREA	
AREA CHECKED	
FINAL SURVEY	
NOTE BOOK	
No.	

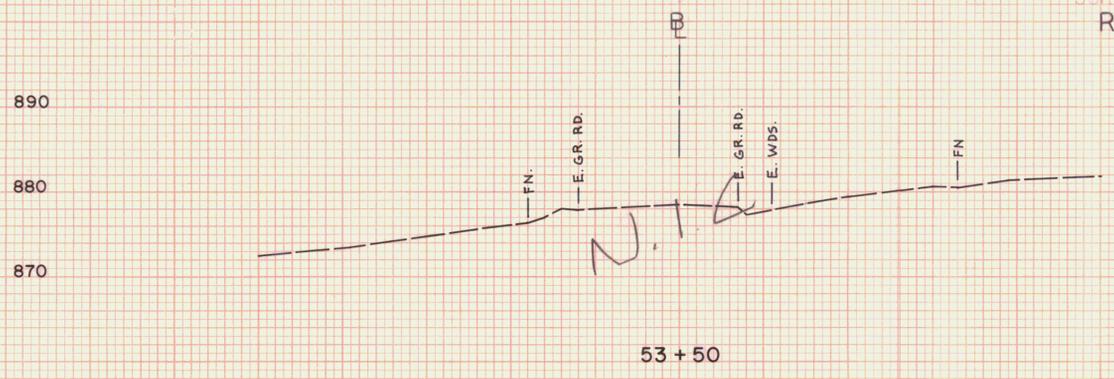

REV. 53+70.34 = SURV 53+00  
LIMIT OF CONSTRUCTION  
MATCH EXISTING  
END TAPER

C = 26 Sq Ft.  
F = 15a Ft.  
R = 0

DATE	12/86
BY	VT. SURVEY CONSULTANTS BRYANT ASSOC.
REVIEWED	
PLOTTED	
AREA	
AREA CHECKED	
ORIGINAL SURVEY	
NOTE BOOK	
No.	

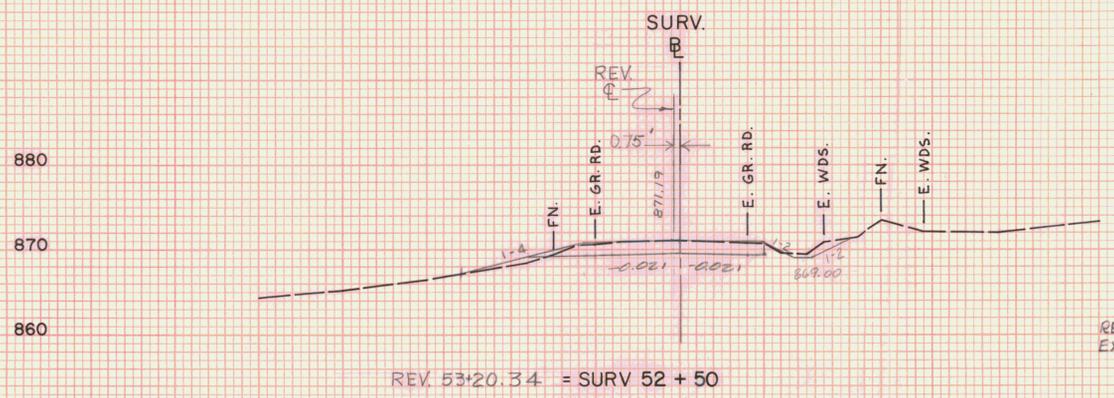

C = 40 SF.  
F = 6 SF.  
R = 0

REV. STA. 52+82 RT.  
EXIST. 18" ALLEMP (REMOVE)

T.H. #55 2 OF 2

STA.	52+50	STA.	53+50
TOWN	MARSHFIELD		
PROJECT	F	NO.	028-3(28)
SHEET	348	OF	352
SHEETS			
HORIZ. AND VERT. SCALE			
0 10 20			
VT. SURVEY			
SURVEYED BY: CONSULTANTS DATE 12/86			