
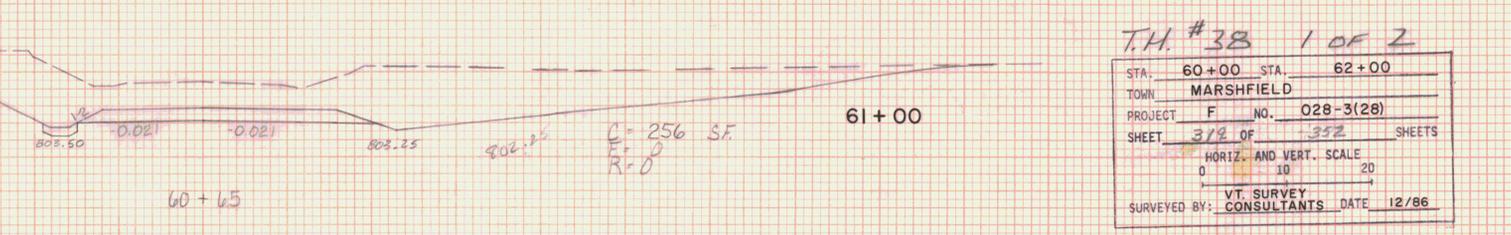
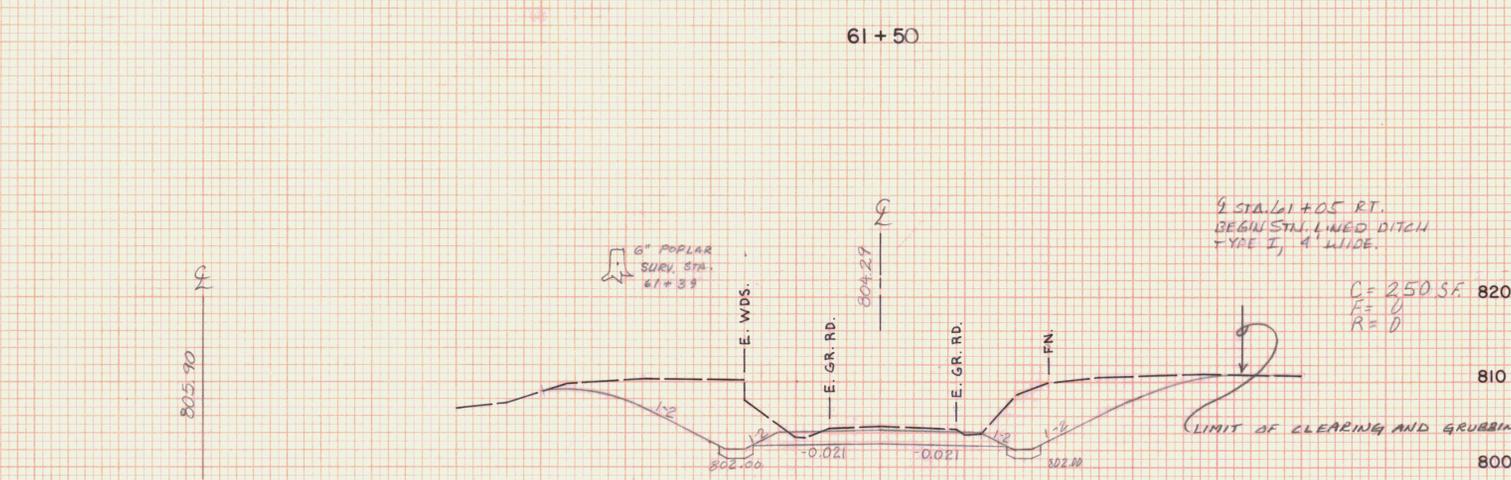
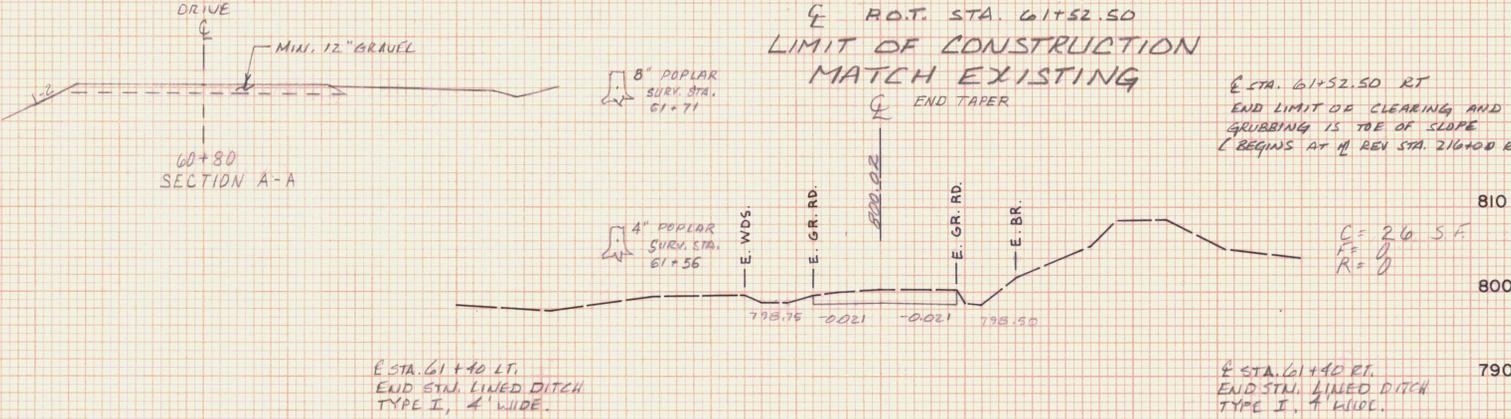
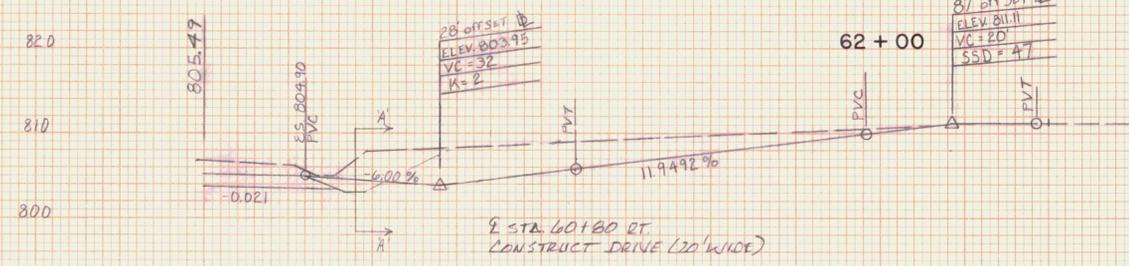


T.H. 38
REV. POT. 218+94.34 = T.H. C POT. 60+09.97

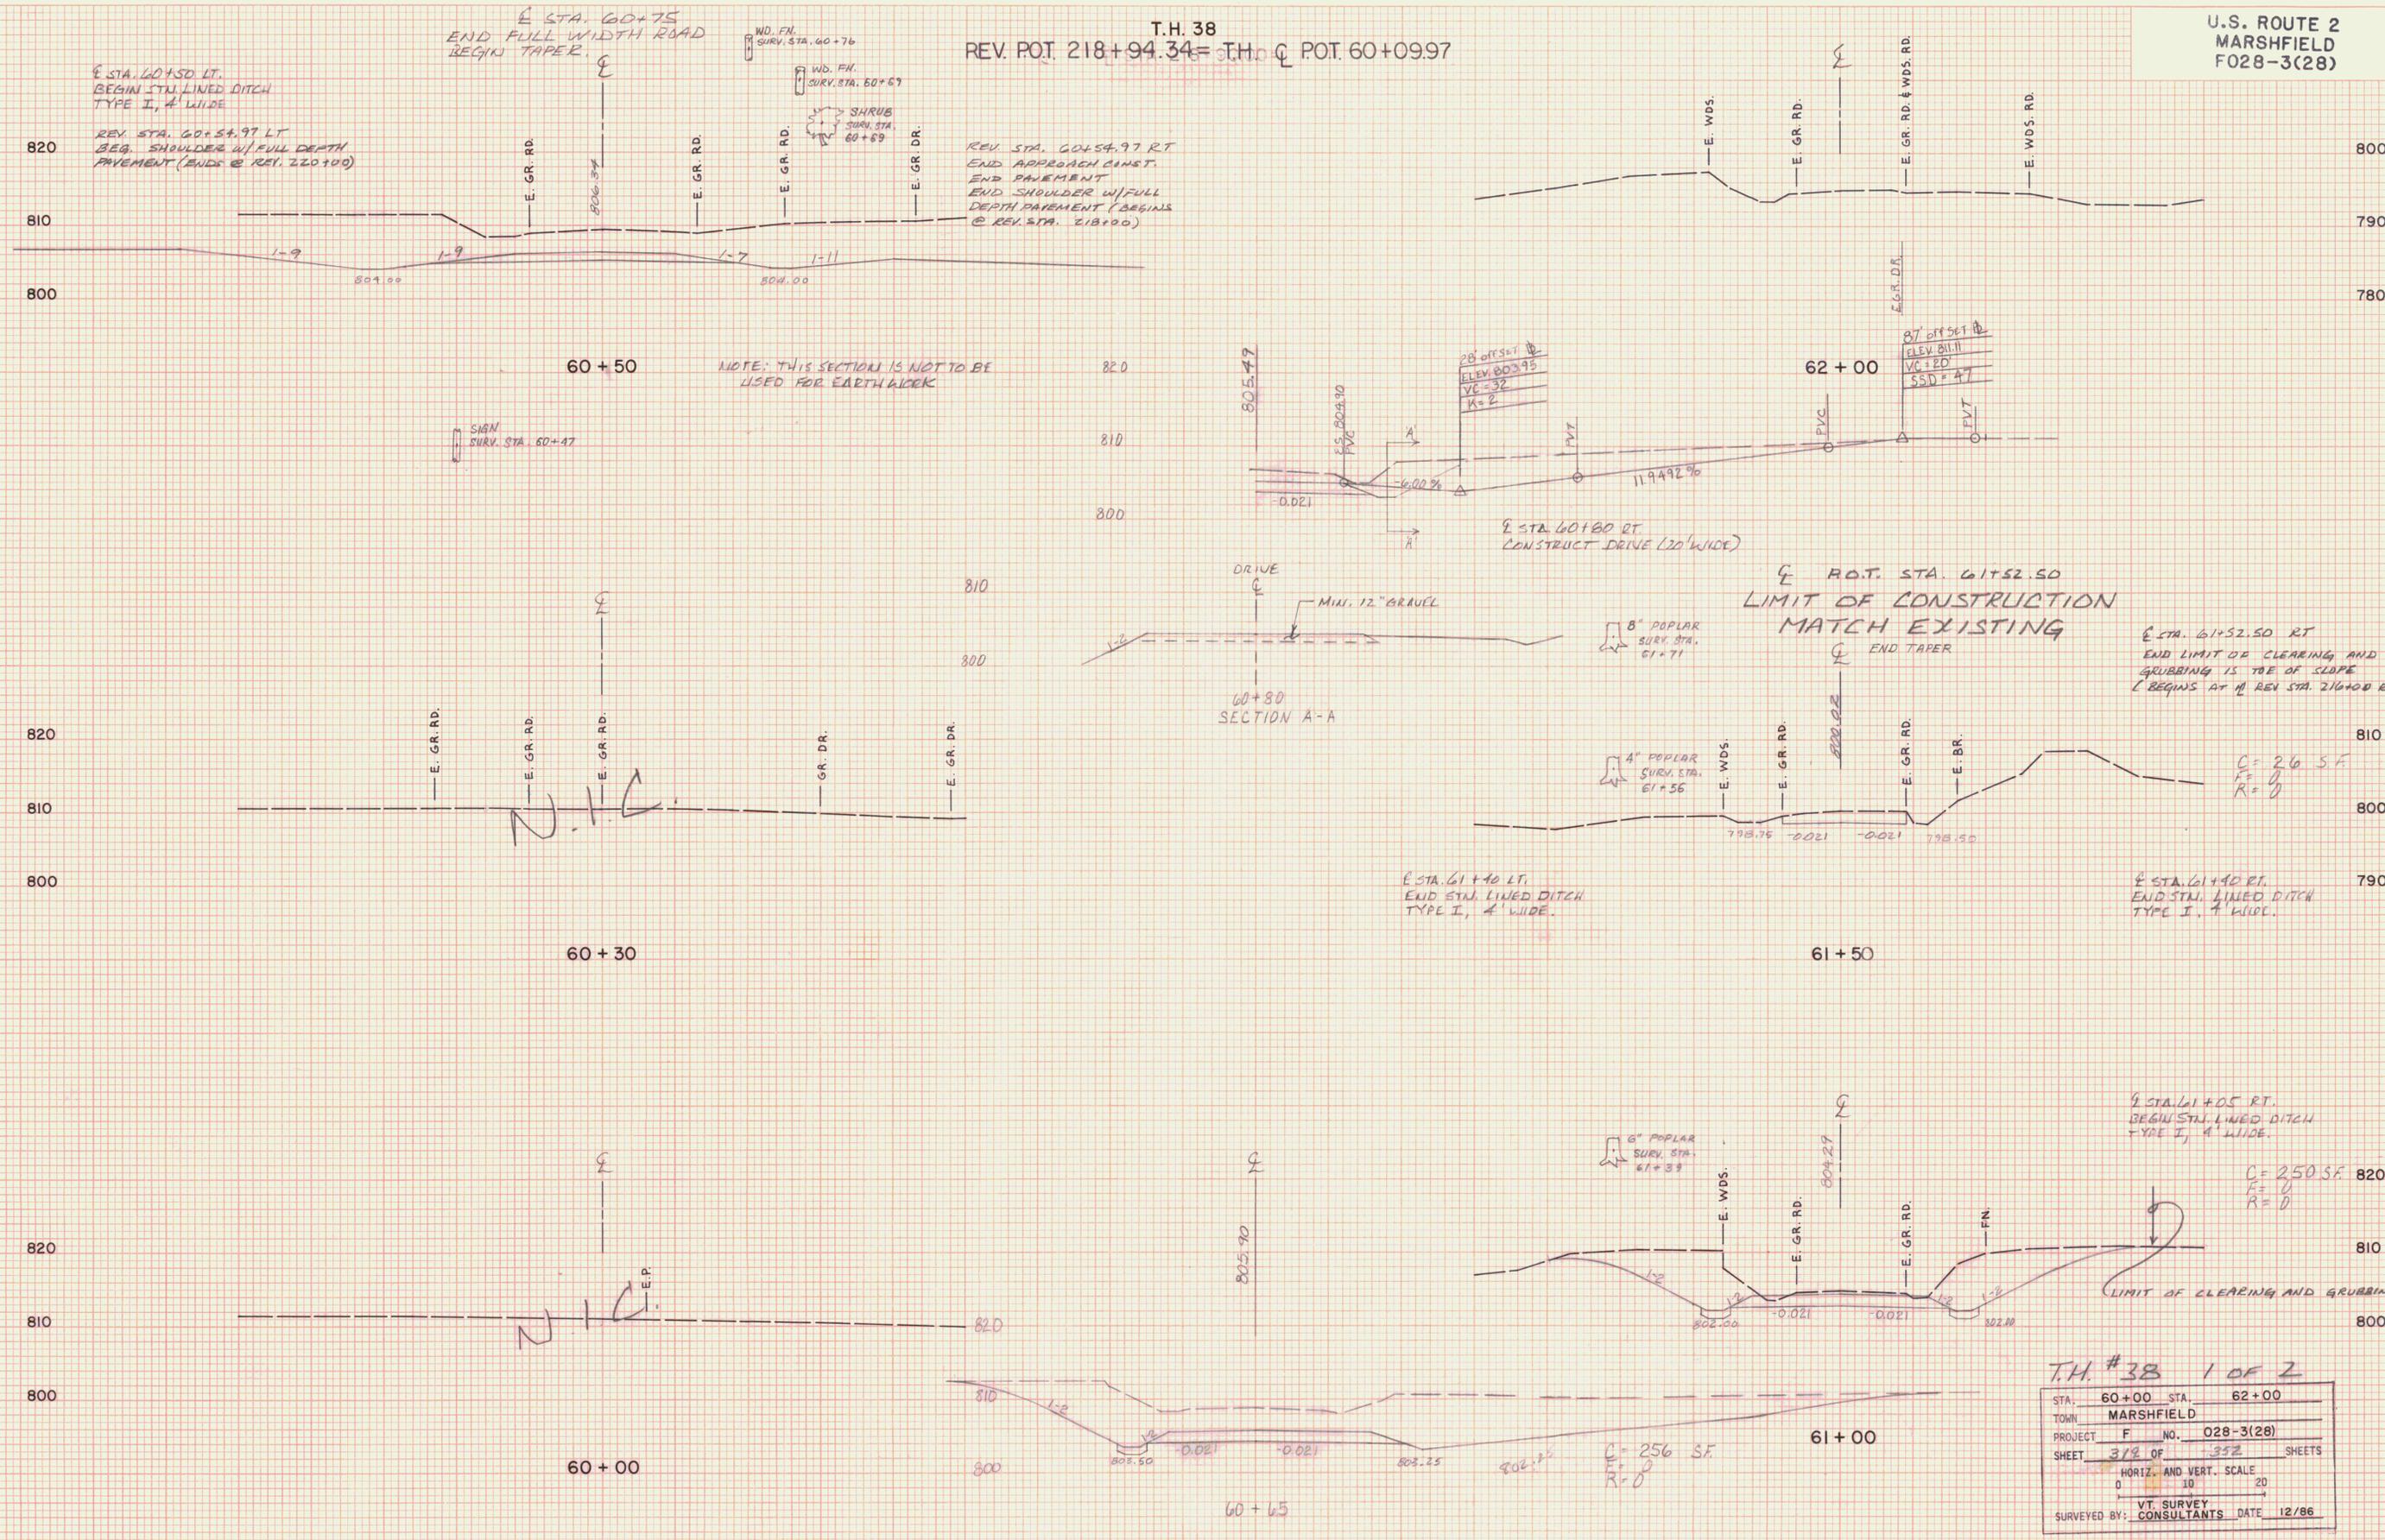

DATE
BY
NO.

REVIEWED
PLOTTED
TEMPLATE
AREAS CHECKED

FINAL
SURVEY
NOTE BOOK
NO.

DATE
BY
NO.

REVIEWED
PLOTTED
TEMPLATE
AREAS CHECKED

ORIGINAL
SURVEY
NOTE BOOK
NO.

VT. SURVEY CONSULTANTS
BRYANT ASSOC.

T.H. #38 1 OF 2

| | | | |
|-----------------------------------|-----------------|------|------------|
| STA. | 60+00 | STA. | 62+00 |
| TOWN | MARSHFIELD | | |
| PROJECT | F NO. 028-3(28) | | |
| SHEET | 318 | OF | 352 SHEETS |
| HORIZ. AND VERT. SCALE | | | |
| 0 10 20 | | | |
| VT. SURVEY CONSULTANTS DATE 12/86 | | | |