


DATE
BY
REVISIONS
NO. DATE
FINAL SURVEY
NOTE BOOK
NO.

DATE
BY
REVISIONS
NO. DATE
ORIGINAL SURVEY
NOTE BOOK
NO.

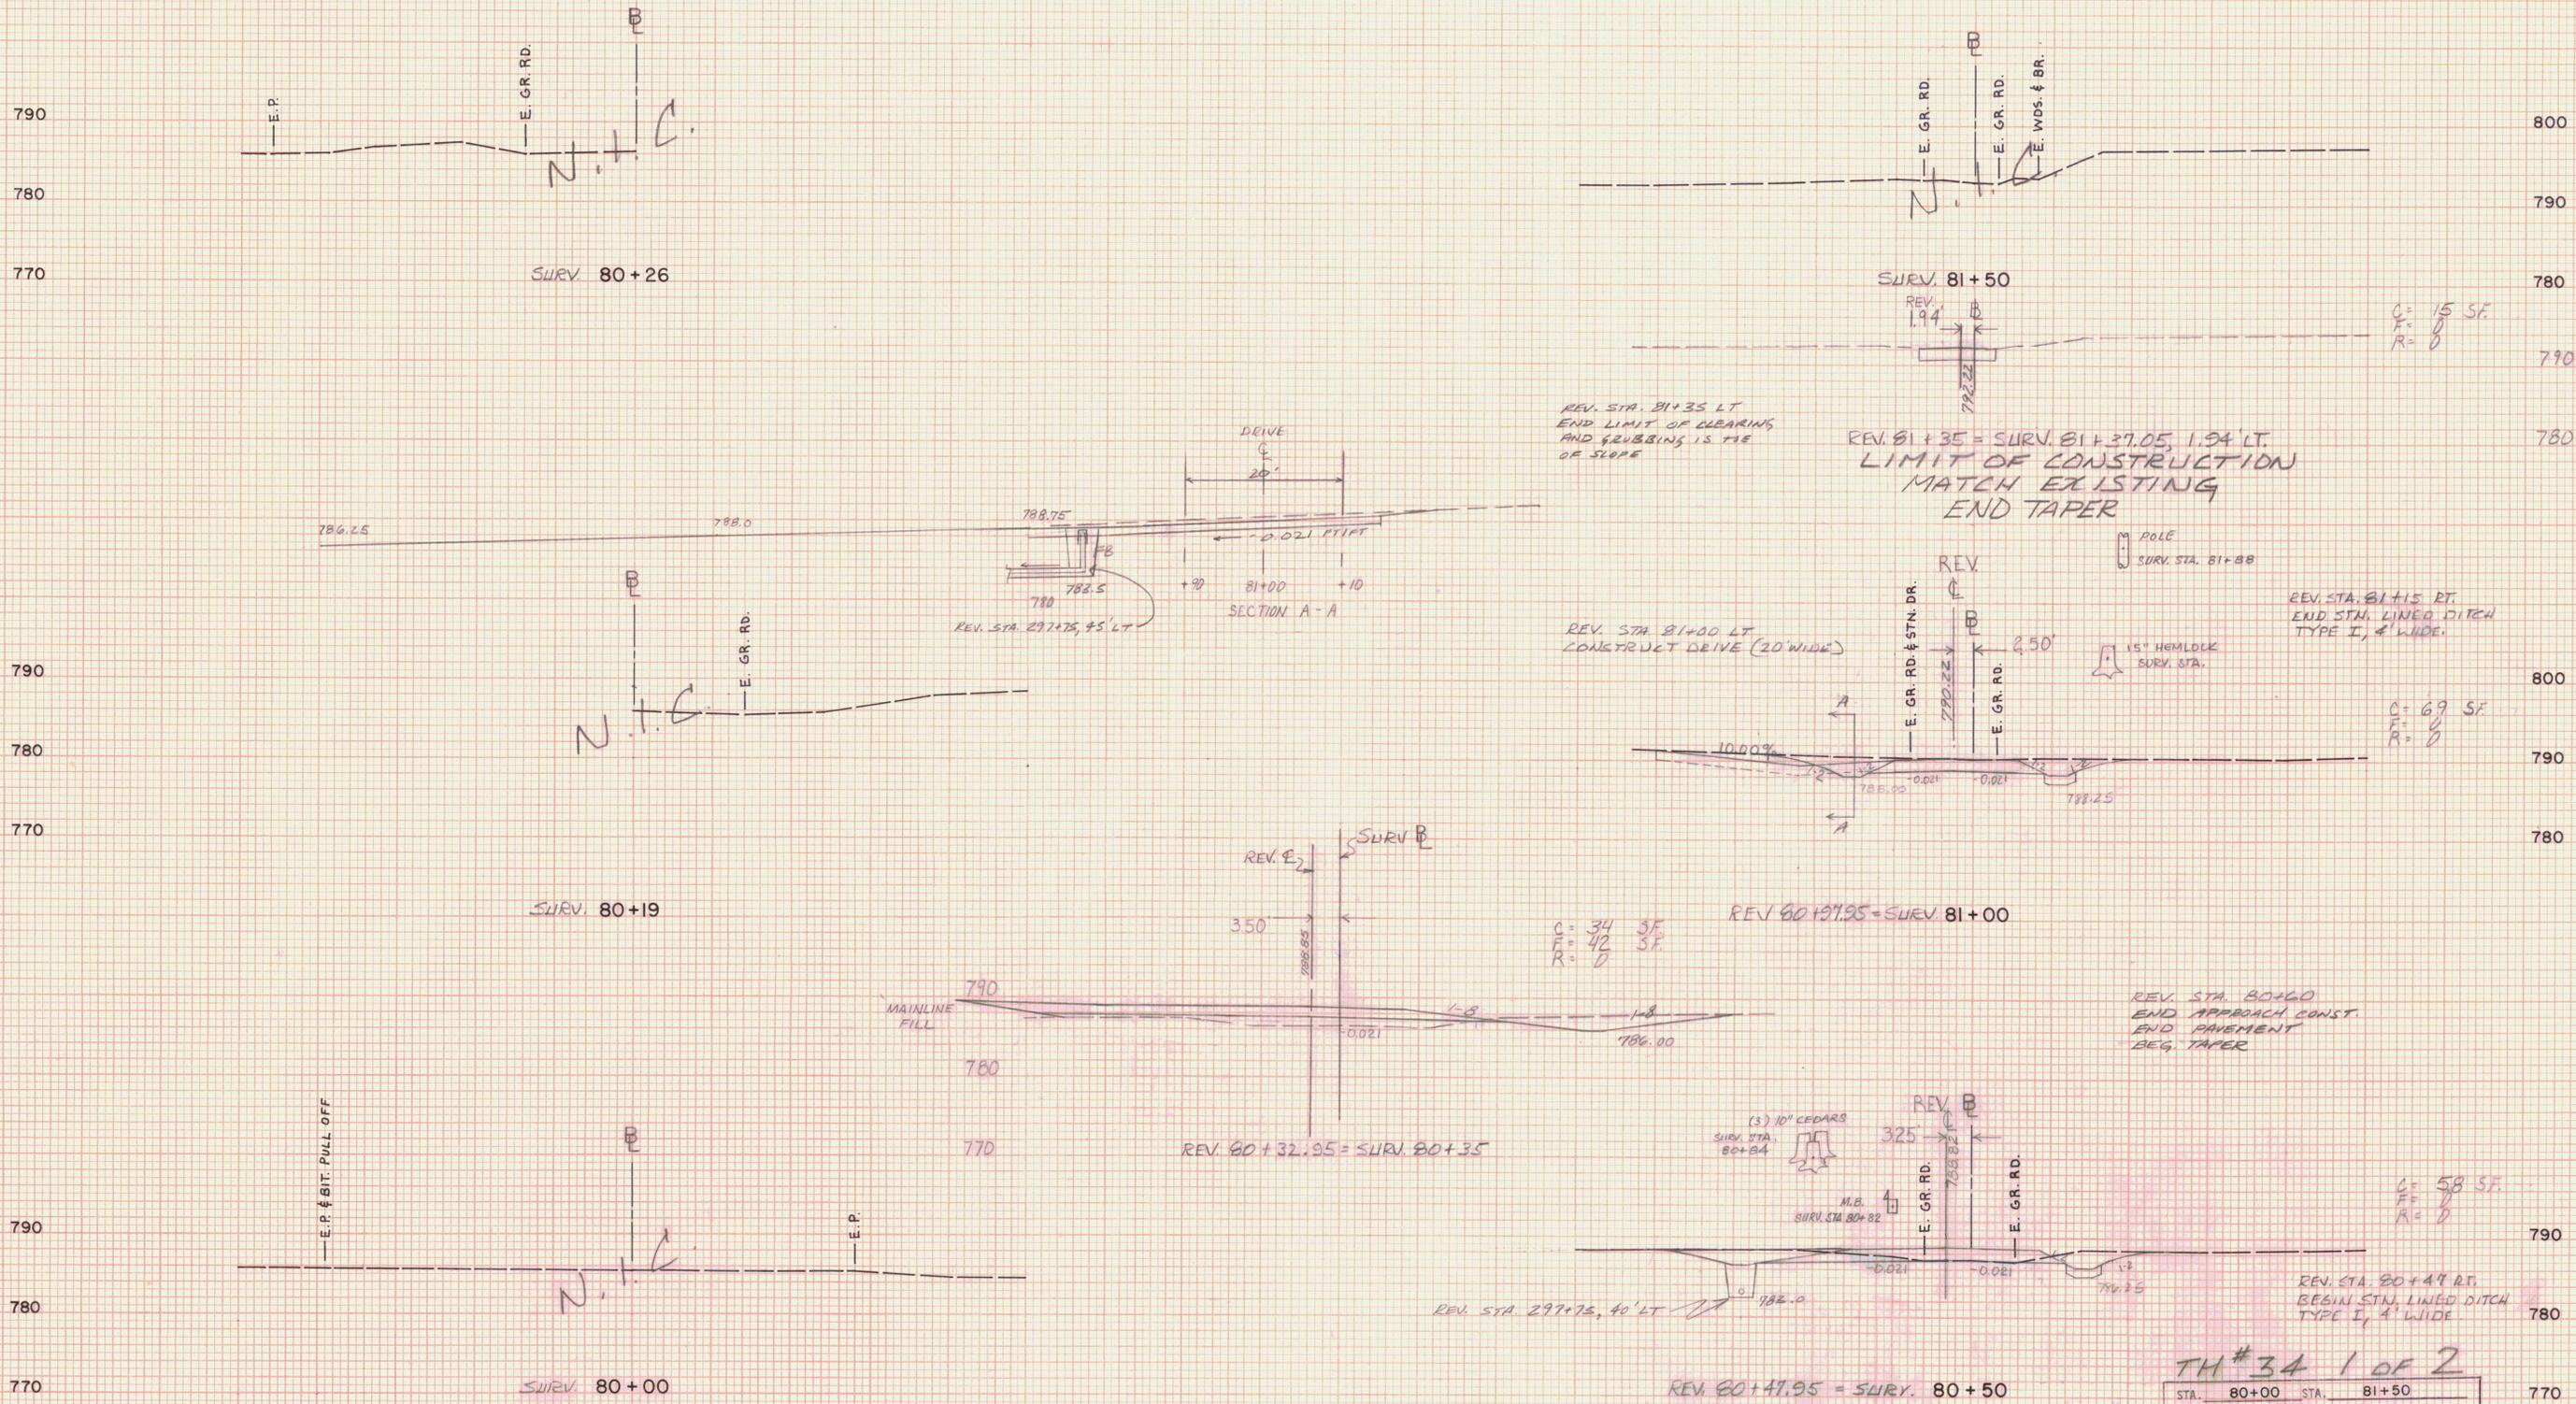

TH # 34 1 OF 2

STA.	80+00	STA.	81+50
TOWN	MARSHFIELD		
PROJECT	F	NO.	028-3(28)
SHEET	323	OF	1362 SHEETS
HORIZ. AND VERT. SCALE			
0 10 20			
VT SURVEY			
SURVEYED BY: CONSULTANTS		DATE: 12/86	