
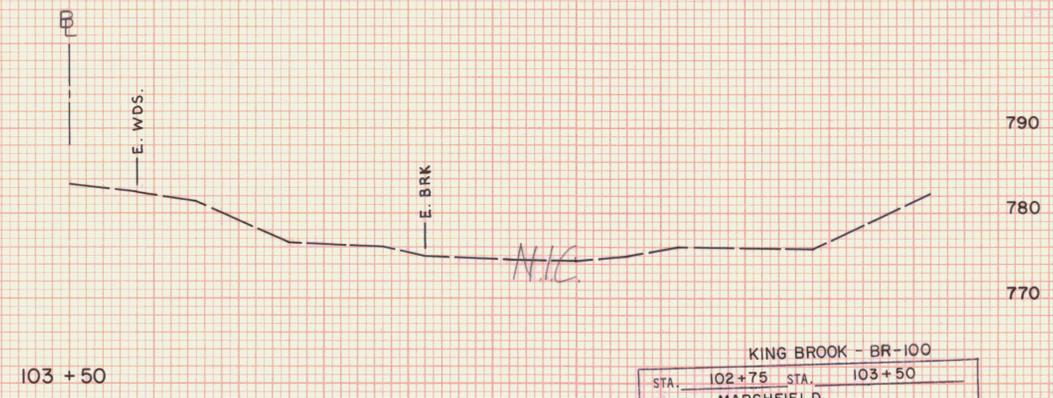
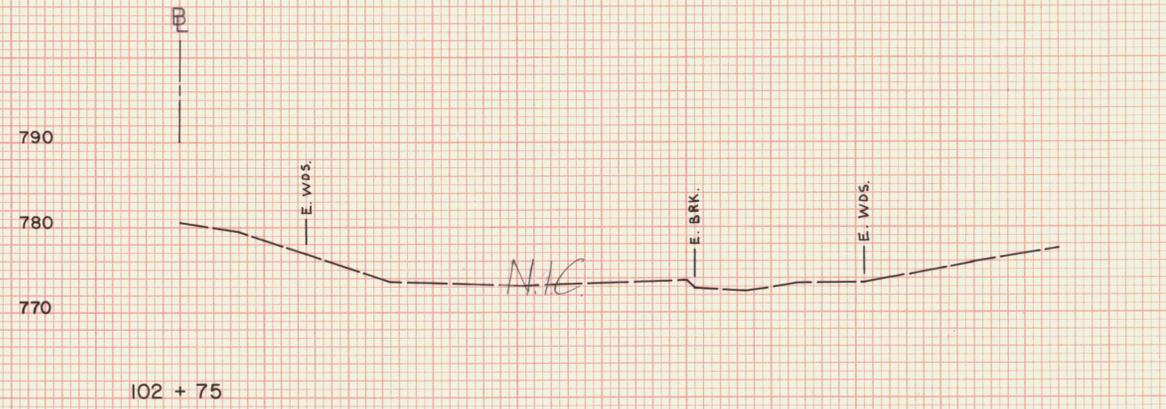
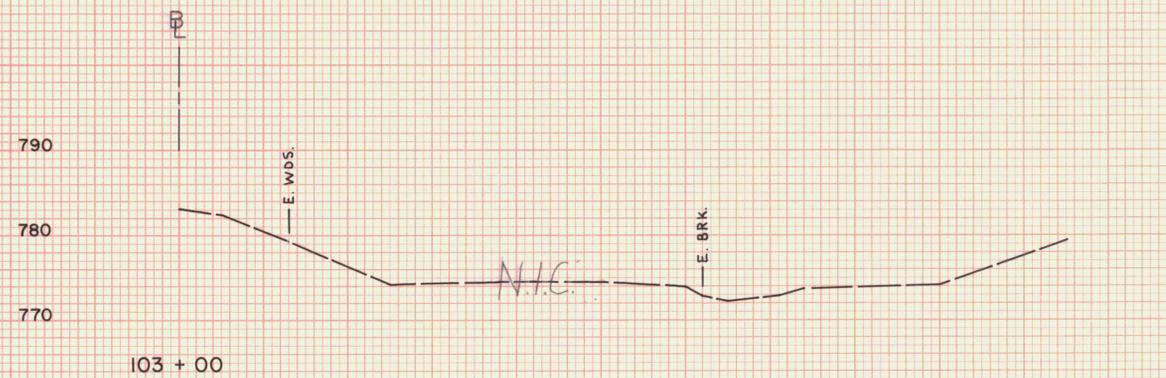


KING BROOK
CHANNEL SECTIONS
 ☐ STA. 113+85.00=
 (NEW 14'-10" x 9'-1" C.G.M.P.P.A.
 REV. ☐ STA. 114+00
 ASKEWED 70°00' LT.)

FINAL SURVEY NOTE BOOK NO.	DATE
BY	
REVIEWED	
PLOTTED	
AREA	
AREA CHECKED	

ORIGINAL SURVEY NOTE BOOK NO.	DATE
BY	12/86
VT. SURVEY CONSULTANT	1/87
BRYANT ASSOC	
REVIEWED	
PLOTTED	
AREA	
AREA CHECKED	

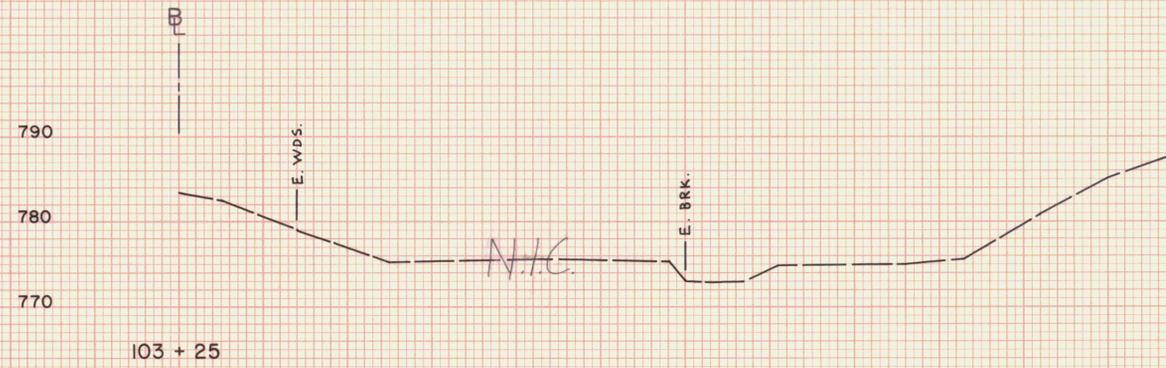

NOTE: ALL CONSTRUCTION NOTE STA. SHOULD BE REFERENCE 1 TO CHANNEL ☐, THEN PLOTTED 1 TO ☐ OF THE BROOK FOR LIMITS.

KING BROOK - BR-100	
STA. 102+75	STA. 103+50
TOWN MARSHFIELD	
PROJECT FECC NO. FO28-3(28)	
SHEET 330 OF 352 SHEETS	
HORIZ. AND VERT. SCALE	
0	10
VT. SURVEY CONSULTANTS DATE 12/86	