

CONSTRUCT TEMPORARY DRIVE

SURV. Φ STA. 202+62, LT. (40' WIDE)
 SURV. Φ STA. 202+80, RT. (20' WIDE)

BREAKAWAY CABLE TERMINAL

DETOUR Φ STA. 111+25 - 111+50 LT.
 DETOUR Φ STA. 111+50 - 111+75 RT.
 DETOUR Φ STA. 114+25 - 114+50 RT.
 DETOUR Φ STA. 114+50 - 114+75 LT.

STEEL BEAM GUARD RAIL

DETOUR Φ STA. 111+50 - 114+50 LT.
 DETOUR Φ STA. 111+75 - 114+25 RT.

REMOVAL OF EXISTING PAVEMENT MARKINGS

SURV. Φ STA. 202+00 ~ 203+75 (Φ) (EDGE LINES)
 SURV. Φ STA. 206+65 ~ 208+50 (Φ) (EDGE LINES)

TEMPORARY 4" YELLOW LINE (Φ) (SOLID DOUBLE)

DETOUR Φ STA. 110+00 ~ 116+58

TEMPORARY 4" WHITE LINE (EDGE LINE)

DETOUR Φ STA. 110+00 ~ 116+58

PUB. NO.	STATE	FED. AID PROJ. NO.	FISCAL YEAR	SHEET NO.	TOTAL SHEETS
1	VT		19		



SURVEY CURVE DATA #11	REV. CURVE DATA #11
$\Delta = 21^\circ 59' 16''$ LT	$\Delta = 23^\circ 15' 11''$ LT
D = 3° 00' 00"	D = 4° 00' 00"
R = 1909.86'	R = 1432.39'
T = 371.03'	T = 294.72'
L = 732.93'	L = 581.33'
E = 35.71'	E = 30.01'
	BANK = 0.063 FT/FT

SURV. Φ STA. 216+50, LT.



(N)

SURV. Φ STA. 192+65 RT. ~ 201+42 LT.
 ELEC. SERVICE TO CAUTION LIGHT TO BE MAINTAINED AT ALL TIMES BY CONTRACTOR

SURV. Φ STA. 194+75, RT.



(N)

SURV. Φ STA. 198+75, RT.



(N)

DETOUR POT. STA. 110+00 =
 SURV. Φ STA. 202+00, 45' LT.
 BEGIN DETOUR CONSTRUCTION

SURV. Φ STA. 203+60, RT.



(N)

(MOUNTED ON TYPE III BARRICADE)

SURV. Φ STA. 206+75, LT.



(N)

(MOUNTED ON TYPE III BARRICADE)

SURV. Φ STA. 201+42 ~ 208+50 LT.
 ELEC. SERVICE TO CAUTION LIGHT TO BE MAINTAINED AT ALL TIMES BY CONTRACTOR

SURV. Φ STA. 211+25, LT.



(N)

SURV. Φ STA. 208+50, 19' RT. =
 DETOUR PCC 116+58
 END DETOUR CONSTRUCTION


REVISED
 PI # 11 207+59.05 =
 207+50.94
 $\Delta = 23^\circ 15' 11''$ LT.

SURVEY
 PI # 11 207+40.67 =
 207+31.54
 $\Delta = 21^\circ 59' 16''$ LT.

TBM # 32
 CHIS IN TOP OF BLDG.
 NGVD EL. 815.80

LEGEND

- TEMPORARY CONCRETE TRAFFIC BARRIER (OPTIONAL)
 - REFLECTORIZED PLASTIC DRUM (30' SPACING TYPICAL) (EXCEPT AT ENDS OF TEMPORARY TRAFFIC BARRIERS)
 - o DELINEATORS (40' SPACING TYPICAL)
 - TYPE III BARRICADE
- REFER TO STDS. E-101 AND E-102 FOR CONSTRUCTION SIGN DETAILS

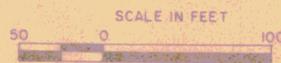

DETOUR 'D'
CATTLE PASS

VT. SURVEY
 SURVEYED BY CONSULTANTS DATE 3/87
 DRAWN BY BRYANT ASSOC. DATE 6/87
 TRACED BY _____ DATE _____
 U.S. ROUTE 2 - MARSHFIELD
 PROJ. FECC NO. F 028-3(28)
 SHEET 1 OF 6 358A