
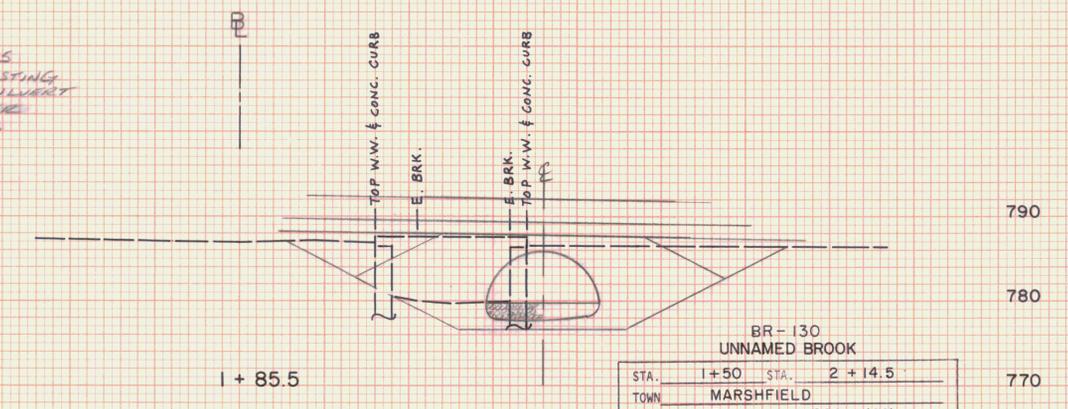
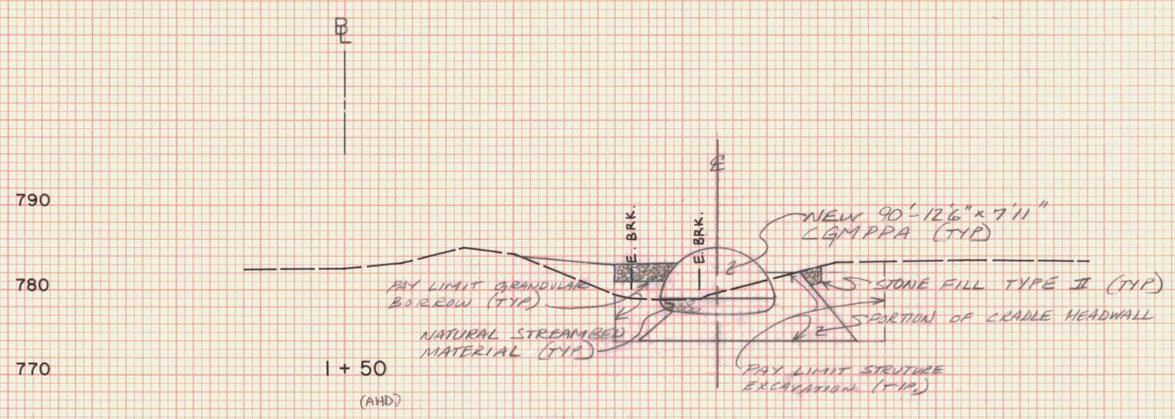
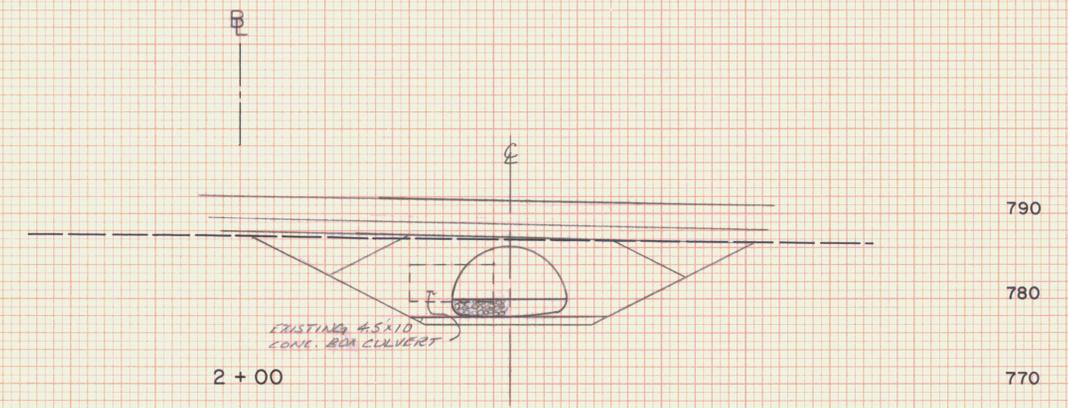
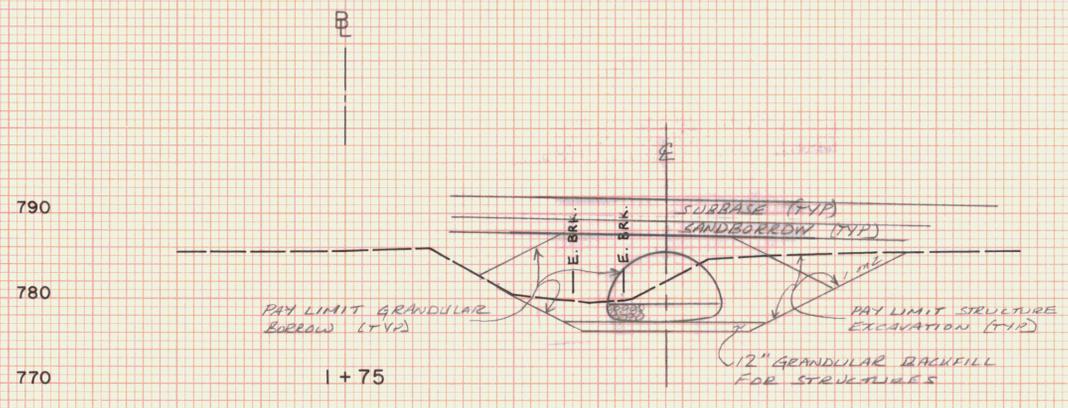
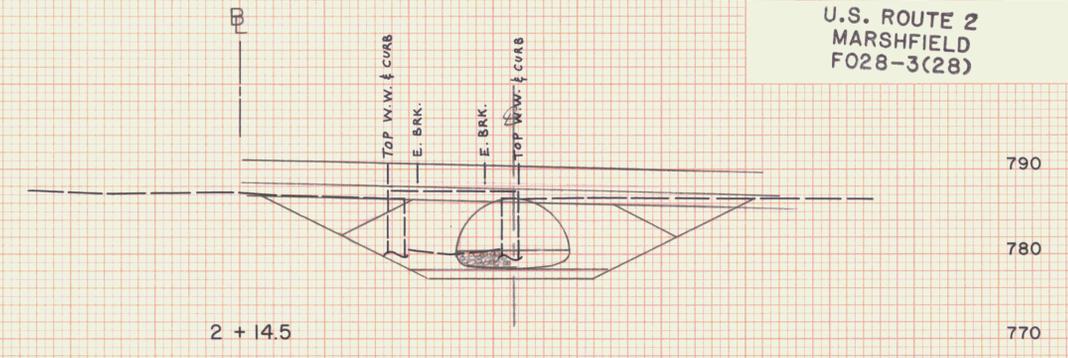


UNNAMED BROOK  
CHANNEL SECTIONS  
 @ STA. 296+49.40=  
 (NEW 12'-6" x 7'-11" C.G.M.P.P.A.  
 STA. 296+55, ASKEWED 79° 00' RT.)

U.S. ROUTE 2  
MARSHFIELD  
F028-3(28)

DATE: \_\_\_\_\_  
 BY: \_\_\_\_\_  
 SURVEYED: \_\_\_\_\_  
 PLOTTED: \_\_\_\_\_  
 TEMPLATE: \_\_\_\_\_  
 AREA CHECKED: \_\_\_\_\_  
 FINAL SURVEY NOTE BOOK No. \_\_\_\_\_

DATE: 12/86  
 BY: VT SURVEY CONSULTANTS BRYANT ASSOC.  
 SURVEYED: \_\_\_\_\_  
 PLOTTED: \_\_\_\_\_  
 TEMPLATE: \_\_\_\_\_  
 AREA CHECKED: \_\_\_\_\_  
 ORIGINAL SURVEY NOTE BOOK No. \_\_\_\_\_

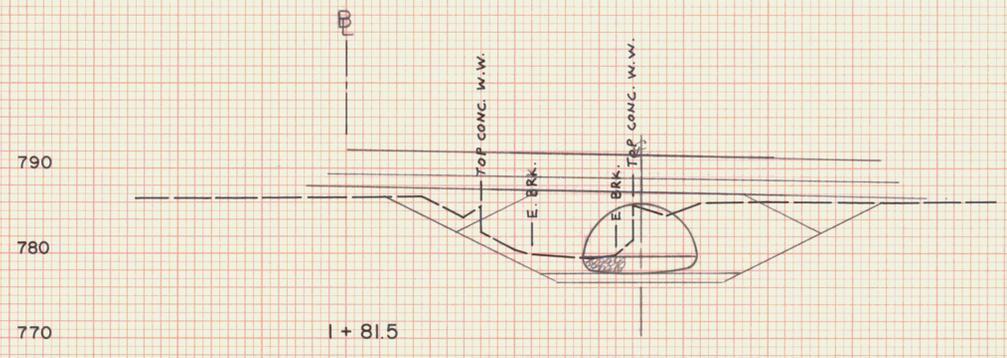

CHANNEL @ STA. 1+85  
 BEGIN REMOVAL OF EXISTING  
 4.5' x 10' CONC. BOX CULVERT  
 TO BE PAID FOR UNDER  
 SOLID ROCK EXCAVATION.

NOTE: ALL CONSTRUCTION NOTE STA. SHOULD BE  
 REFERENCED L TO CHANNEL @, THEN PLOTTED  
 L TO @ OF BROOK FOR LIMITS.

BR-130 UNNAMED BROOK	
STA. 1+50	STA. 2+14.5
TOWN MARSHFIELD	
PROJECT F	NO. 028-3(28)
SHEET 350	OF 352 SHEETS
HORIZ. AND VERT. SCALE 0 10 20	
SURVEYED BY: VT SURVEY CONSULTANTS DATE 12/86	