

**INDEX**

- 1- TITLE SHEET
- 2- TYPICAL SECTION
- 3-4- QUANTITY SHEETS
- 5- ITEM DETAIL AND DRAINAGE SHEET
- 6- EARTHWORKS SHEET
- 7- PLAN SHEET
- 8- PROFILE SHEET
- 9-10 - CATTLEPASS PRELIMINARY INFORMATION SHEETS
- 11-16 U.S. ROUTE 2 CROSS SECTIONS
- 17-22 DETOUR DETAIL AND CROSS SECTIONS

# STATE OF VERMONT AGENCY OF TRANSPORTATION





## PROPOSED IMPROVEMENT TOWN OF MARSHFIELD COUNTY OF WASHINGTON U.S. ROUTE 2 (F.A.P.) PRINCIPAL ARTERIAL HIGHWAY

BEGINNING AT A POINT ON U.S. ROUTE 2 APPROXIMATELY 0.64 MILES  
NORTHEAST OF THE PLAINFIELD - MARSHFIELD TOWN LINE AND EXTENDING IN  
AN NORTHEASTERLY DIRECTION APPROXIMATELY 4.943 MILES.

LENGTH OF ROADWAY 29,101.02 FEET OR 4.943 MILES  
LENGTH OF PROJECT 23,101.02 FEET OR 4.943 MILES

PROJECT INVOLVES RECONSTRUCTION AND WIDENING OF A  
PORTION OF U.S. ROUTE 2, INCLUDING GRADING; DRAINAGE,  
SUBBASE, PAVEMENT AND RELATED WORK.

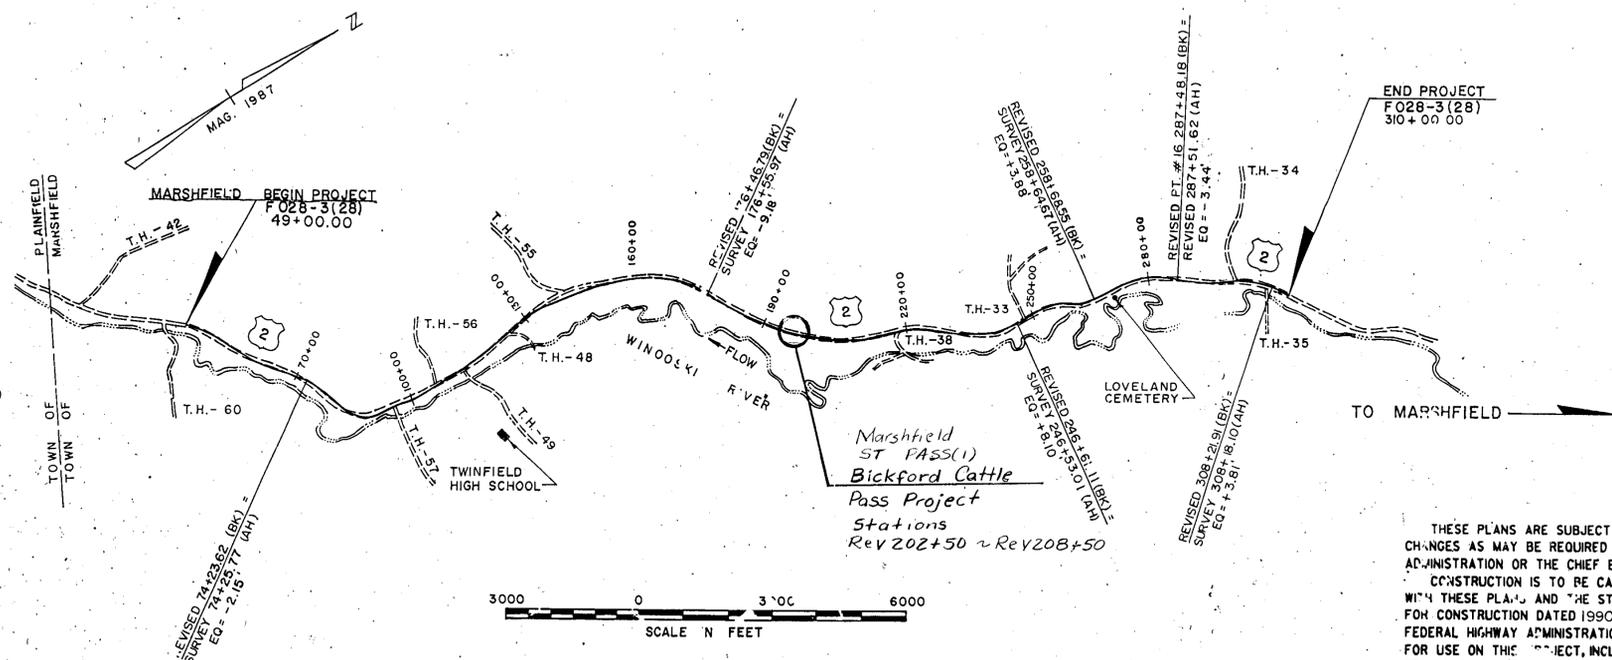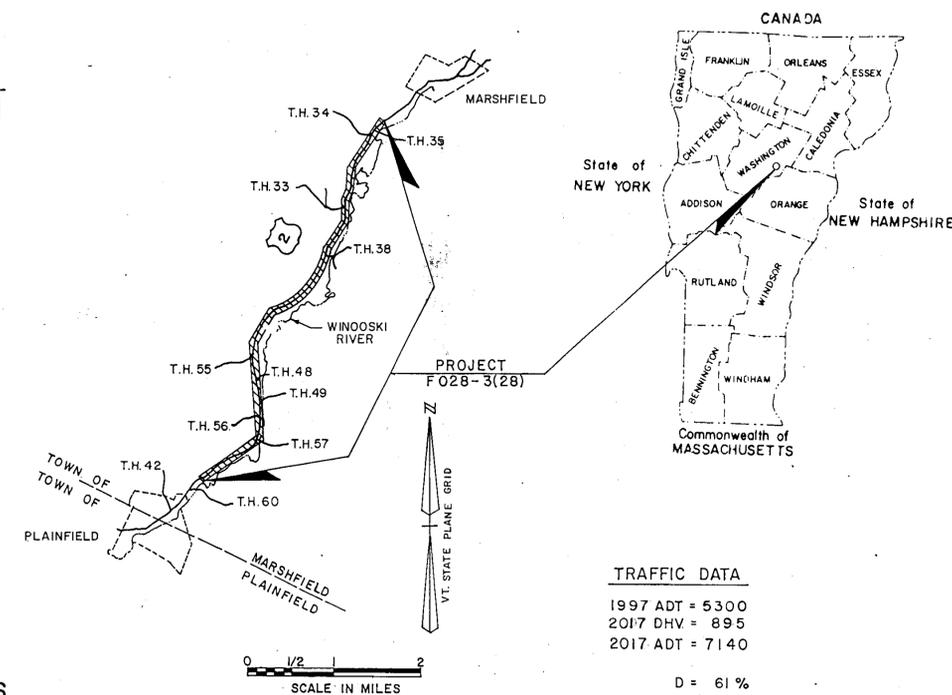

**CONVENTIONAL SIGNS**

COUNTY LINE	---
TOWN LINE	---
LIMITS OF ACCESS	○—○
POINT OF ACCESS	X
FENCE LINE	—X—X—
STONE WALL	—X—X—
TRAVELED WAY	—X—X—
GUARD RAIL	—X—X—
RAILROAD	—X—X—
SURVEY LINE	—X—X—
CULVERT	—X—X—
POWER POLE	—X—X—
TELEPHONE POLE	—X—X—
TREES	—X—X—
CONTROL OF ACCESS	—X—X—
PROPERTY LINE	—X—X—
R.O.W TAKING LINE	—X—X—
SLOPE RIGHTS	—X—X—
TOP OF CUT.	—X—X—
TOE OF SLOPE	—X—X—

**DATUM**

VERTICAL	NGVD-1929
HORIZONTAL	N/A

THESE PLANS ARE SUBJECT TO SUCH ENGINEERING CHANGES AS MAY BE REQUIRED BY THE FEDERAL HIGHWAY ADMINISTRATION OR THE CHIEF ENGINEER. CONSTRUCTION IS TO BE CARRIED ON IN ACCORDANCE WITH THESE PLANS AND THE STANDARD SPECIFICATIONS FOR CONSTRUCTION DATED 1990 AS APPROVED BY THE FEDERAL HIGHWAY ADMINISTRATION ON MARCH 15, 1990 FOR USE ON THIS PROJECT, INCLUDING ALL SUBSEQUENT REVISIONS AND SUCH REVISED SPECIFICATIONS AND SPECIAL PROVISIONS AS ARE INCORPORATED IN THESE PLANS.

SUBMITTED BY ORDER OF THE STATE TRANSPORTATION BOARD	
APPROVED _____	DATE _____
DIRECTOR OF ENGINEERING	
DEPARTMENT OF TRANSPORTATION FEDERAL HIGHWAY ADMINISTRATION	
APPROVED _____	DATE _____
DIVISION ADMINISTRATOR	
PROJECT NO. <i>Marshfield ST PASS(1) Cattlepass Project</i>	
SHEET 1 OF 22 SHEETS	