

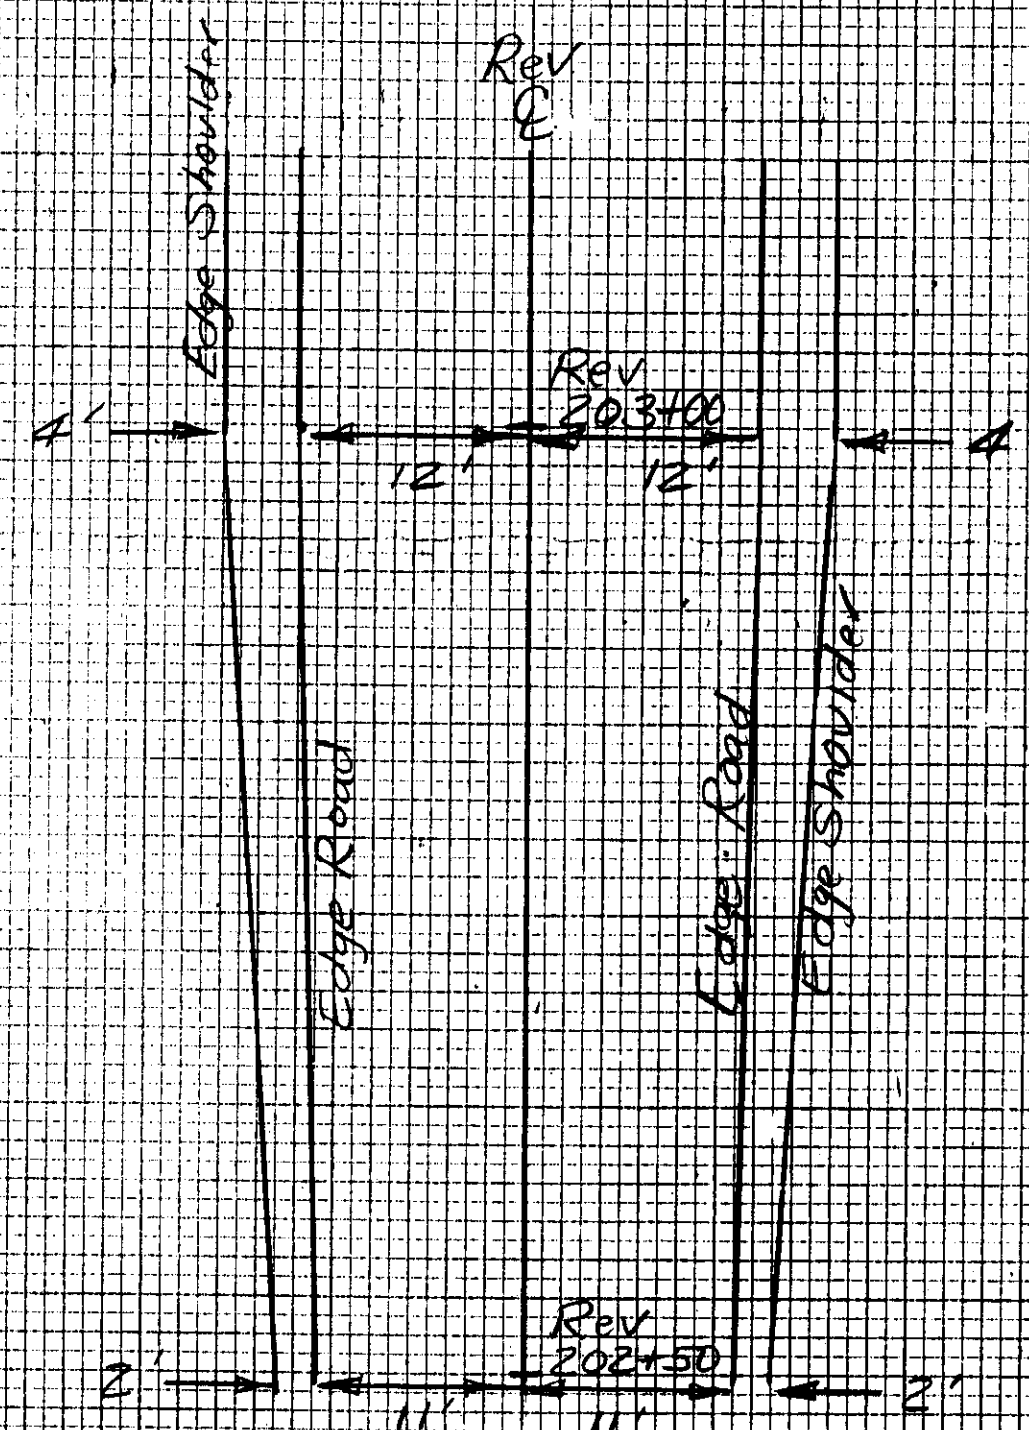
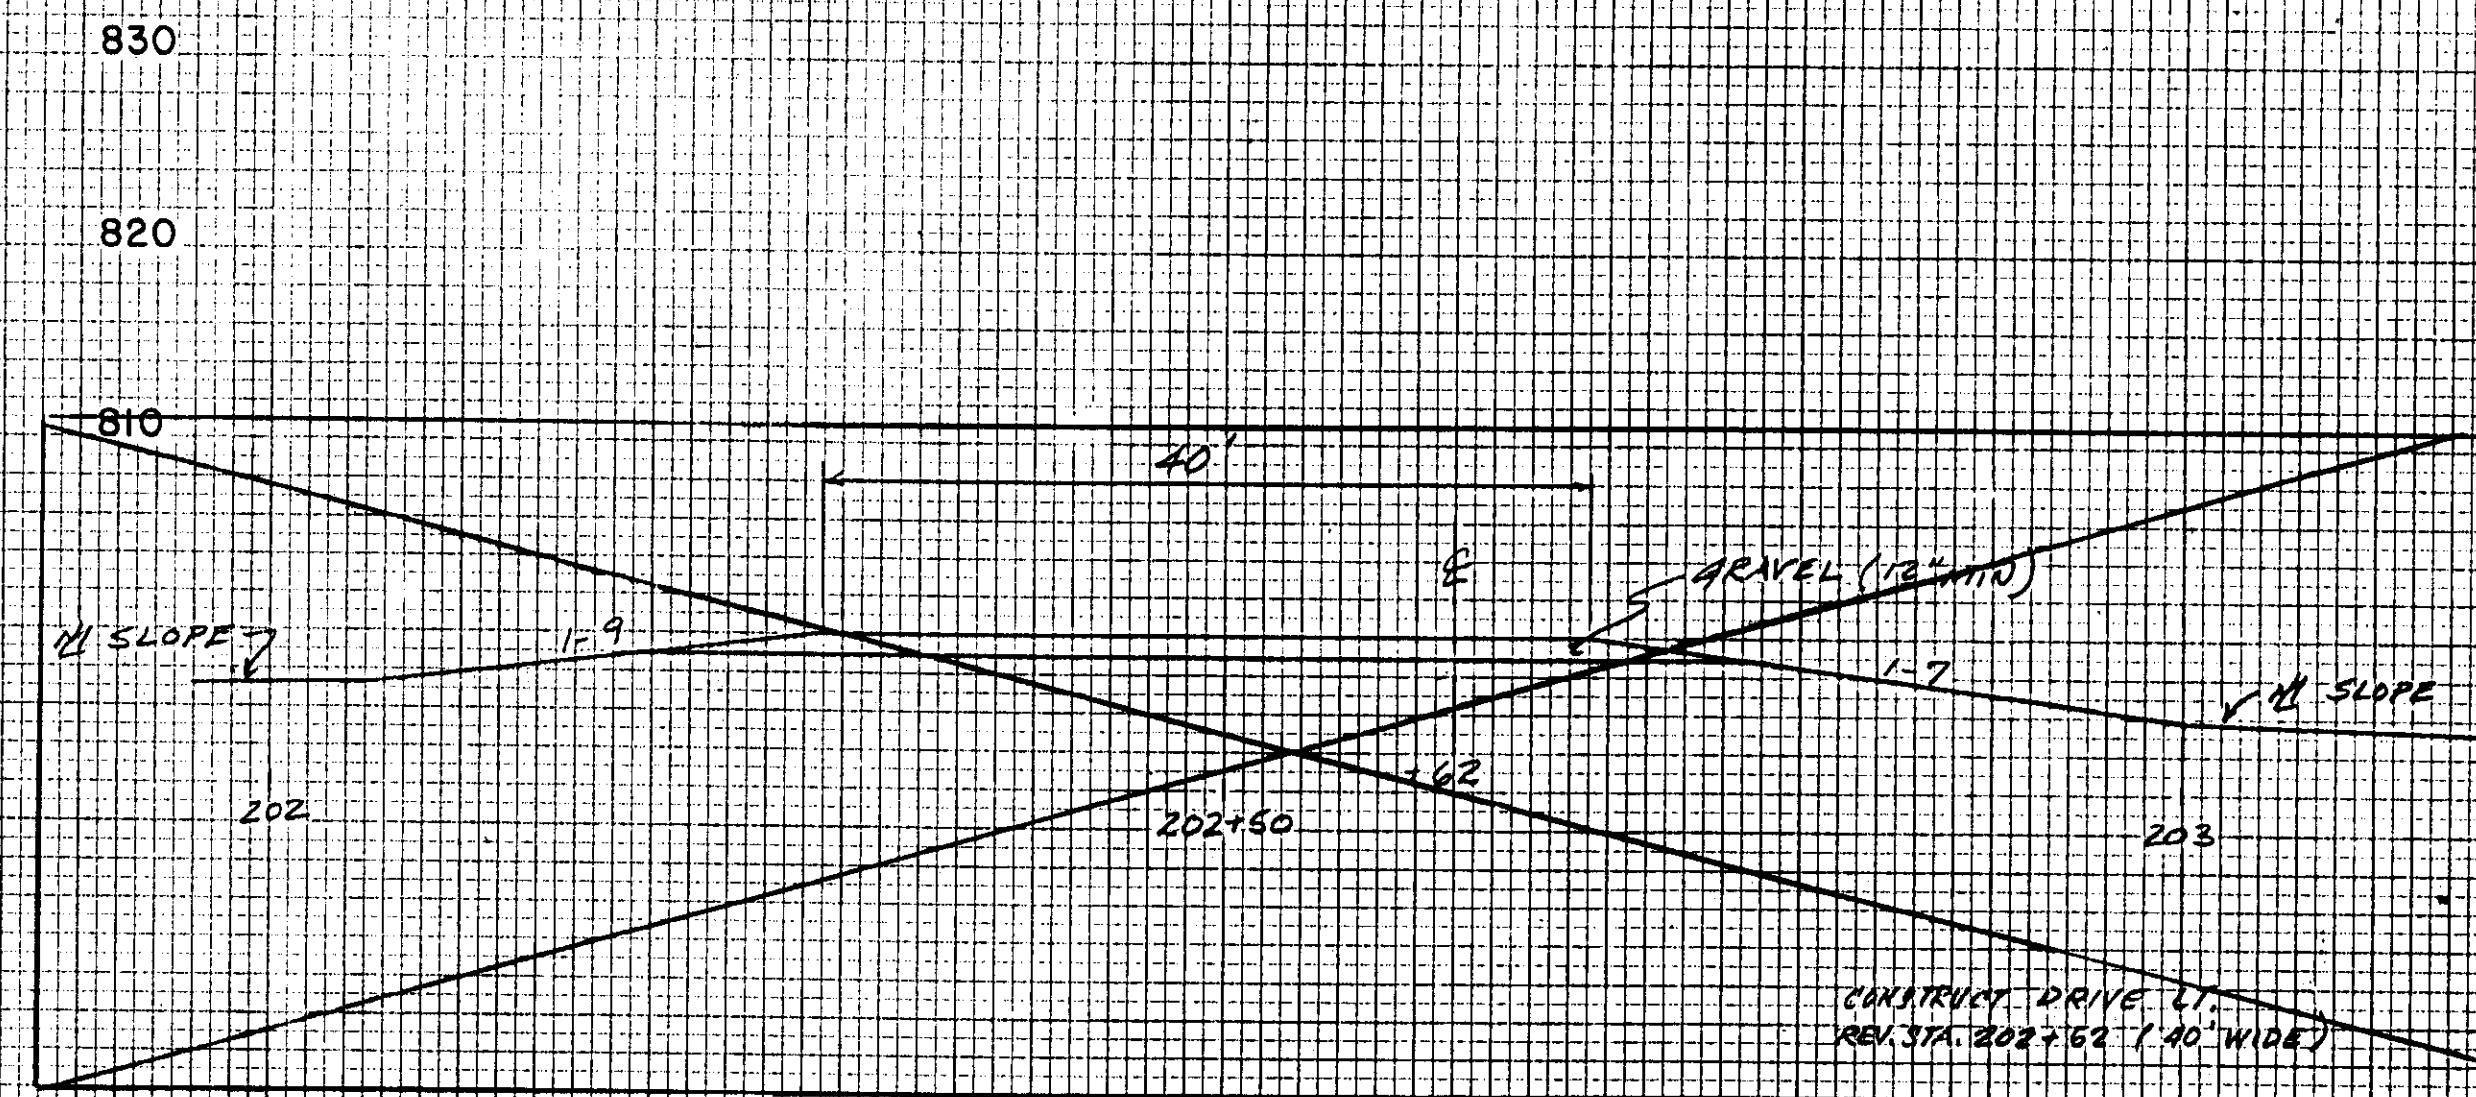
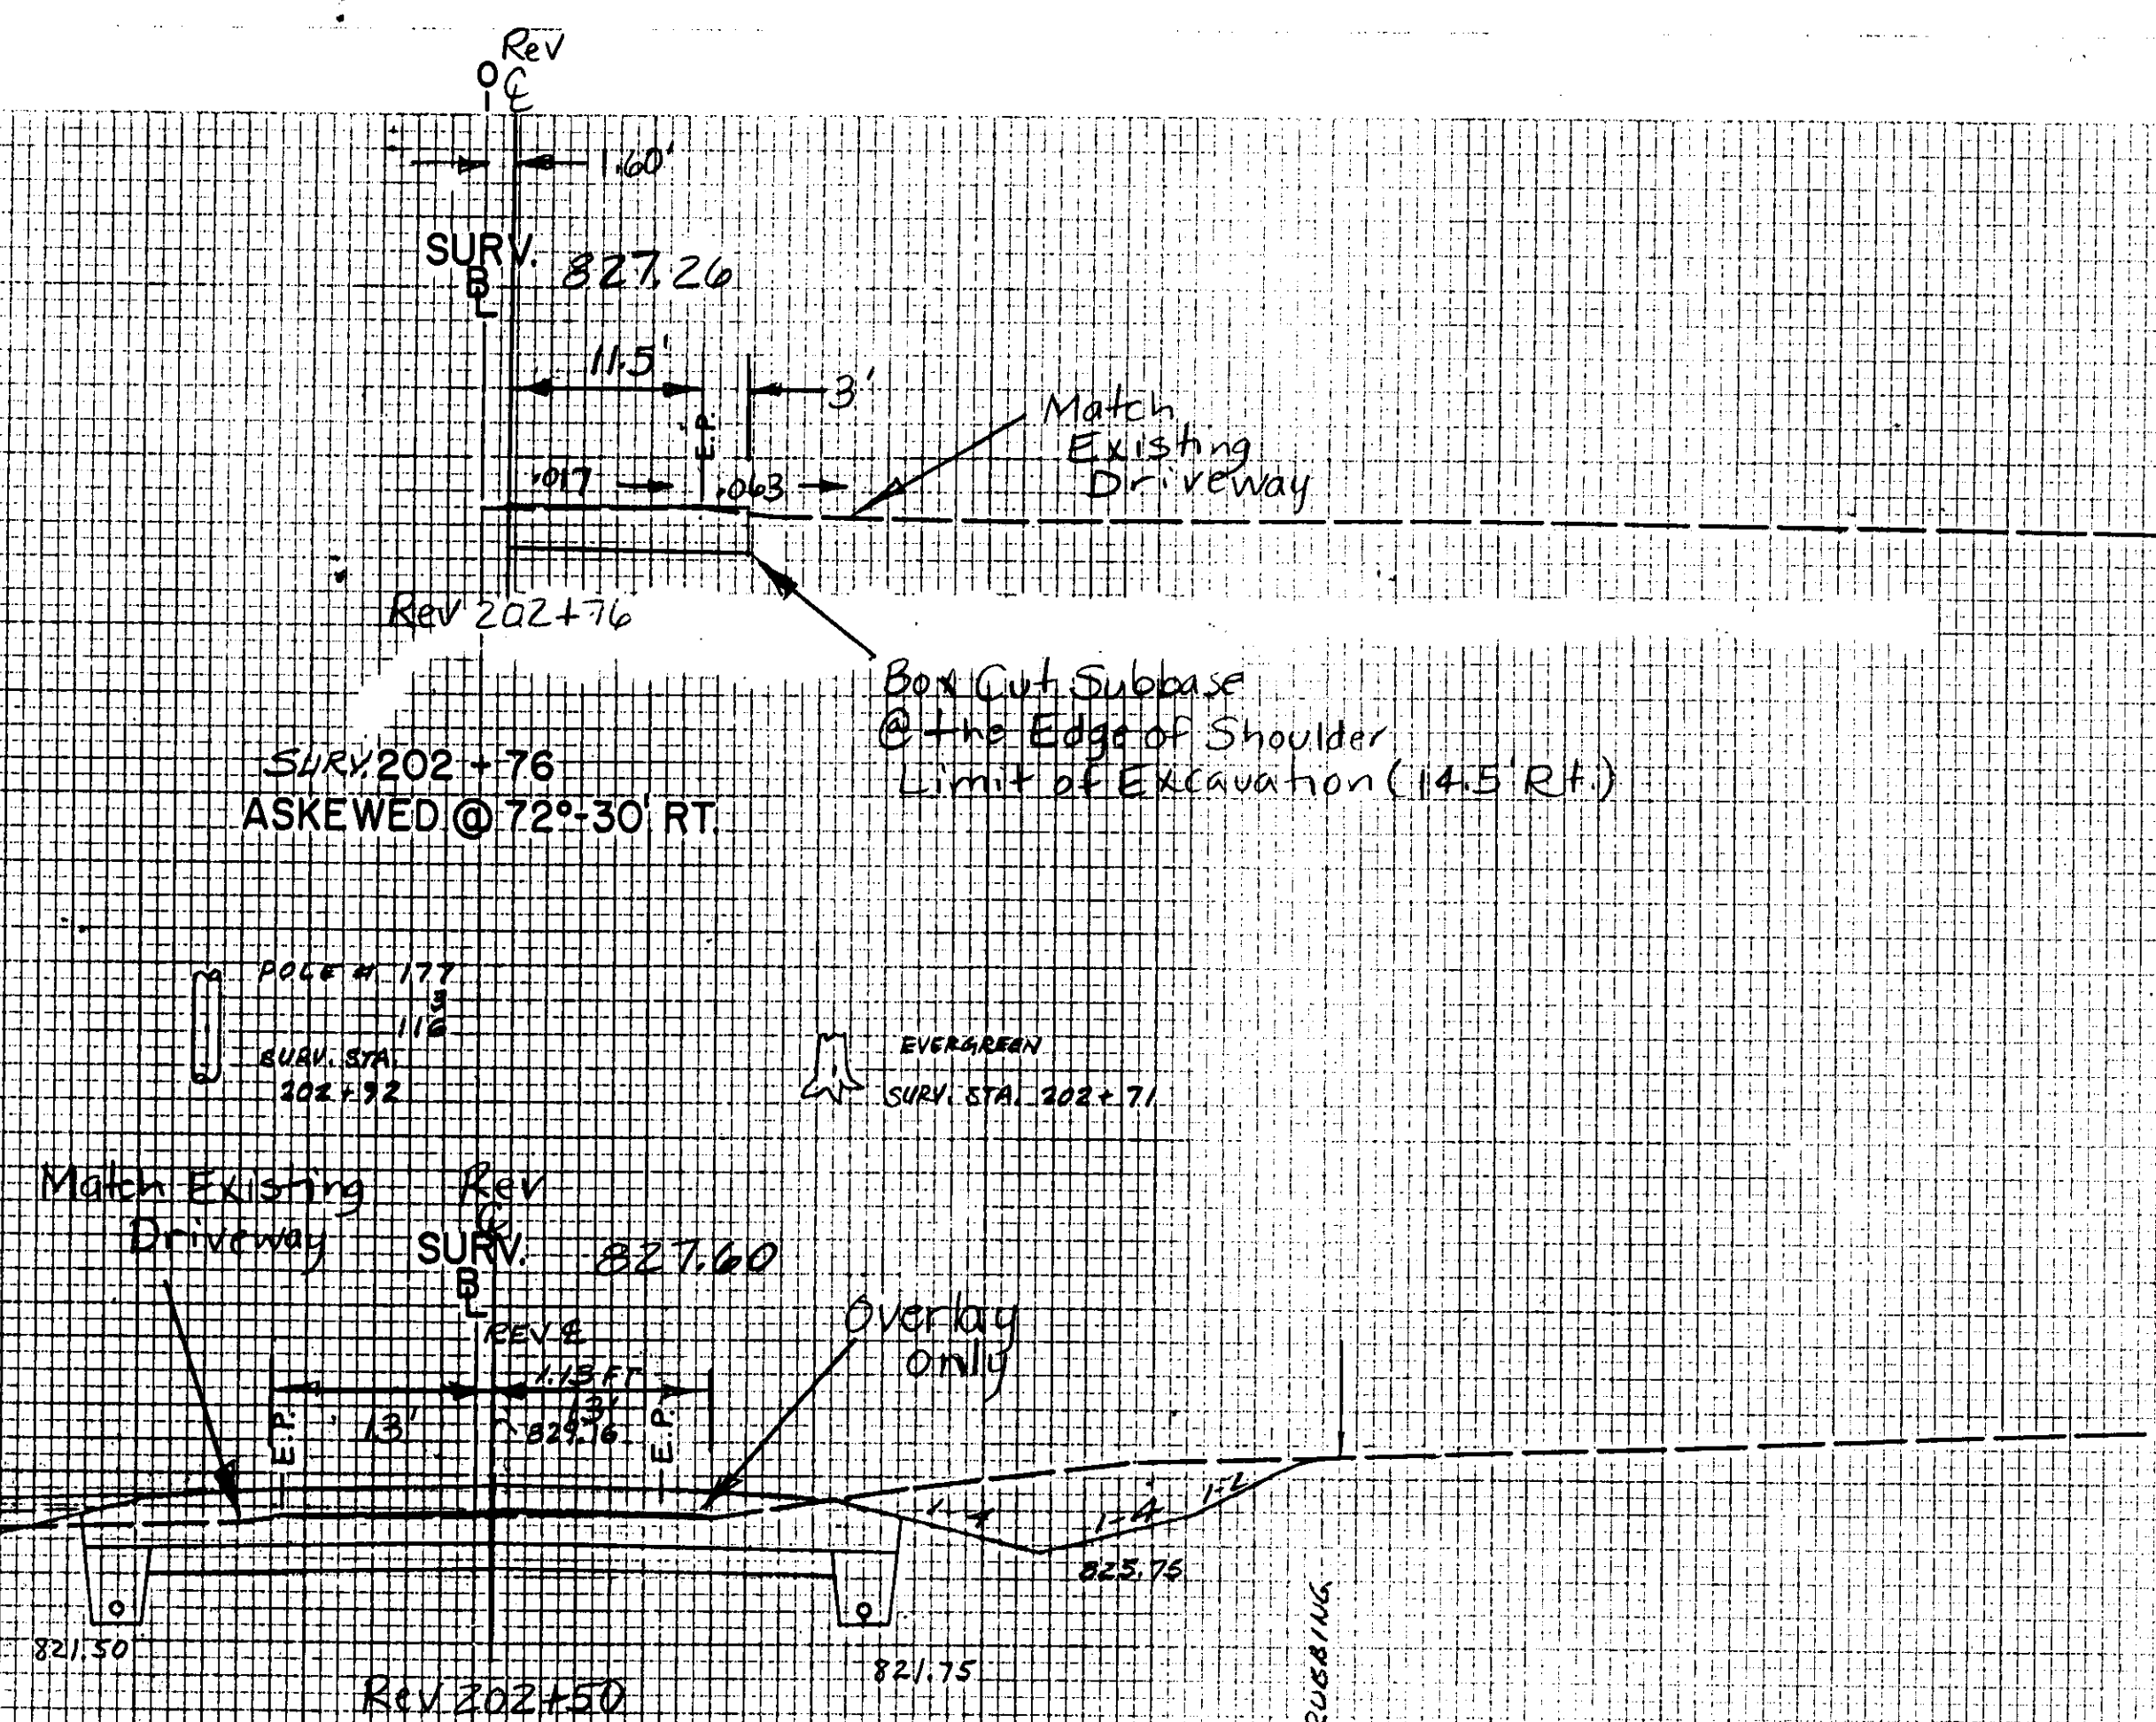
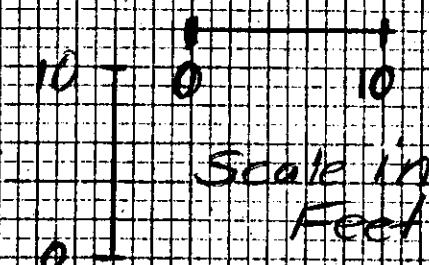
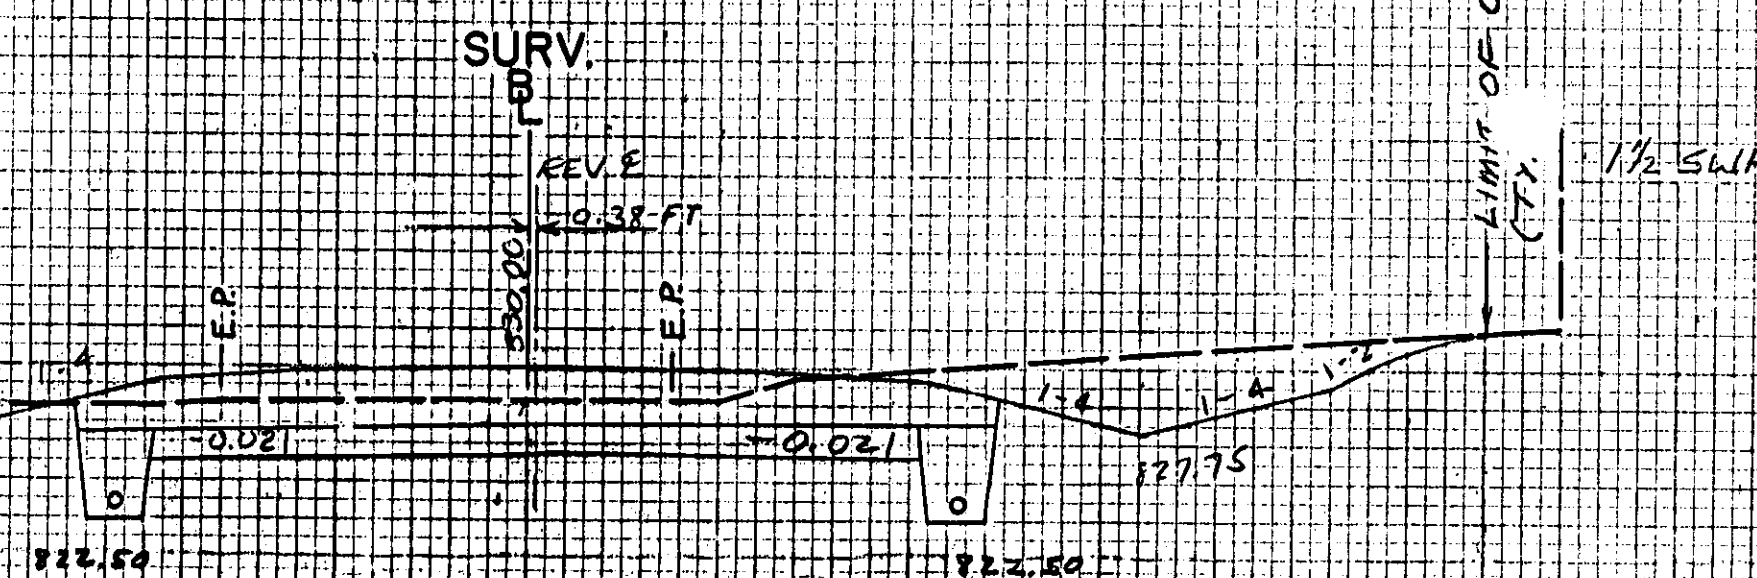


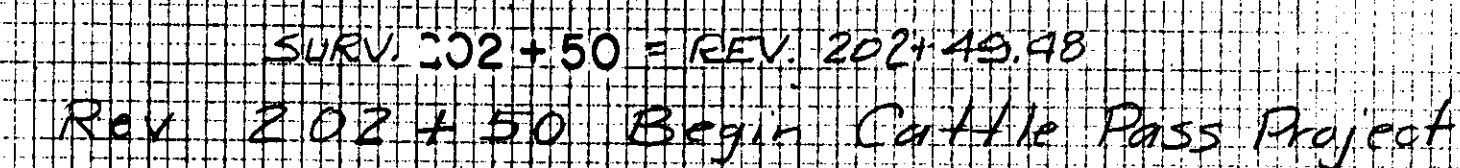

Shoulder/Roadway Transition Detail


$$\begin{aligned} C &= 162 \text{ Sq Ft} \\ F &= 0 \text{ Sq Ft} \\ R &= 0 \text{ Sq Ft} \end{aligned}$$


C = 164 Sq Fr
F = 0 Sq Fr
R = 0 Sq Ft

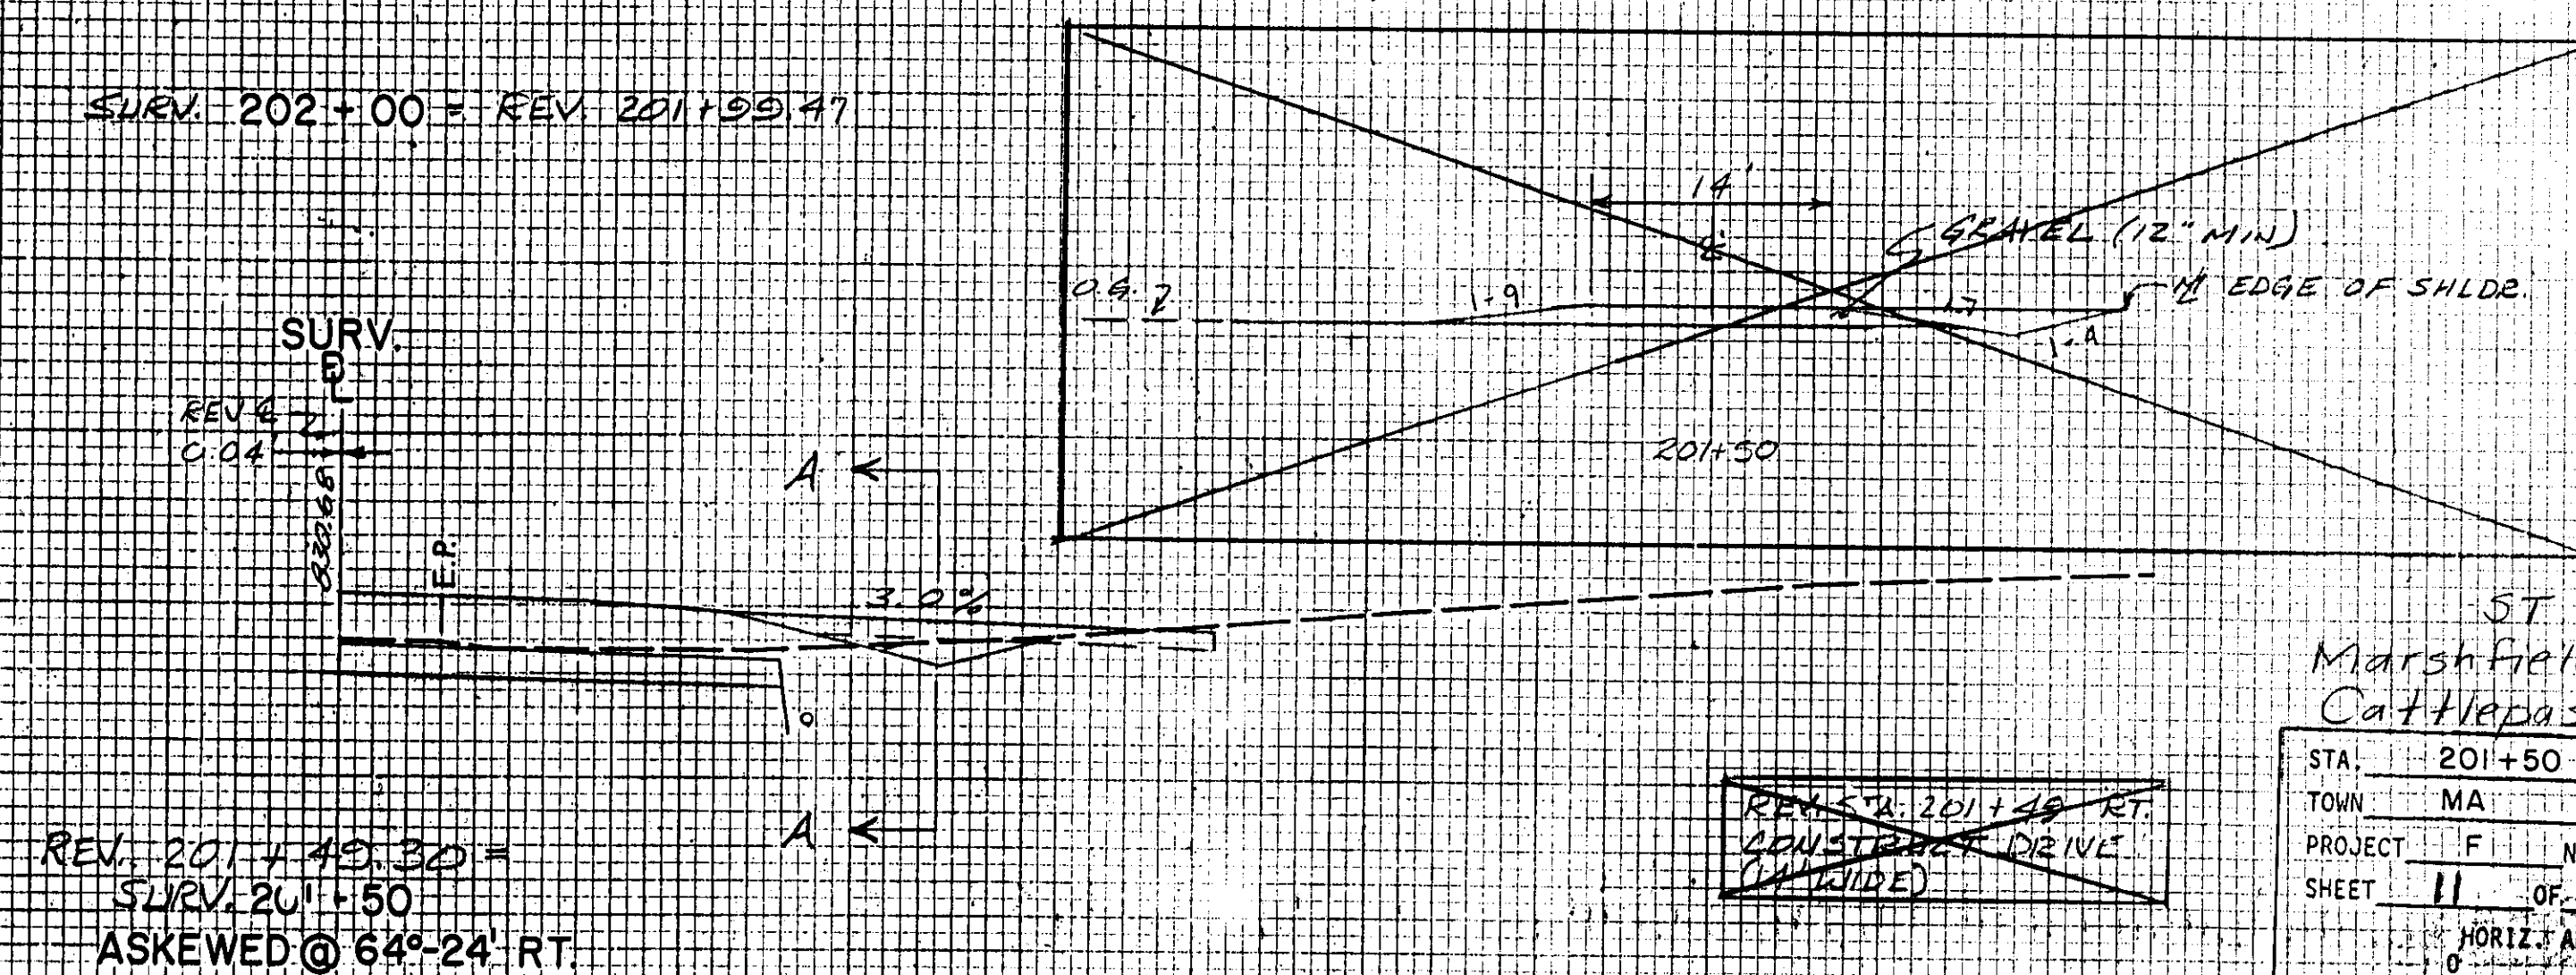

ST PASS(1)
Marshfield - Bickford
Cattlepass Project

STA. 201+50 STA. 202+76
TOWN MA
PROJECT NO. 028 3(28)
SHEET 11 OF 22 SHEETS
HORIZ. AND VERT. SCALE
0 10 20
VT. SURVEY
SURVEYED BY: CONSULTANTS DATE 10/86