


VT SURVEY CONSULTANTS
BRYANT ASSOC.
10/86
NO. 10/86

VT SURVEY CONSULTANTS
BRYANT ASSOC.
10/86
NO. 10/86

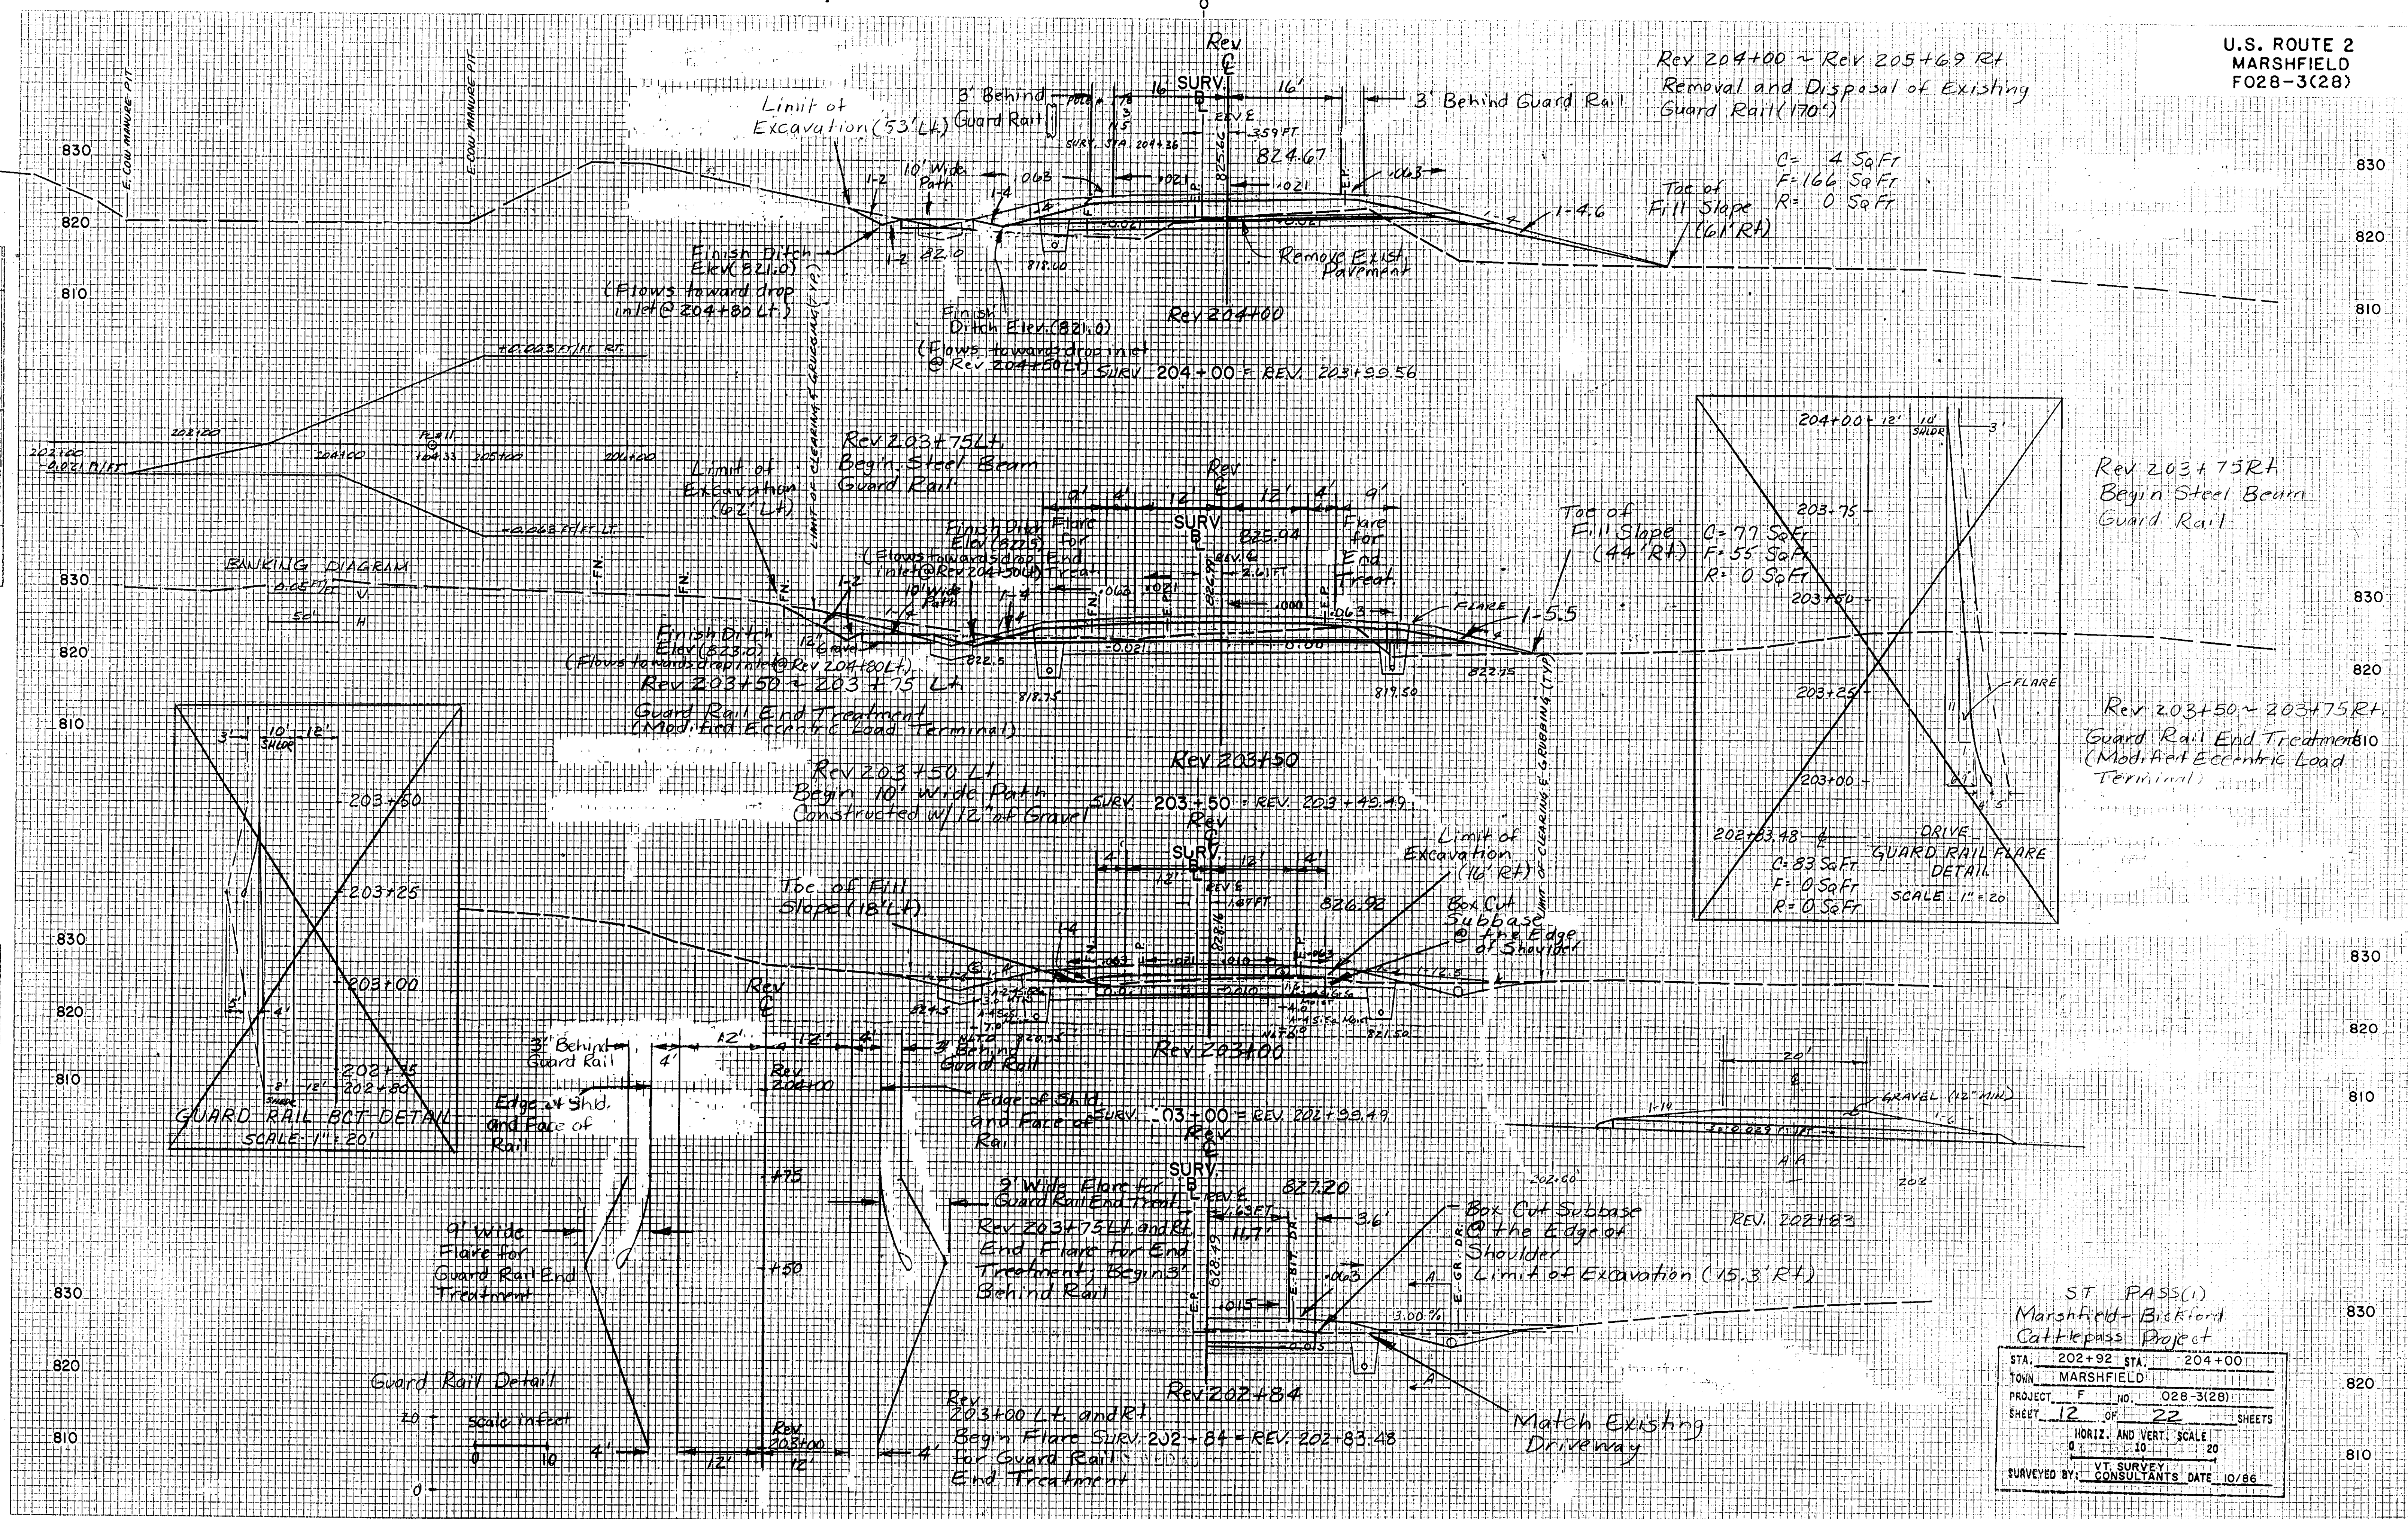

ST PASS(1)
Marshfield-Bickford
Cattlepass Project

STA.	202+92	STA.	204+00
TOWN	MARSHFIELD		
PROJECT	F	NO.	028-3(28)
SHEET	12	OF	22 SHEETS
HORIZ. AND VERT. SCALE 1" = 10' 10' = 20'			
SURVEYED BY: VT SURVEY CONSULTANTS DATE 10/86			