

DATE	10/86
BY	VT SURVEY CONSULTANTS
FOR	BRYANT ASSOC.
PROJECT	ST PASS (1)
NO.	1028-3(28)
DATE	10/86
BY	VT SURVEY CONSULTANTS
FOR	BRYANT ASSOC.
PROJECT	ST PASS (1)
NO.	1028-3(28)
810
800
790

810
800
790

810
800
790

810
800
790

800

810

800


790

810

810


800

800

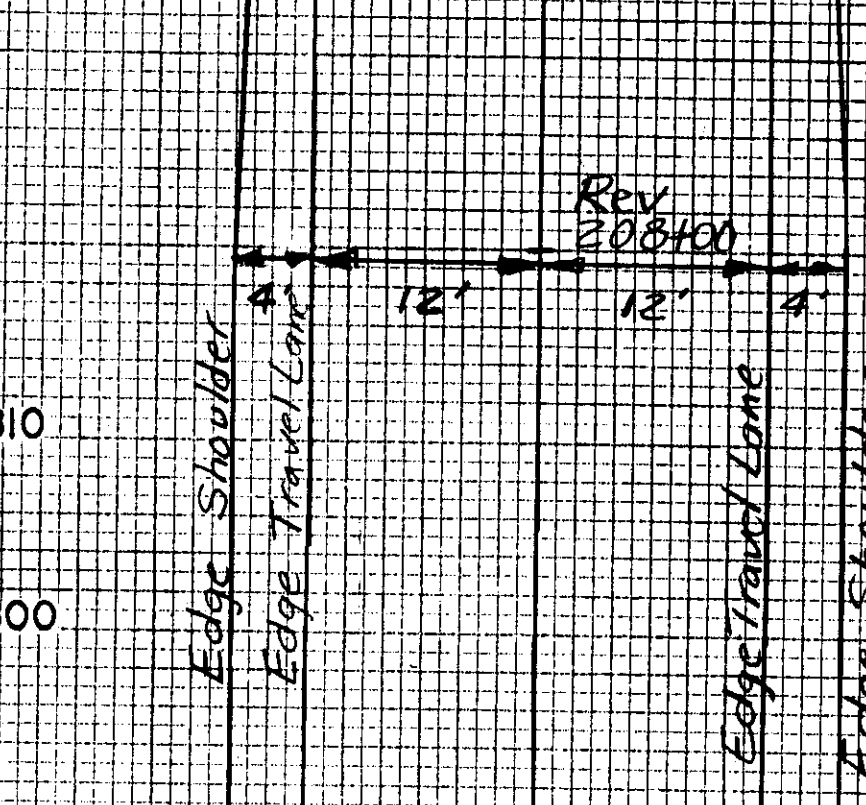


Shoulder/Roadway
Transition Detail


Scale in Feet

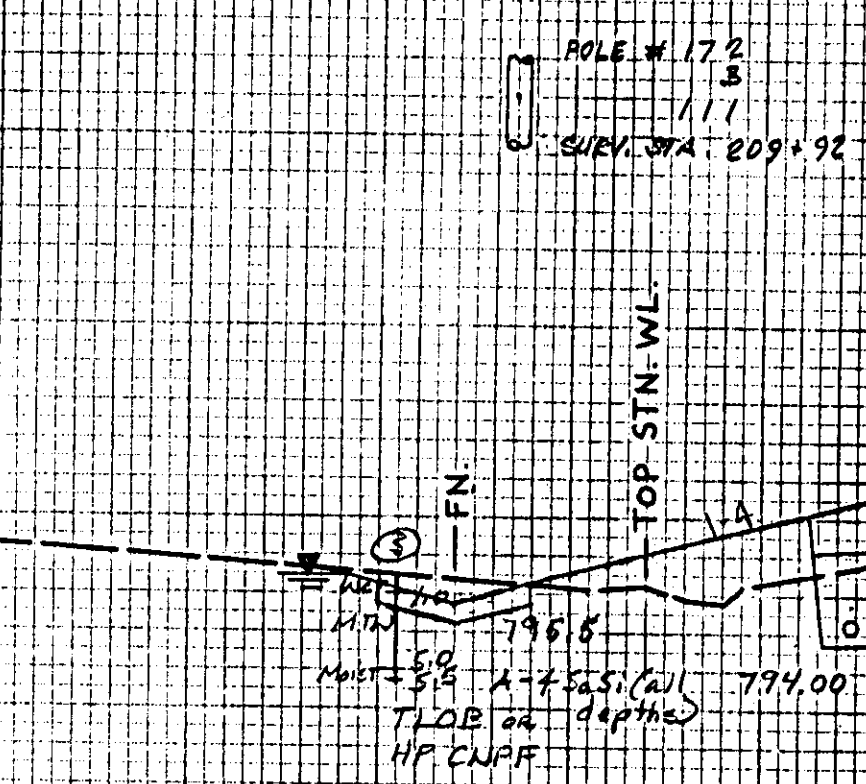


C = 32 Sq Ft
F = 34 Sq Ft
R = 0 Sq Ft

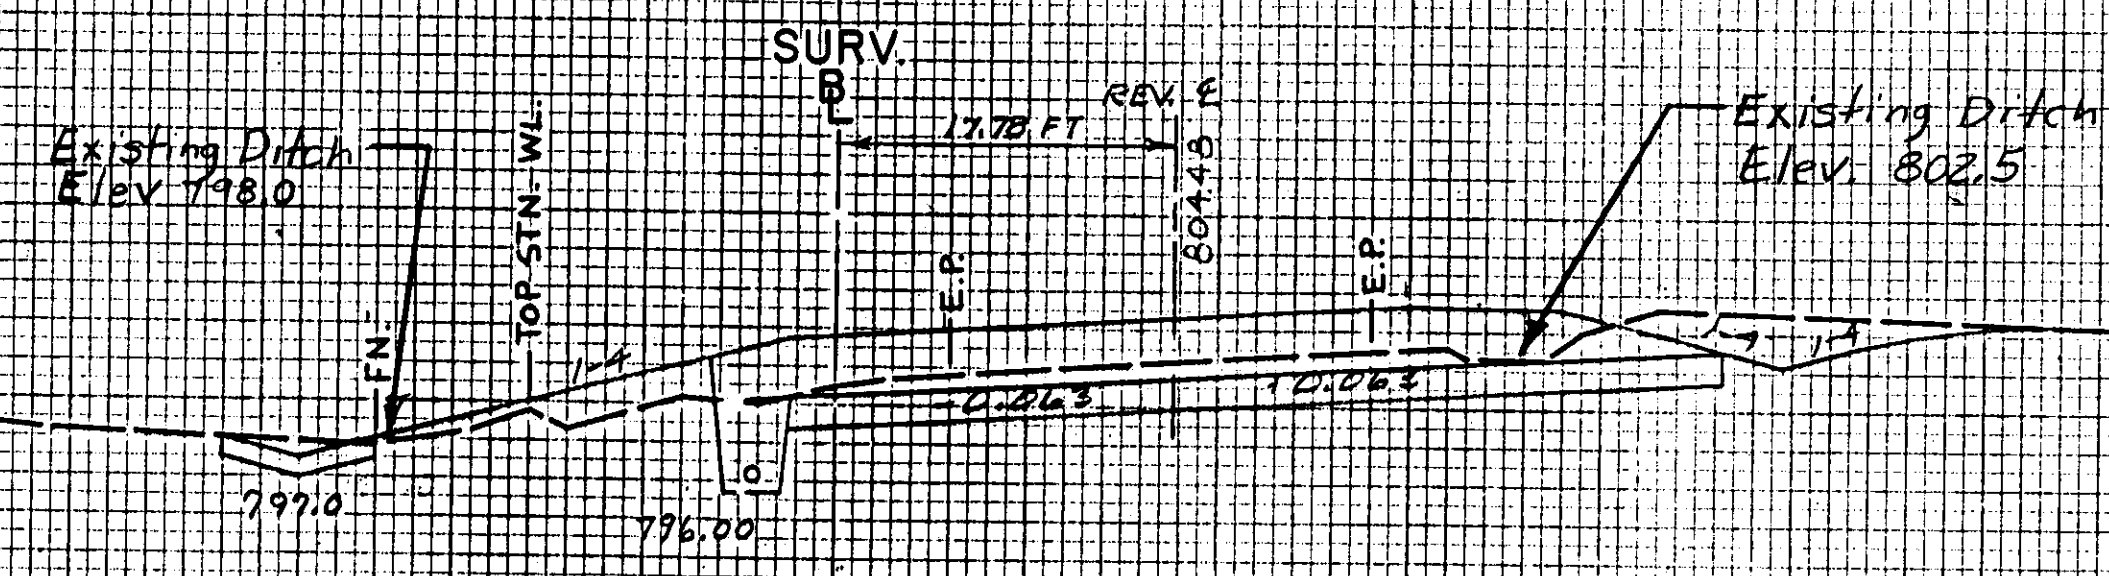

C = 65 Sq Ft
F = 23 Sq Ft
R = 0 Sq Ft

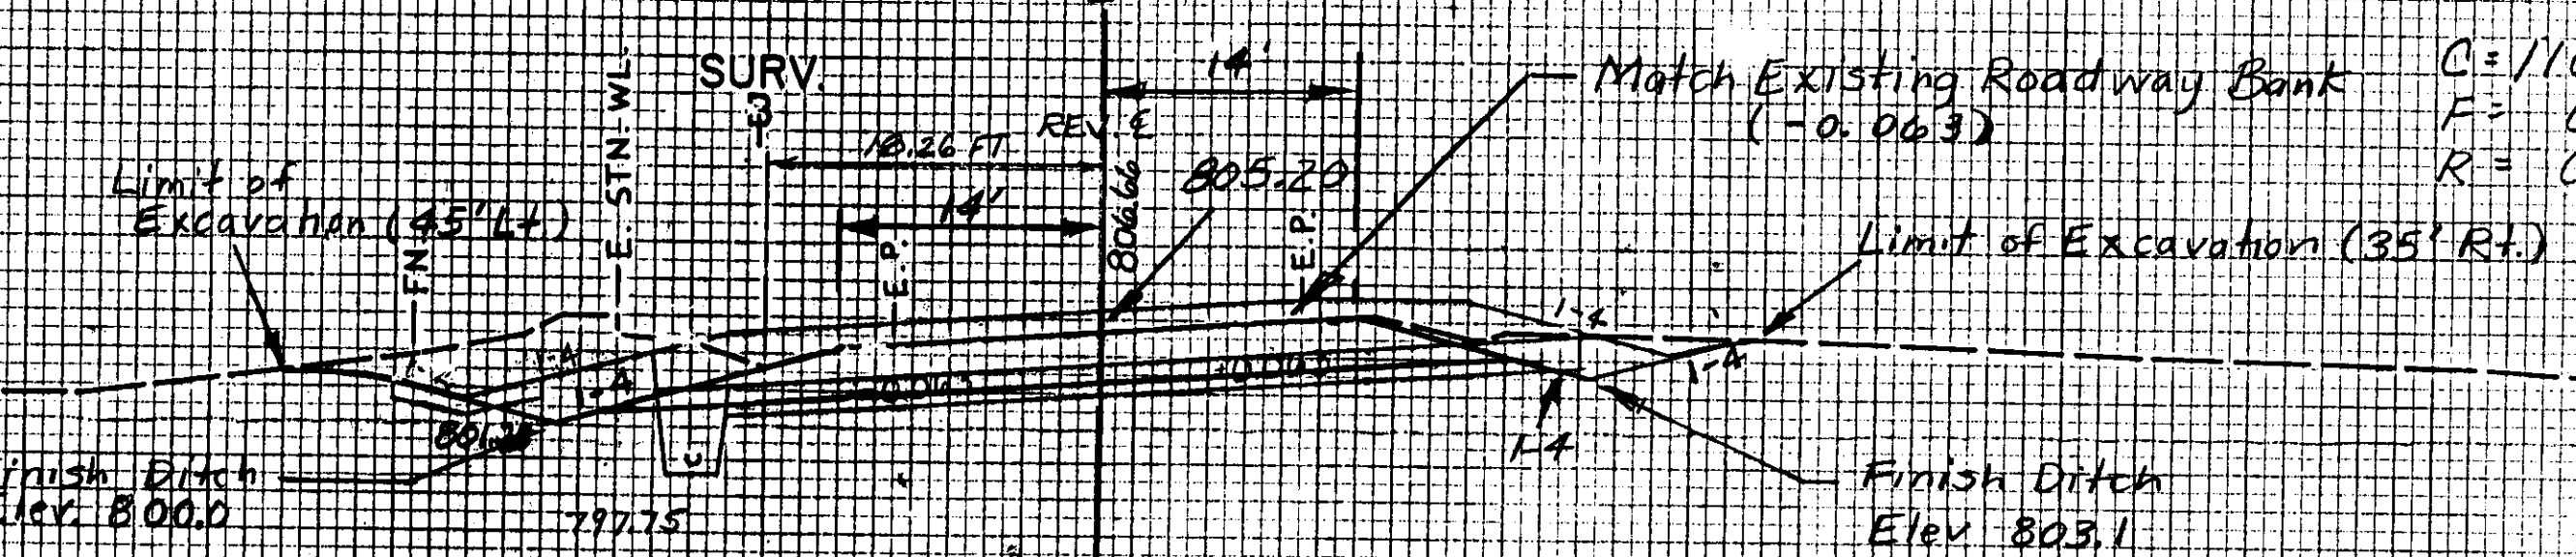

C = 110 Sq Ft
F = 0 Sq Ft
R = 0 Sq Ft

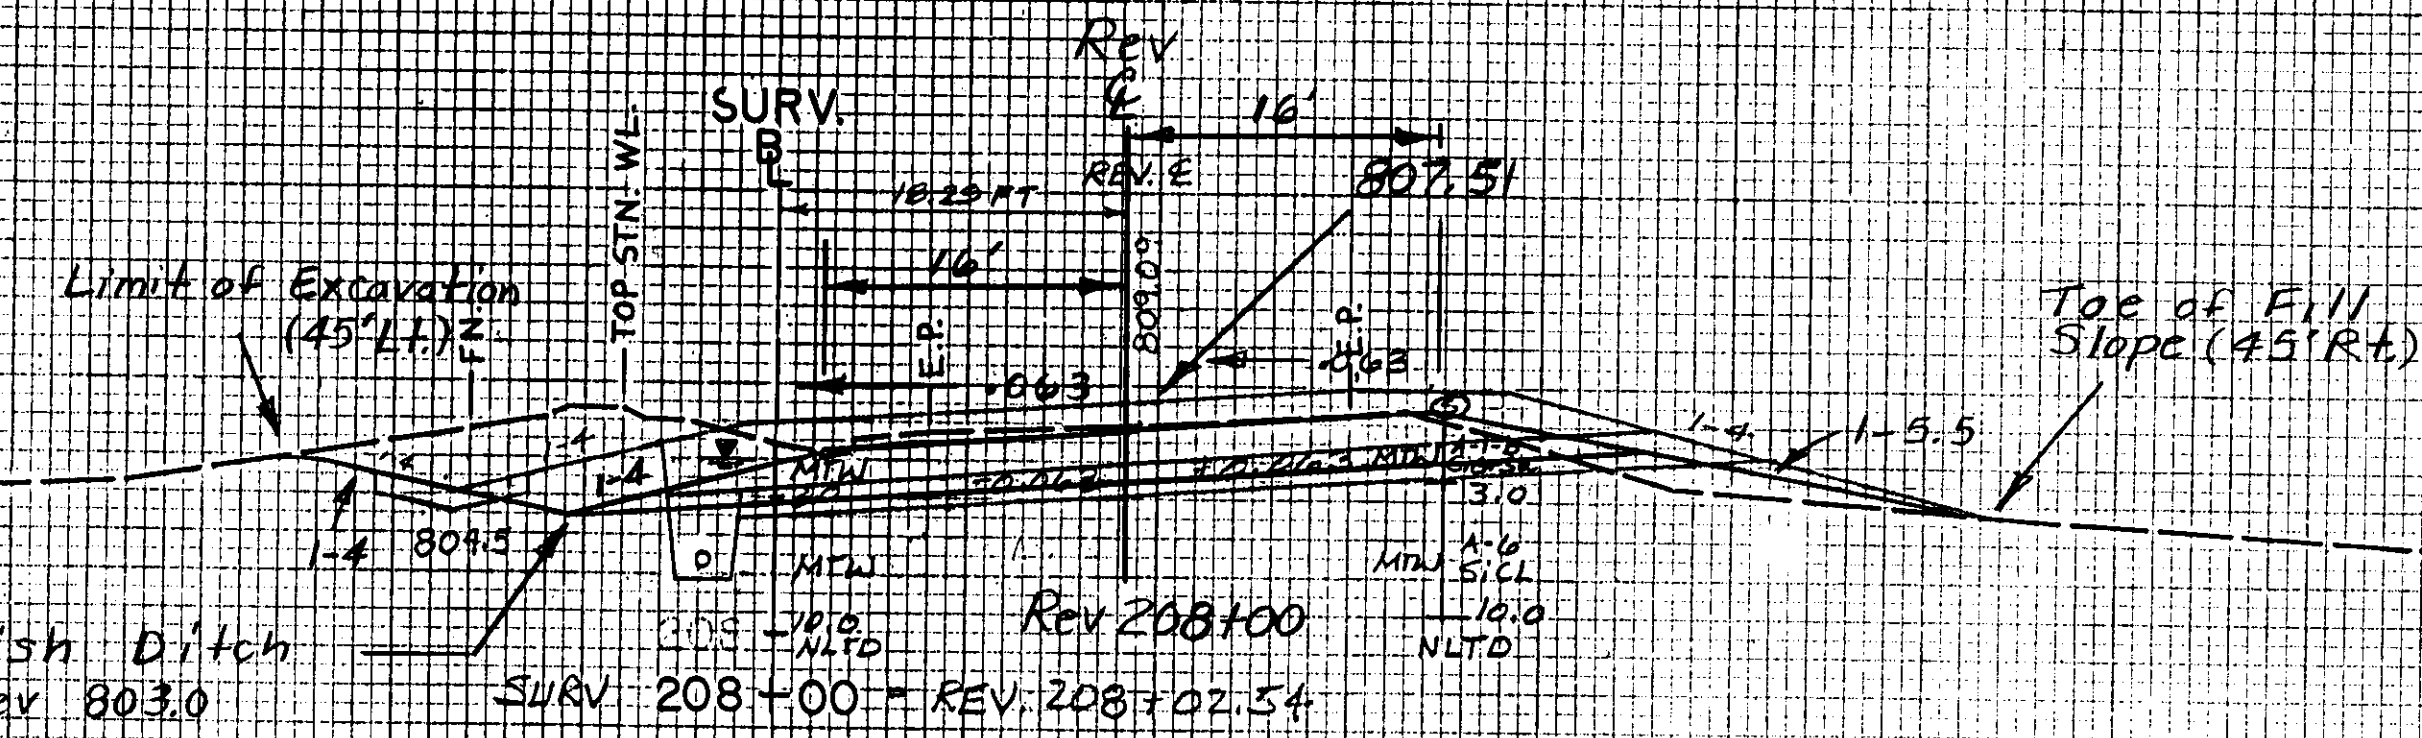

C = 130 Sq Ft
F = 26 Sq Ft
R = 0 Sq Ft

ST PASS (1)
Marshfield - Bickford
Cattlepass Project

STA. 208+00	STA. 209+50
TOWN	MARSHFIELD
PROJECT	F NO. 1028-3(28)
SHEET	10 OF 22 SHEETS
HORIZ. AND VERT. SCALE	
0 10 20	
VT SURVEY	
SURVEYED BY: CONSULTANTS DATE 10/86	