

CONSTRUCT TEMPORARY DRIVE

SURV. ϕ STA. 202+62, LT. (40' WIDE)
 SURV. ϕ STA. 202+80, RT. (20' WIDE)

BREAKAWAY CABLE TERMINAL

DETOUR ϕ STA. 111+26 - 111+60 LT.
 DETOUR ϕ STA. 111+50 - 111+75 RT.
 DETOUR ϕ STA. 111+26 - 111+50 RT.
 DETOUR ϕ STA. 111+50 - 111+75 LT.

OPEN DEAN QUARTER

DETOUR ϕ STA. 111+50 - 111+60 LT.
 DETOUR ϕ STA. 111+75 - 111+85 RT.

REMOVAL OF EXISTING PAVEMENT MARKINGS

SURV. ϕ STA. 202+00 ~ 203+75 (ϕ) (EDGE LINES)
 SURV. ϕ STA. 206+65 ~ 208+50 (ϕ) (EDGE LINES)


TEMPORARY 4" YELLOW LINE (ϕ) (SOLID DOUBLE)

DETOUR ϕ STA. 110+00 ~ 116+58

TEMPORARY 4" WHITE LINE (EDGE LINE)

DETOUR ϕ STA. 110+00 ~ 116+58

PUB. NO.	STATE	FISCAL YEAR	SHEET NO.	TOTAL SHEETS
1	VT	19		

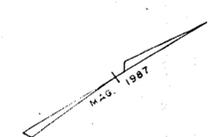


SURVEY CURVE DATA #11	REVCURVE DATA #11
$\Delta = 21^\circ 59' 16''$ LT.	$\Delta = 23^\circ 15' 11''$ LT.
D = 3' 00' 00"	D = 4' 00' 00"
R = 1909.86'	R = 1432.39'
T = 371.03'	T = 294.72'
L = 732.93'	L = 581.33'
E = 35.71'	E = 30.01'
	BANK = 0.063 FT./FT.

24' Wide Paved Detour
 (18" Subbase Dense Graded
 Crushed Stone w/ 2" Bit. Conc. Pave.)

REV. STA. 192+65 RT. ~ 201+42 LT.
 ELEC. SERVICE TO CAUTION LIGHT
 TO BE MAINTAINED AT ALL TIMES
 BY CONTRACTOR

REV. STA. 201+42 ~ 208+50 LT.
 ELEC. SERVICE TO CAUTION LIGHT
 TO BE MAINTAINED AT ALL TIMES BY CONTRACTOR

REV. STA. 208+50
 DETOUR PCC 116+58
 END DETOUR CONSTRUCTION

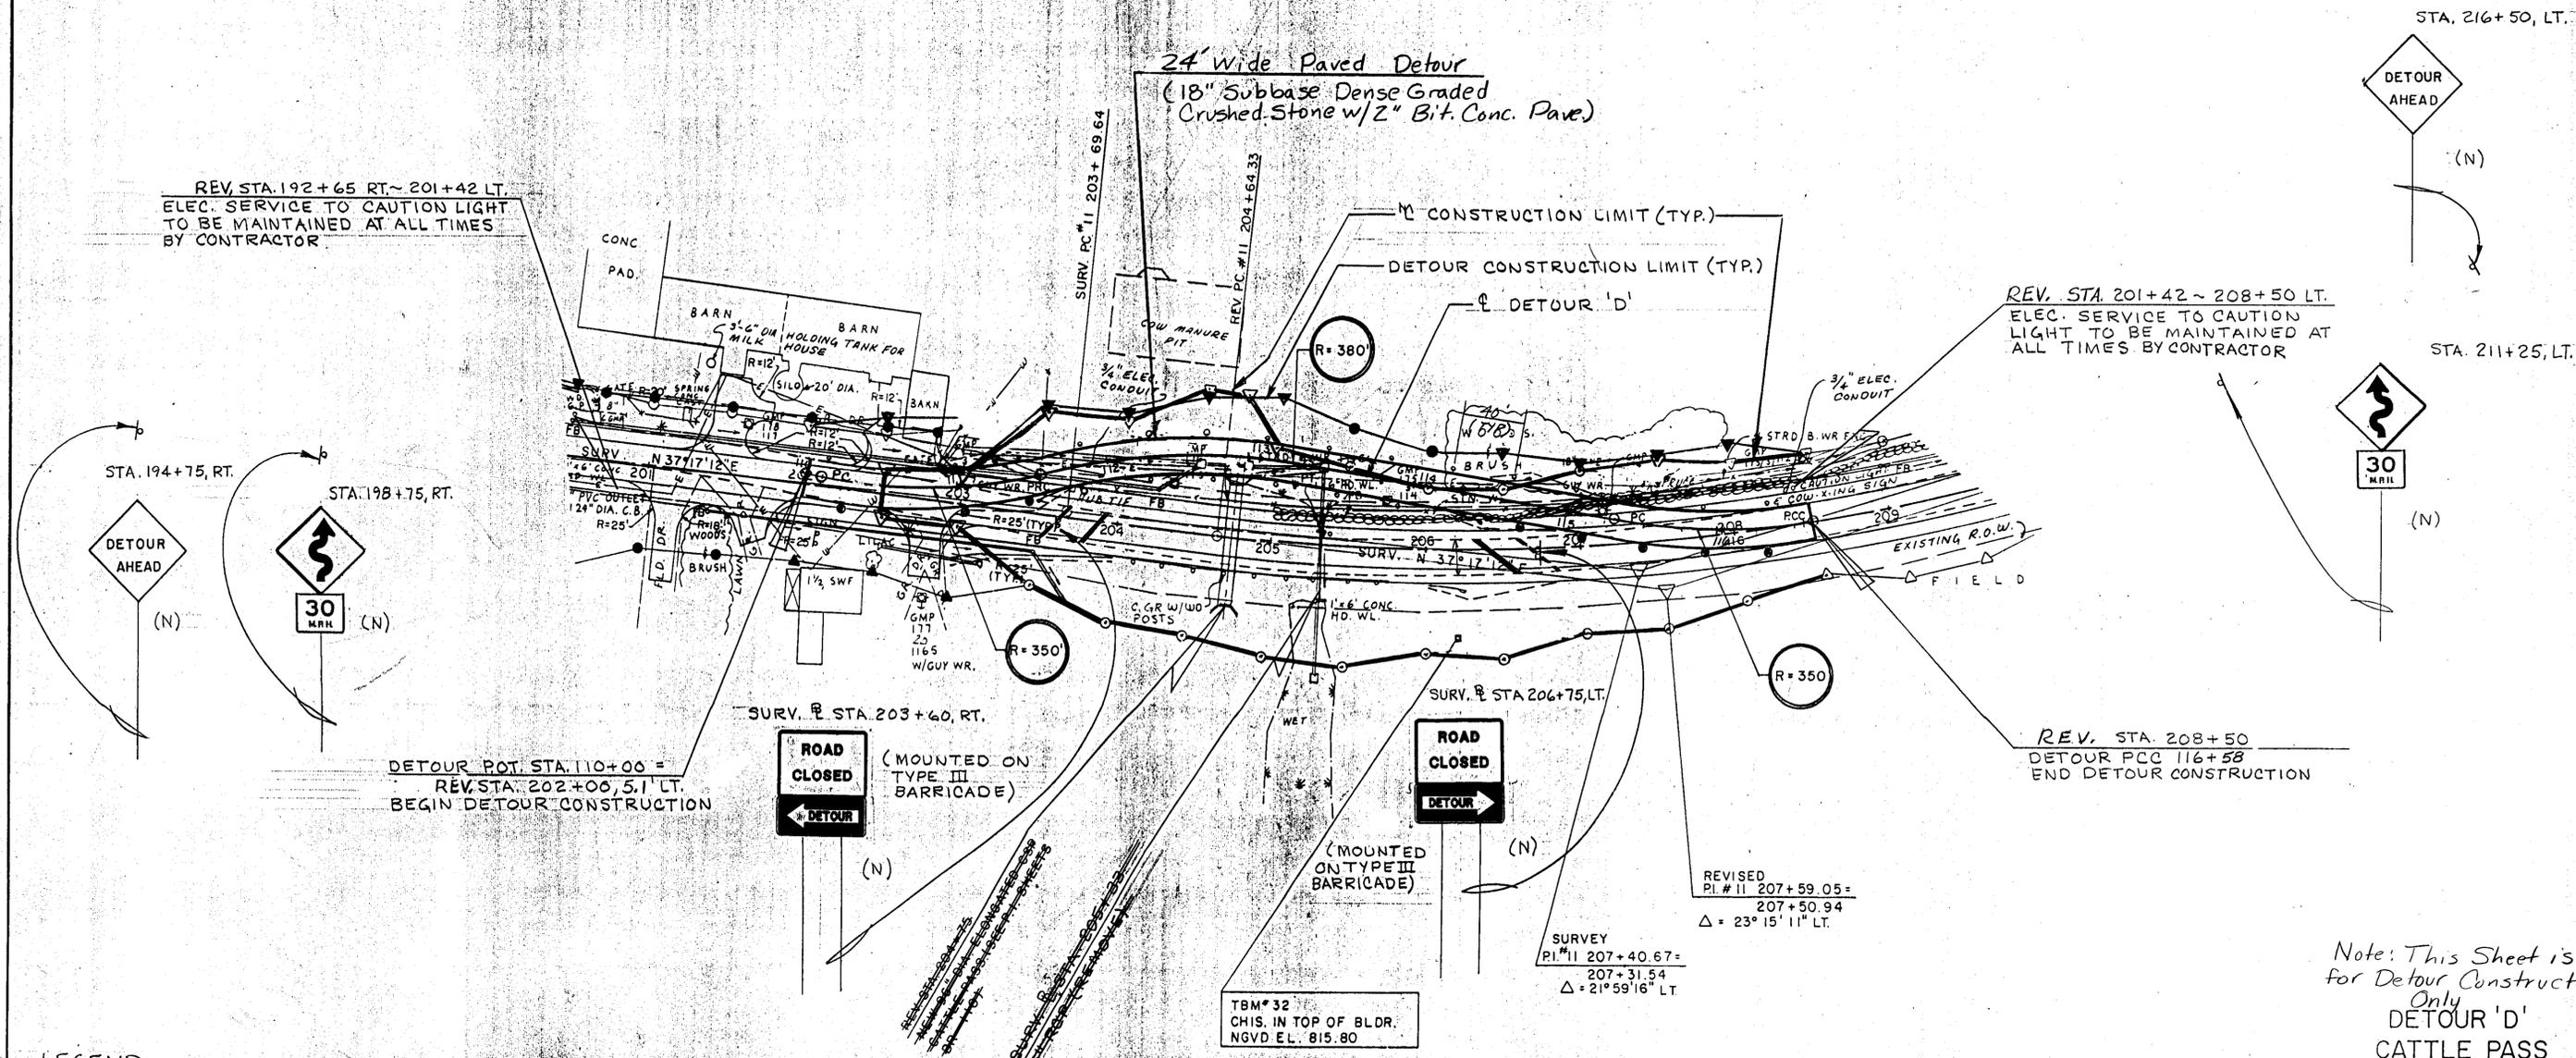

LEGEND

- TEMPORARY CONCRETE TRAFFIC BARRIER (OPTIONAL)
- REFLECTORIZED PLASTIC DRUM (30' SPACING TYPICAL) EXCEPT AT ENDS OF TEMPORARY TRAFFIC BARRIERS
- DELINEATORS (40' SPACING TYPICAL)
- TYPE III BARRICADE
- REFER TO STDS. E-101 AND E-102 FOR CONSTRUCTION SIGN DETAILS



Note: This Sheet is
 for Detour Construction
 Only
DETOUR 'D'
CATTLE PASS

Marshfield
 ST PASS(1)

VT. SURVEY	DATE 3/87
SURVEYED BY CONSULTANTS	
DRAWN BY BRYANT ASSOC.	DATE 6/87
TRACED BY	DATE
U.S. ROUTE 2 - MARSHFIELD	
PROJ. FECC NO. F 028 - 3(28)	
SHEET 17 OF 22	