


DATE	
BY	
PROJECT NO.	
NOTE BOOK	
NO.	

DATE	10/18/86
BY	W. J. BRYANT ASSOC.
PROJECT NO.	
NOTE BOOK	
NO.	

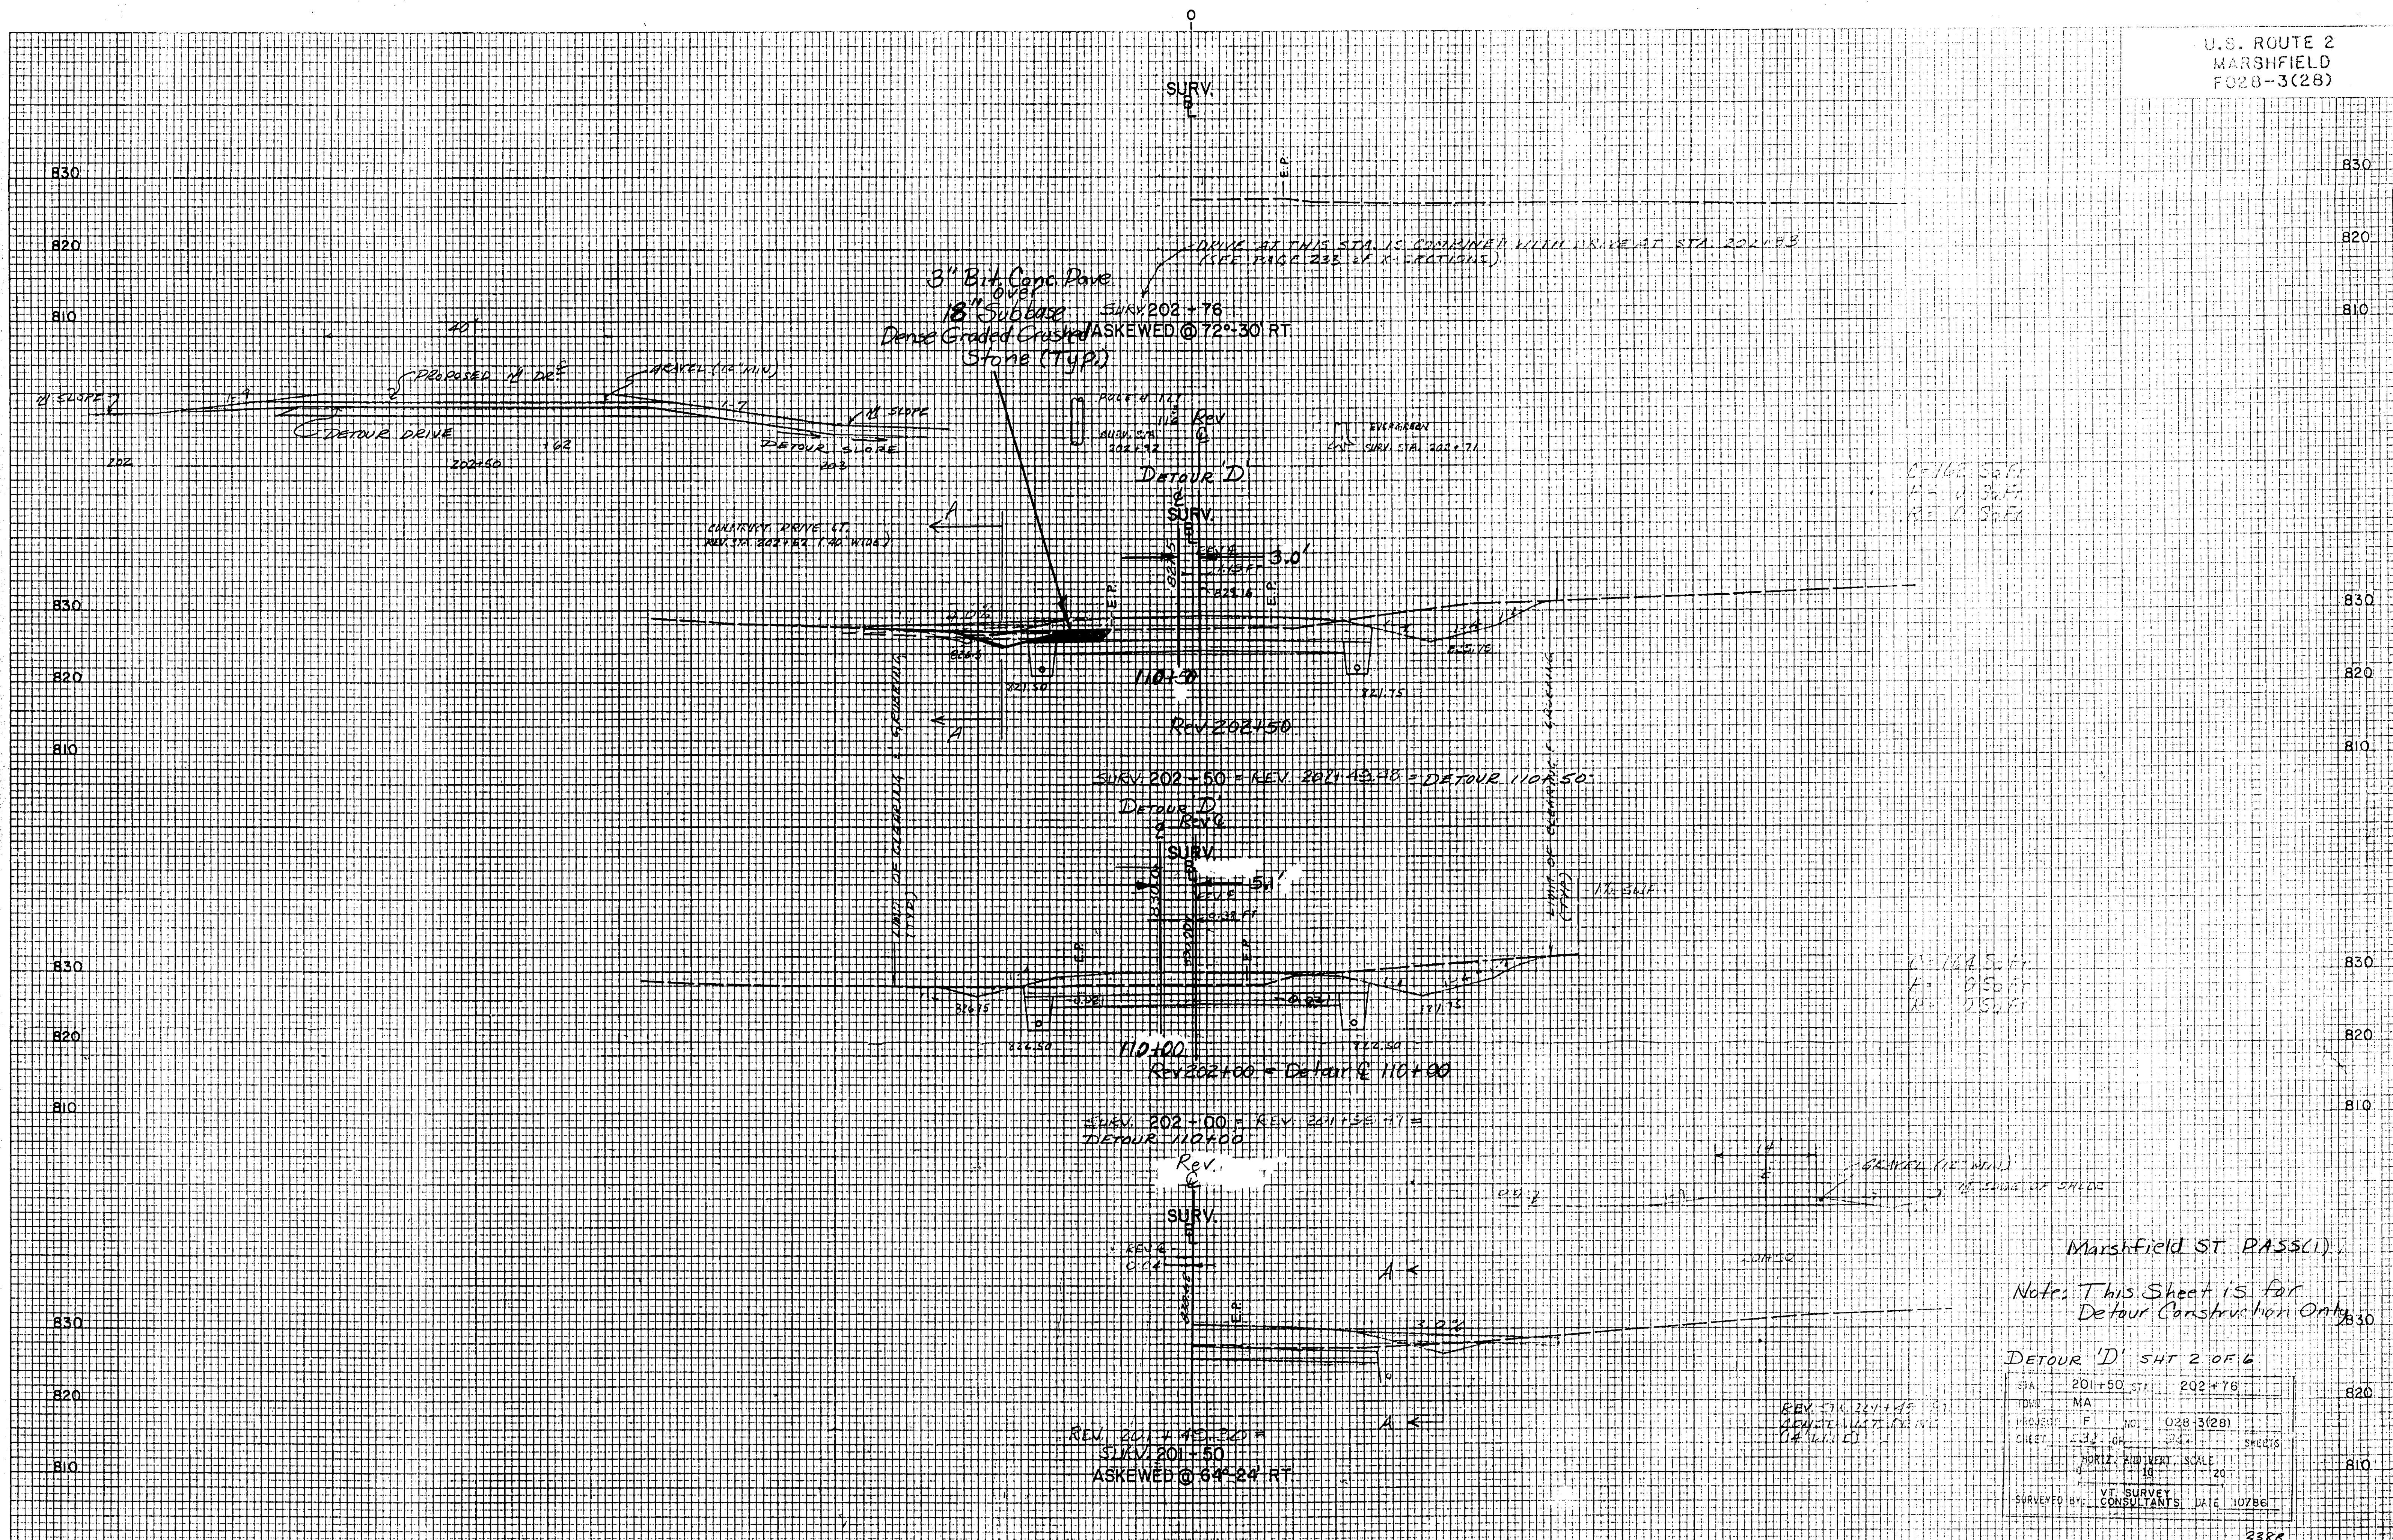

Marshfield ST PASS(1)

Note: This Sheet is for
Detour Construction Only

DETOUR 'D' SHT 2 OF 6

STA	201+50	202+76
DATE	MA	
PROJECT	NO	020-3(28)
SHEET	233	OF 233
HORIZ. AND VERT. SCALE		
1\"/>		