


DATE	BY	NO.
10/86	BRVANT ASSOC.	1086
ORIGINAL SURVEY	NOTE BOOK	NO.
DATE	BY	NO.
10/86	BRVANT ASSOC.	1086
ORIGINAL SURVEY	NOTE BOOK	NO.

DATE	BY	NO.
10/86	BRVANT ASSOC.	1086
ORIGINAL SURVEY	NOTE BOOK	NO.
DATE	BY	NO.
10/86	BRVANT ASSOC.	1086
ORIGINAL SURVEY	NOTE BOOK	NO.

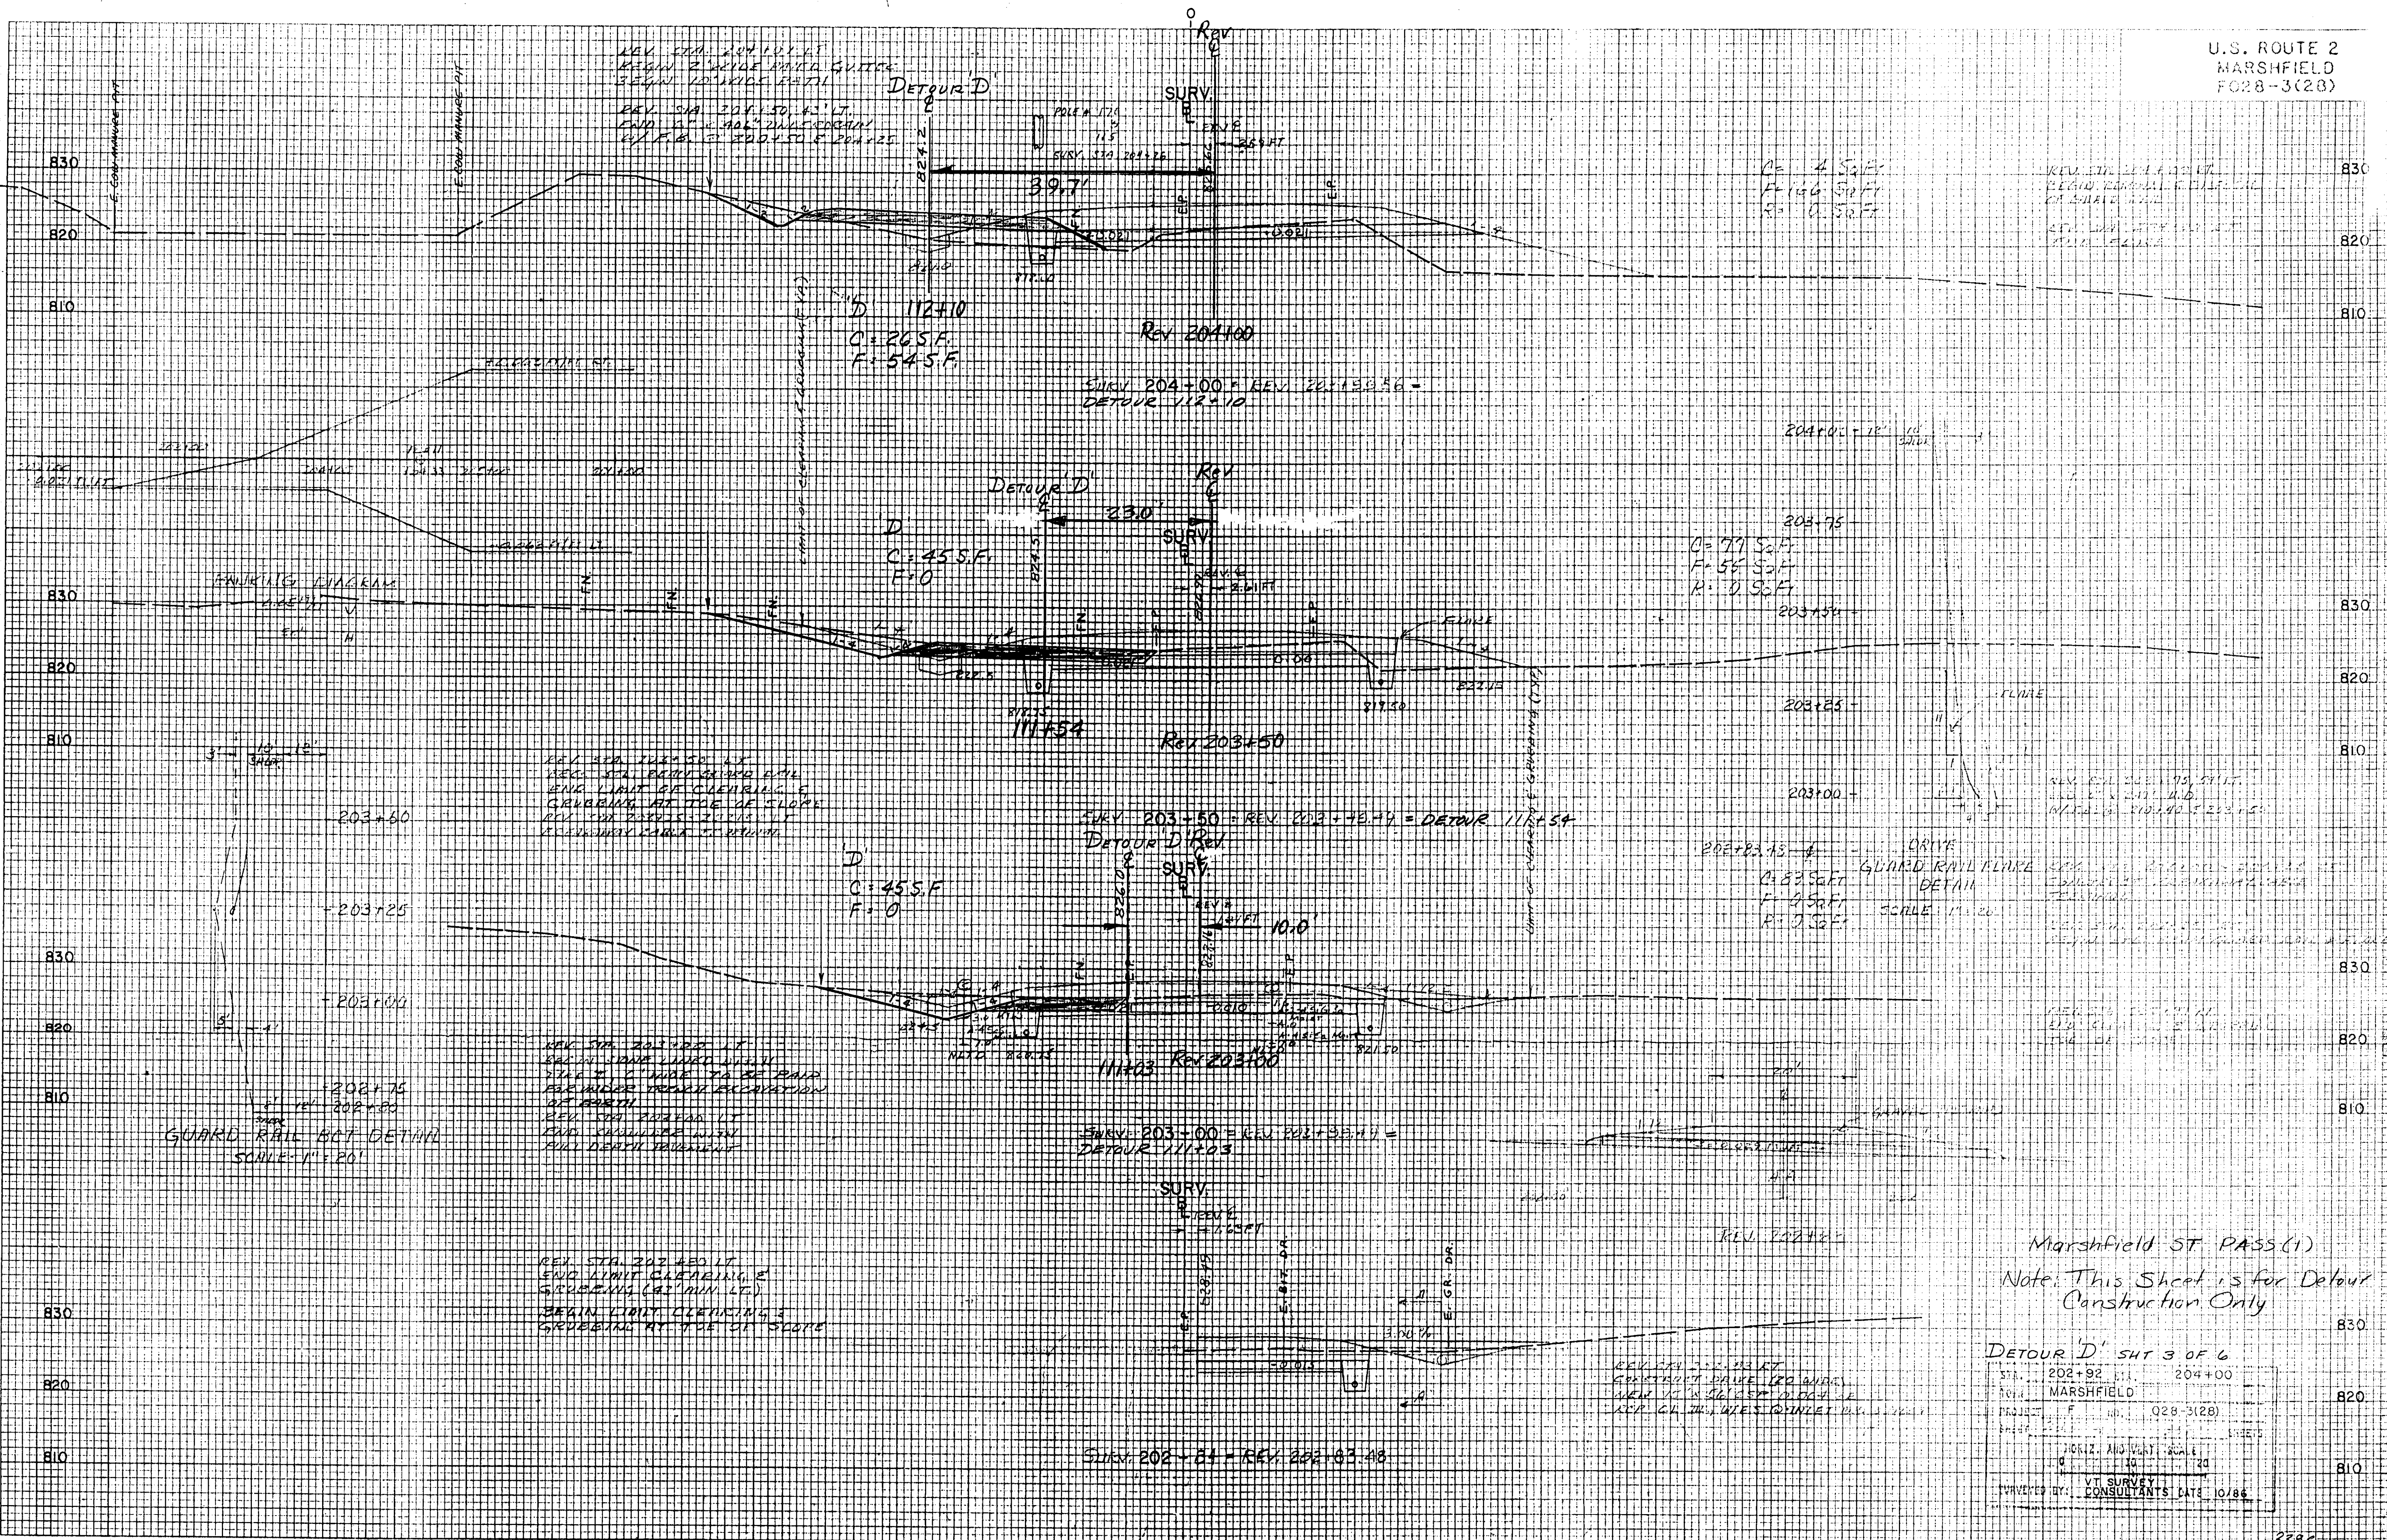

Marshfield ST PASS (1)
Note: This Sheet is for Detour Construction Only

DETOUR D' SHT 3 OF 6
STA. 202+92 TO 204+00
MARSHFIELD
PROJECT F. M. Q28-3(28)
SHEET 3
HORIZ. ANGLE SCALE 1"=40'
VERT. ANGLE SCALE 1"=20'
DATE 10/86