


DATE	
BY	
NO.	
FINAL SURVEY NOTE BOOK	
NO.	

DATE	10/88
BY	BRYANT ASSOC.
NO.	
ORIGINAL SURVEY NOTE BOOK	
NO.	

810
800
790


810
800
790

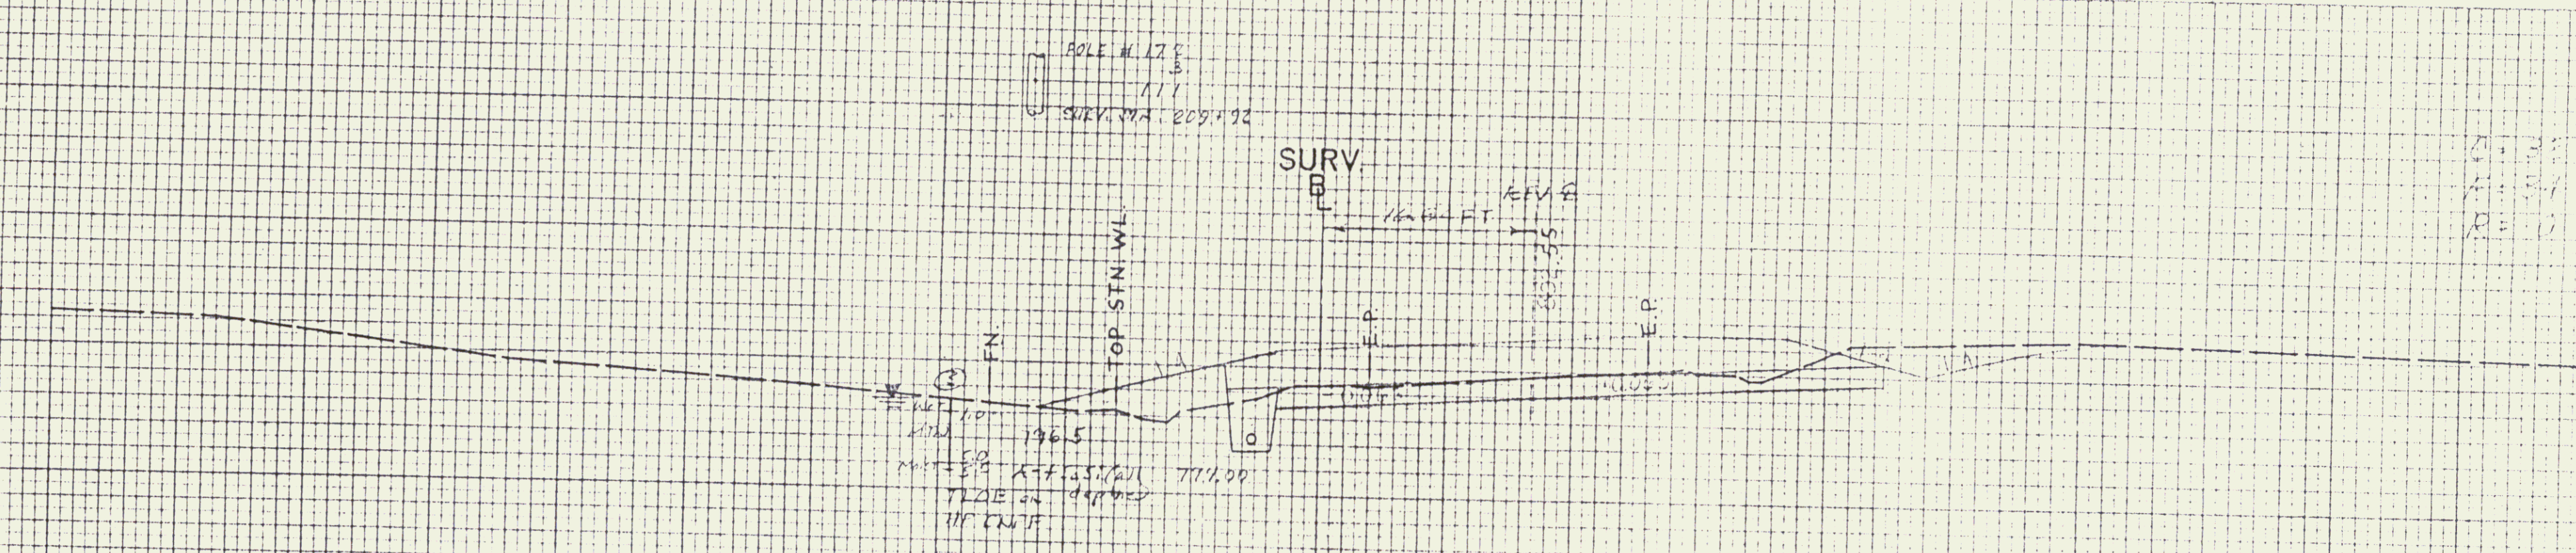

SURV. 209+50 = REV. 210+55.40

810
800
790

810
800
790

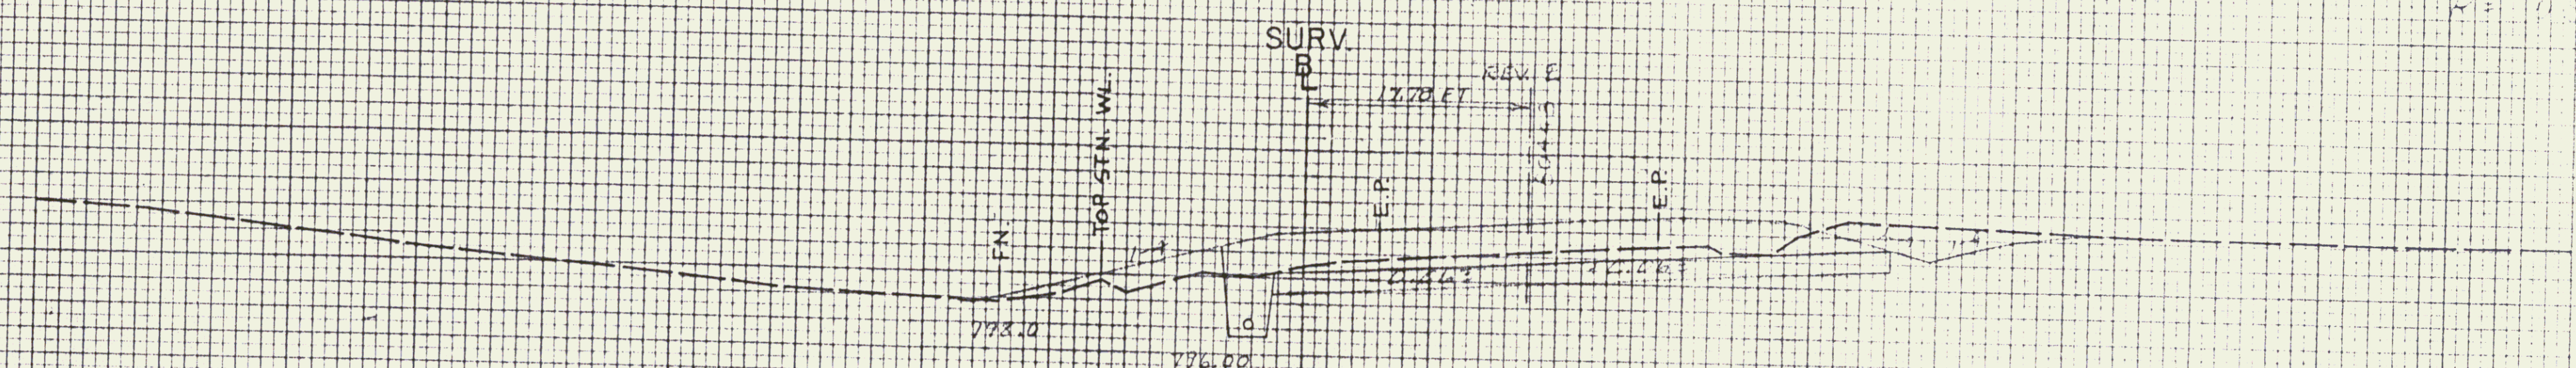


REV. STA 209+00 LT.
END STONE LINED DITCH
TYPE 2, 6' WIDE

SURV. 209+00 = REV. 209+55.40

800
790


800
790

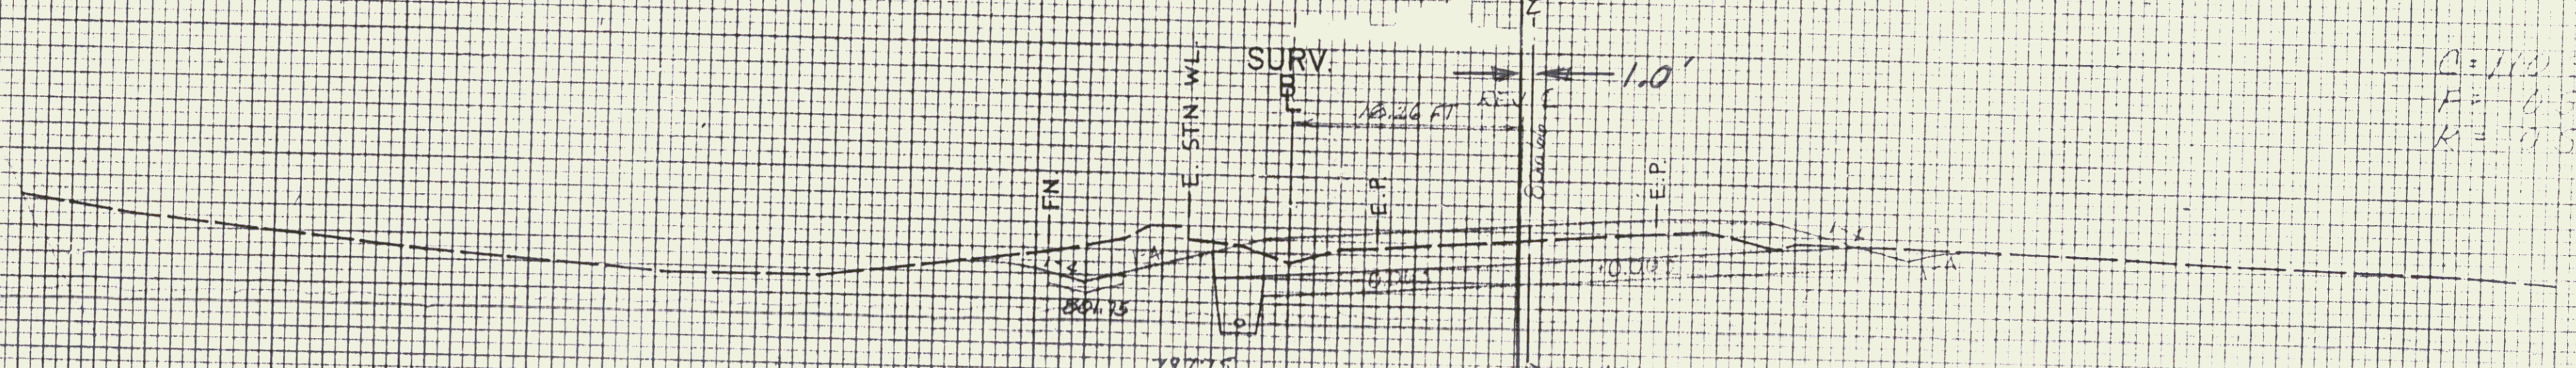

SURV. 208+50 = REV. 208+53.02 =
DETOUR 116+58

810
800

810
800

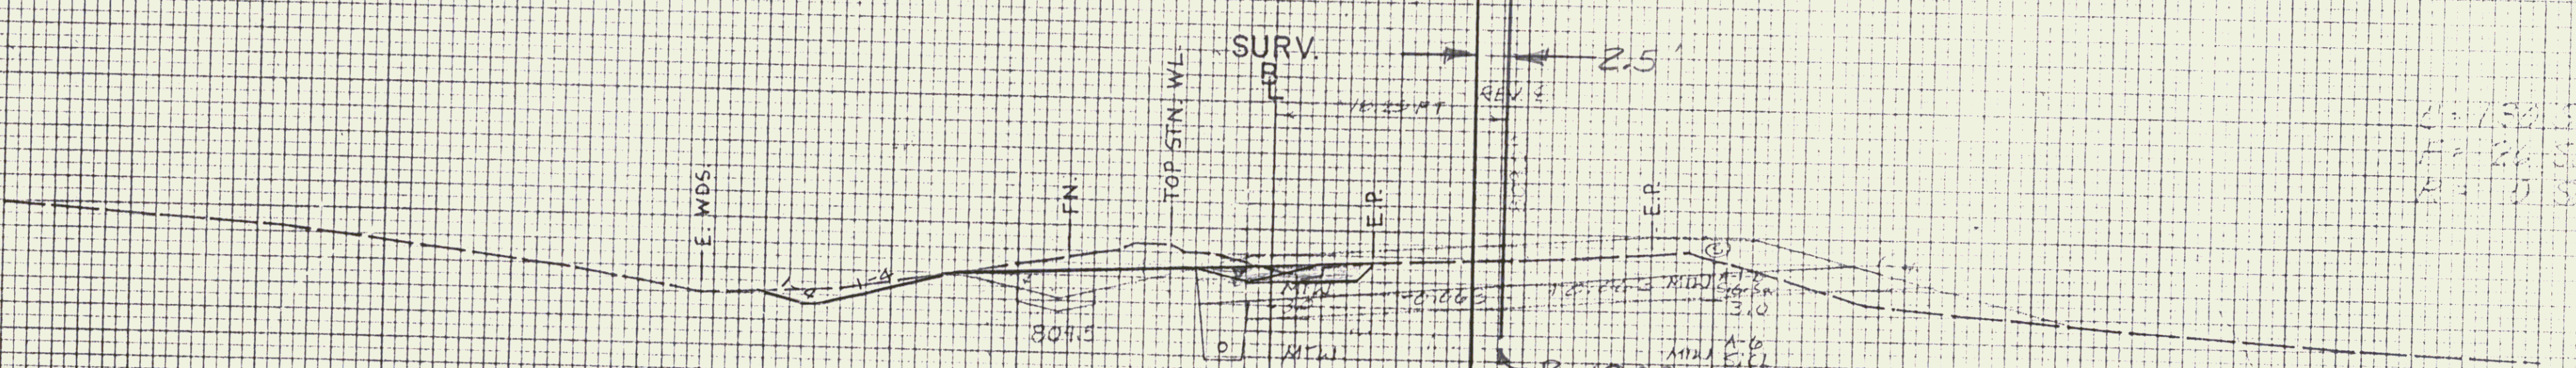

SURV. 208+00 = REV. 208+52.34 =
DETOUR 116+08

C = 65.00 FT
F = 23.00 FT
R = 17.50 FT

C = 110.00 FT
F = 45.00 FT
R = 17.50 FT

C = 150.00 FT
F = 24.50 FT
R = 17.50 FT

Marshfield ST. PASS(1)

Note: This Sheet is for Detour Construction Only

DETOUR 'D' SHT 6 OF 6

STA.	208+00	209+50
TOWN	MARSHFIELD	
PROJECT	F 028-3(29)	
SHEET	6	20
HOURS AND DISTANCE		
0 10 20 30 40 50		
VT. SURVEY CONSULTANTS DATE 10/88		