


DATE: _____ BY: _____
 SURVEYED: _____
 PLATTED: _____
 NOTE BOOK: _____
 NO. _____
 AREAS CHECKED: _____

DATE: _____ BY: _____
 SURVEYED: _____
 PLATTED: _____
 NOTE BOOK: _____
 NO. _____
 AREAS CHECKED: _____

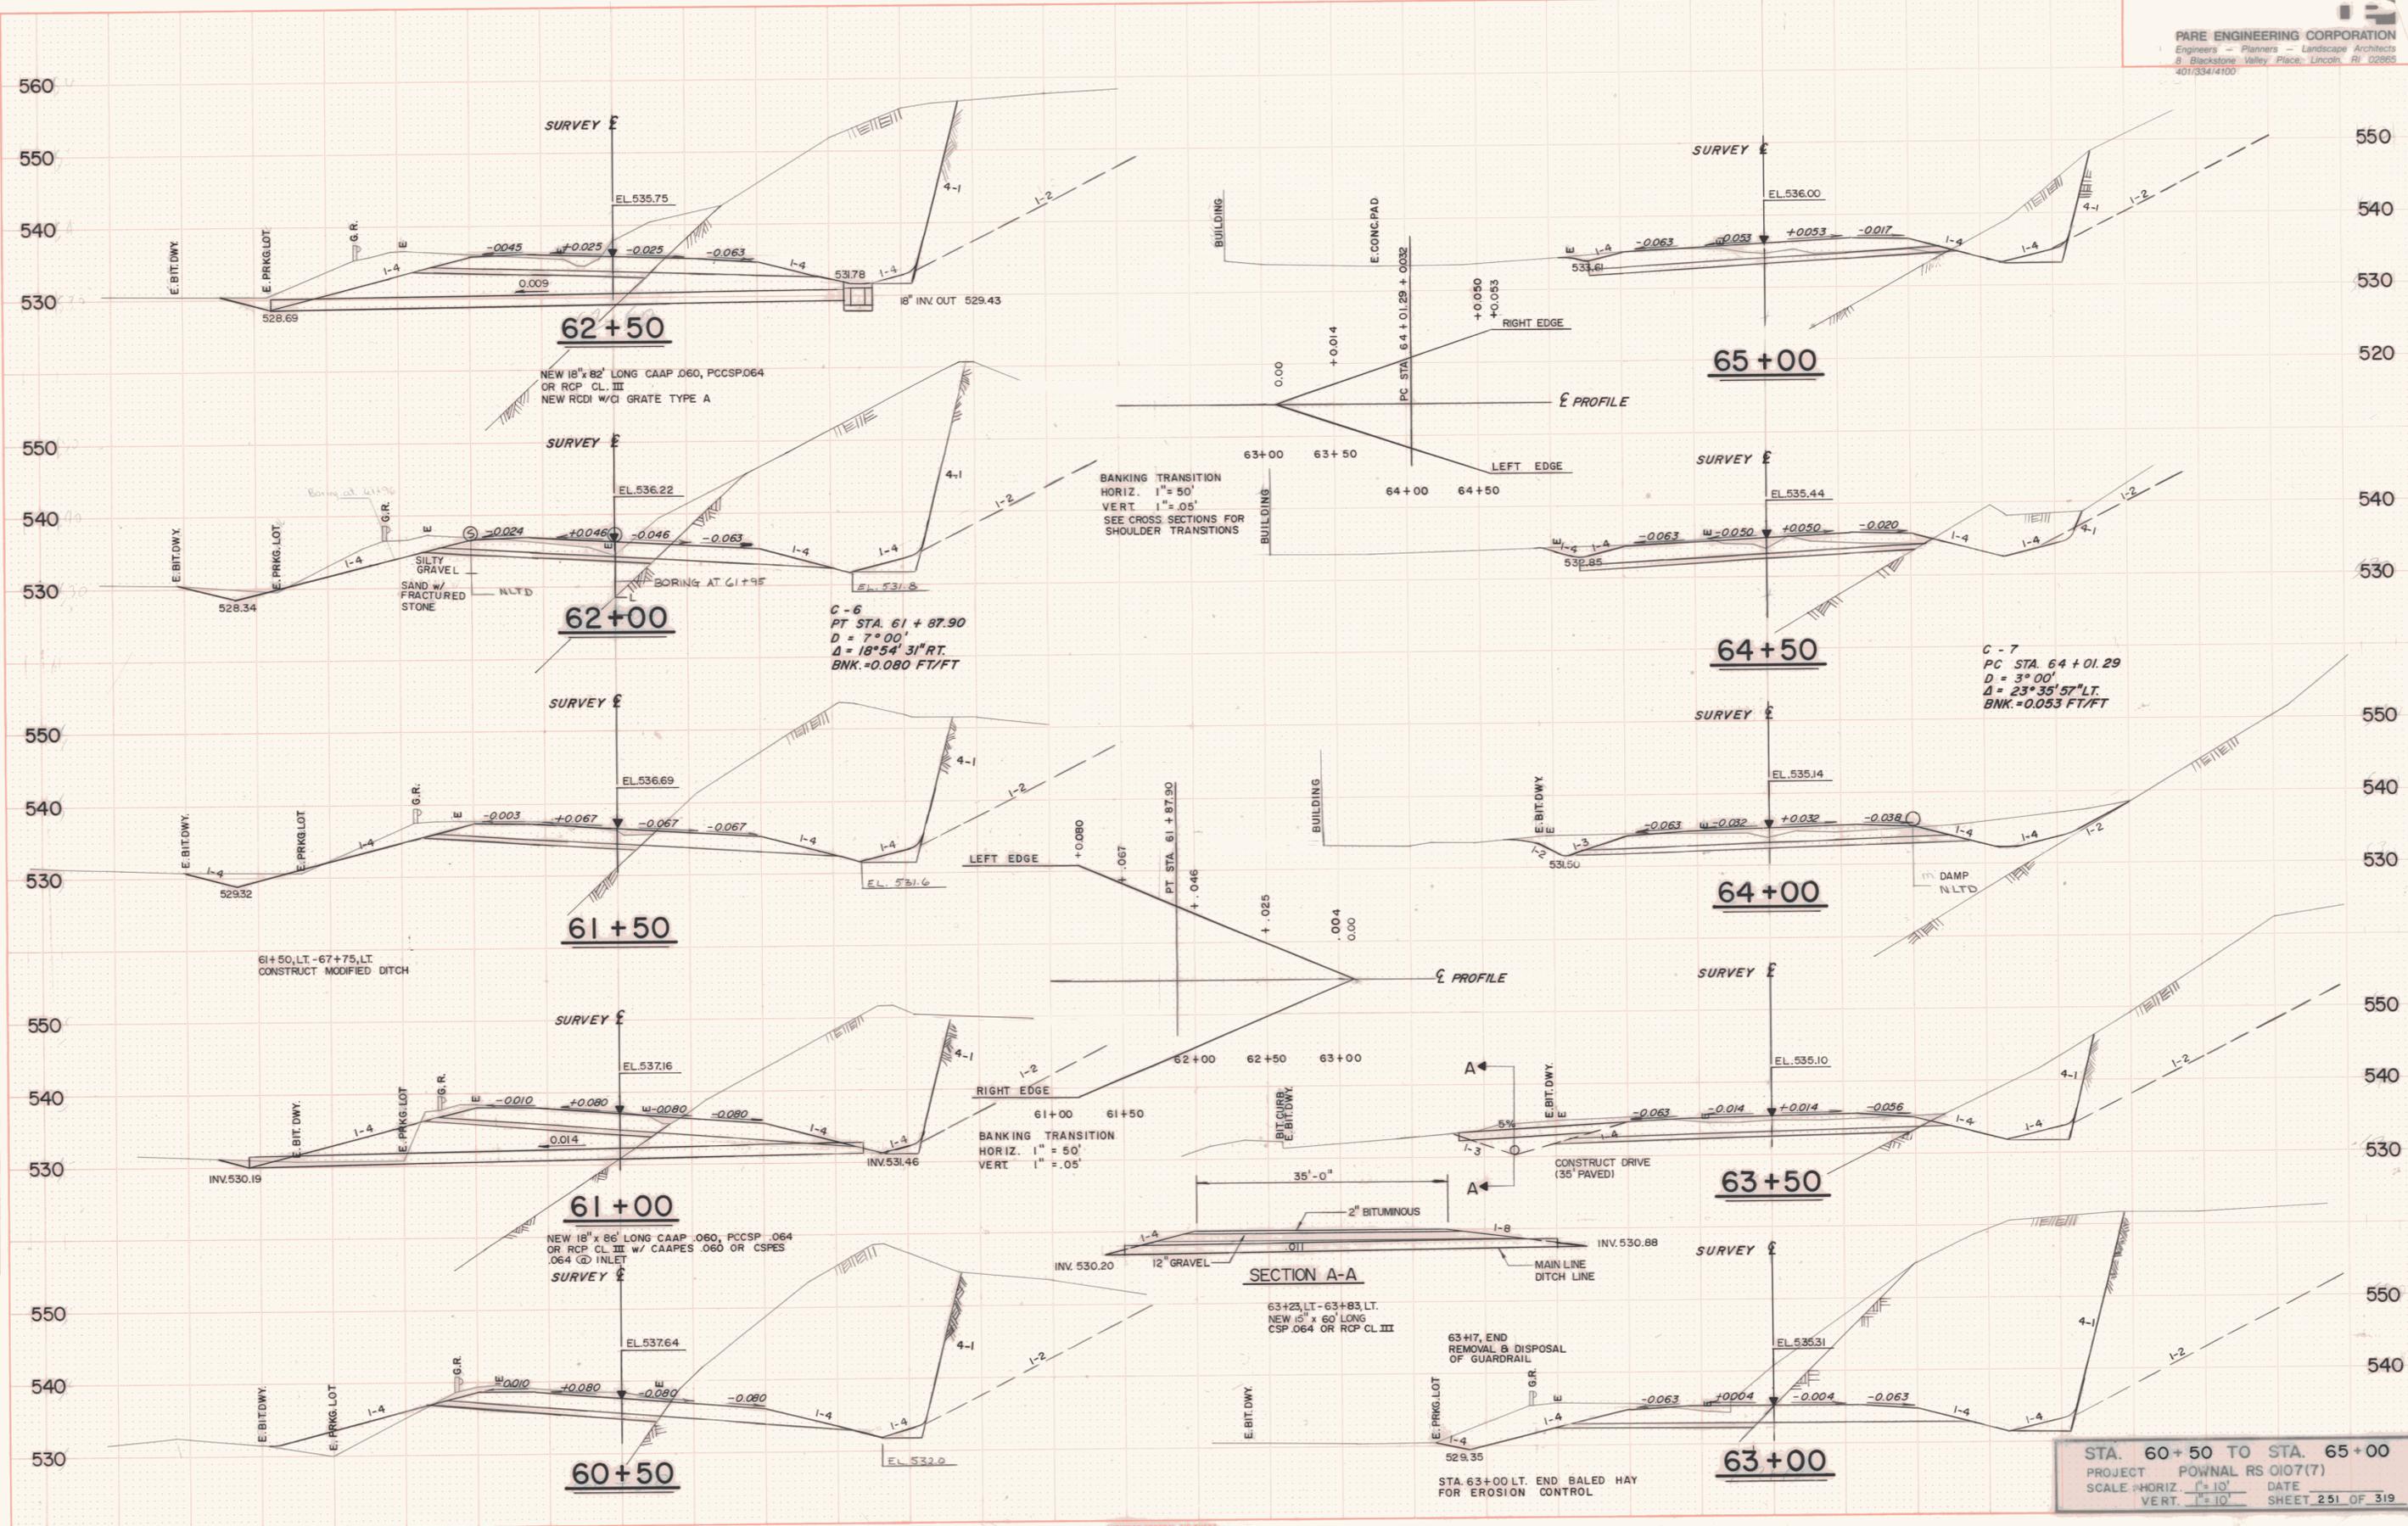

STA. 60+50 TO STA. 65+00
 PROJECT: POWNAL RS 0107(7)
 SCALE: HORIZ. 1"=10' DATE: _____
 VERT. 1"=10' SHEET 251 OF 319