
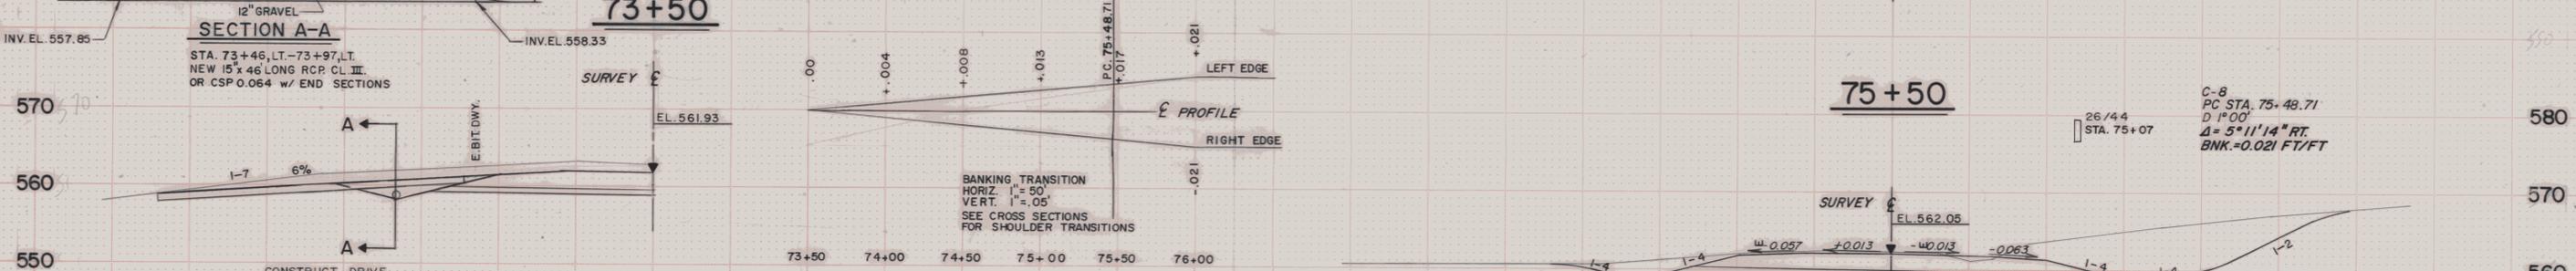
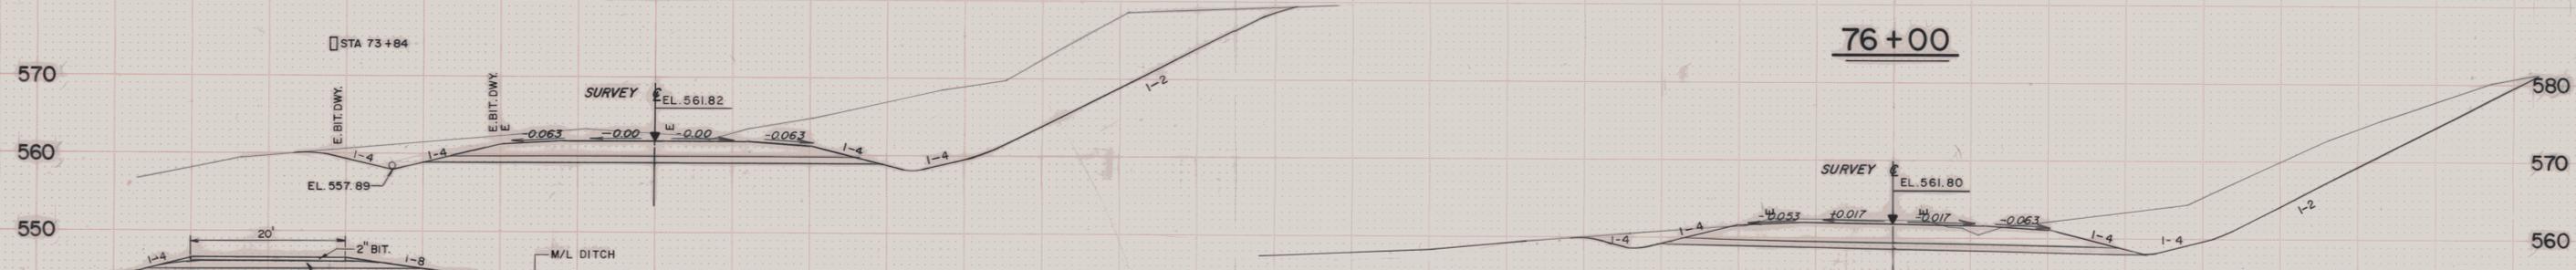


47/20/2/45
 STA. 76+67

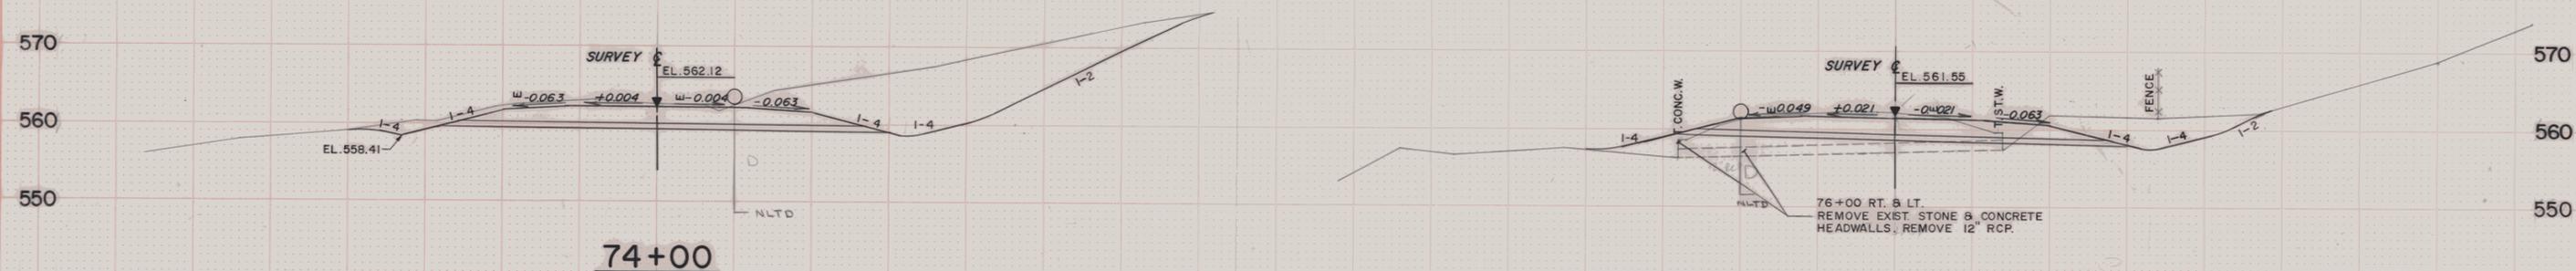

FINAL SURVEY
 DATE: _____
 BY: _____
 CHECKED: _____
 REVISIONS:
 NO. DESCRIPTION
 1. _____
 2. _____
 3. _____

ORIGINAL SURVEY
 DATE: _____
 BY: _____
 CHECKED: _____
 REVISIONS:
 NO. DESCRIPTION
 1. _____
 2. _____
 3. _____

STA. 73+00 TO STA. 76+50
 PROJECT POWNAL RS 0107(7)
 SCALE HORIZ. 1"=10' DATE _____
 VERT. 1"=10' SHEET 254 OF 319