


DATE	
BY	
REVISION	
NO.	
DESCRIPTION	

DATE	
BY	
REVISION	
NO.	
DESCRIPTION	

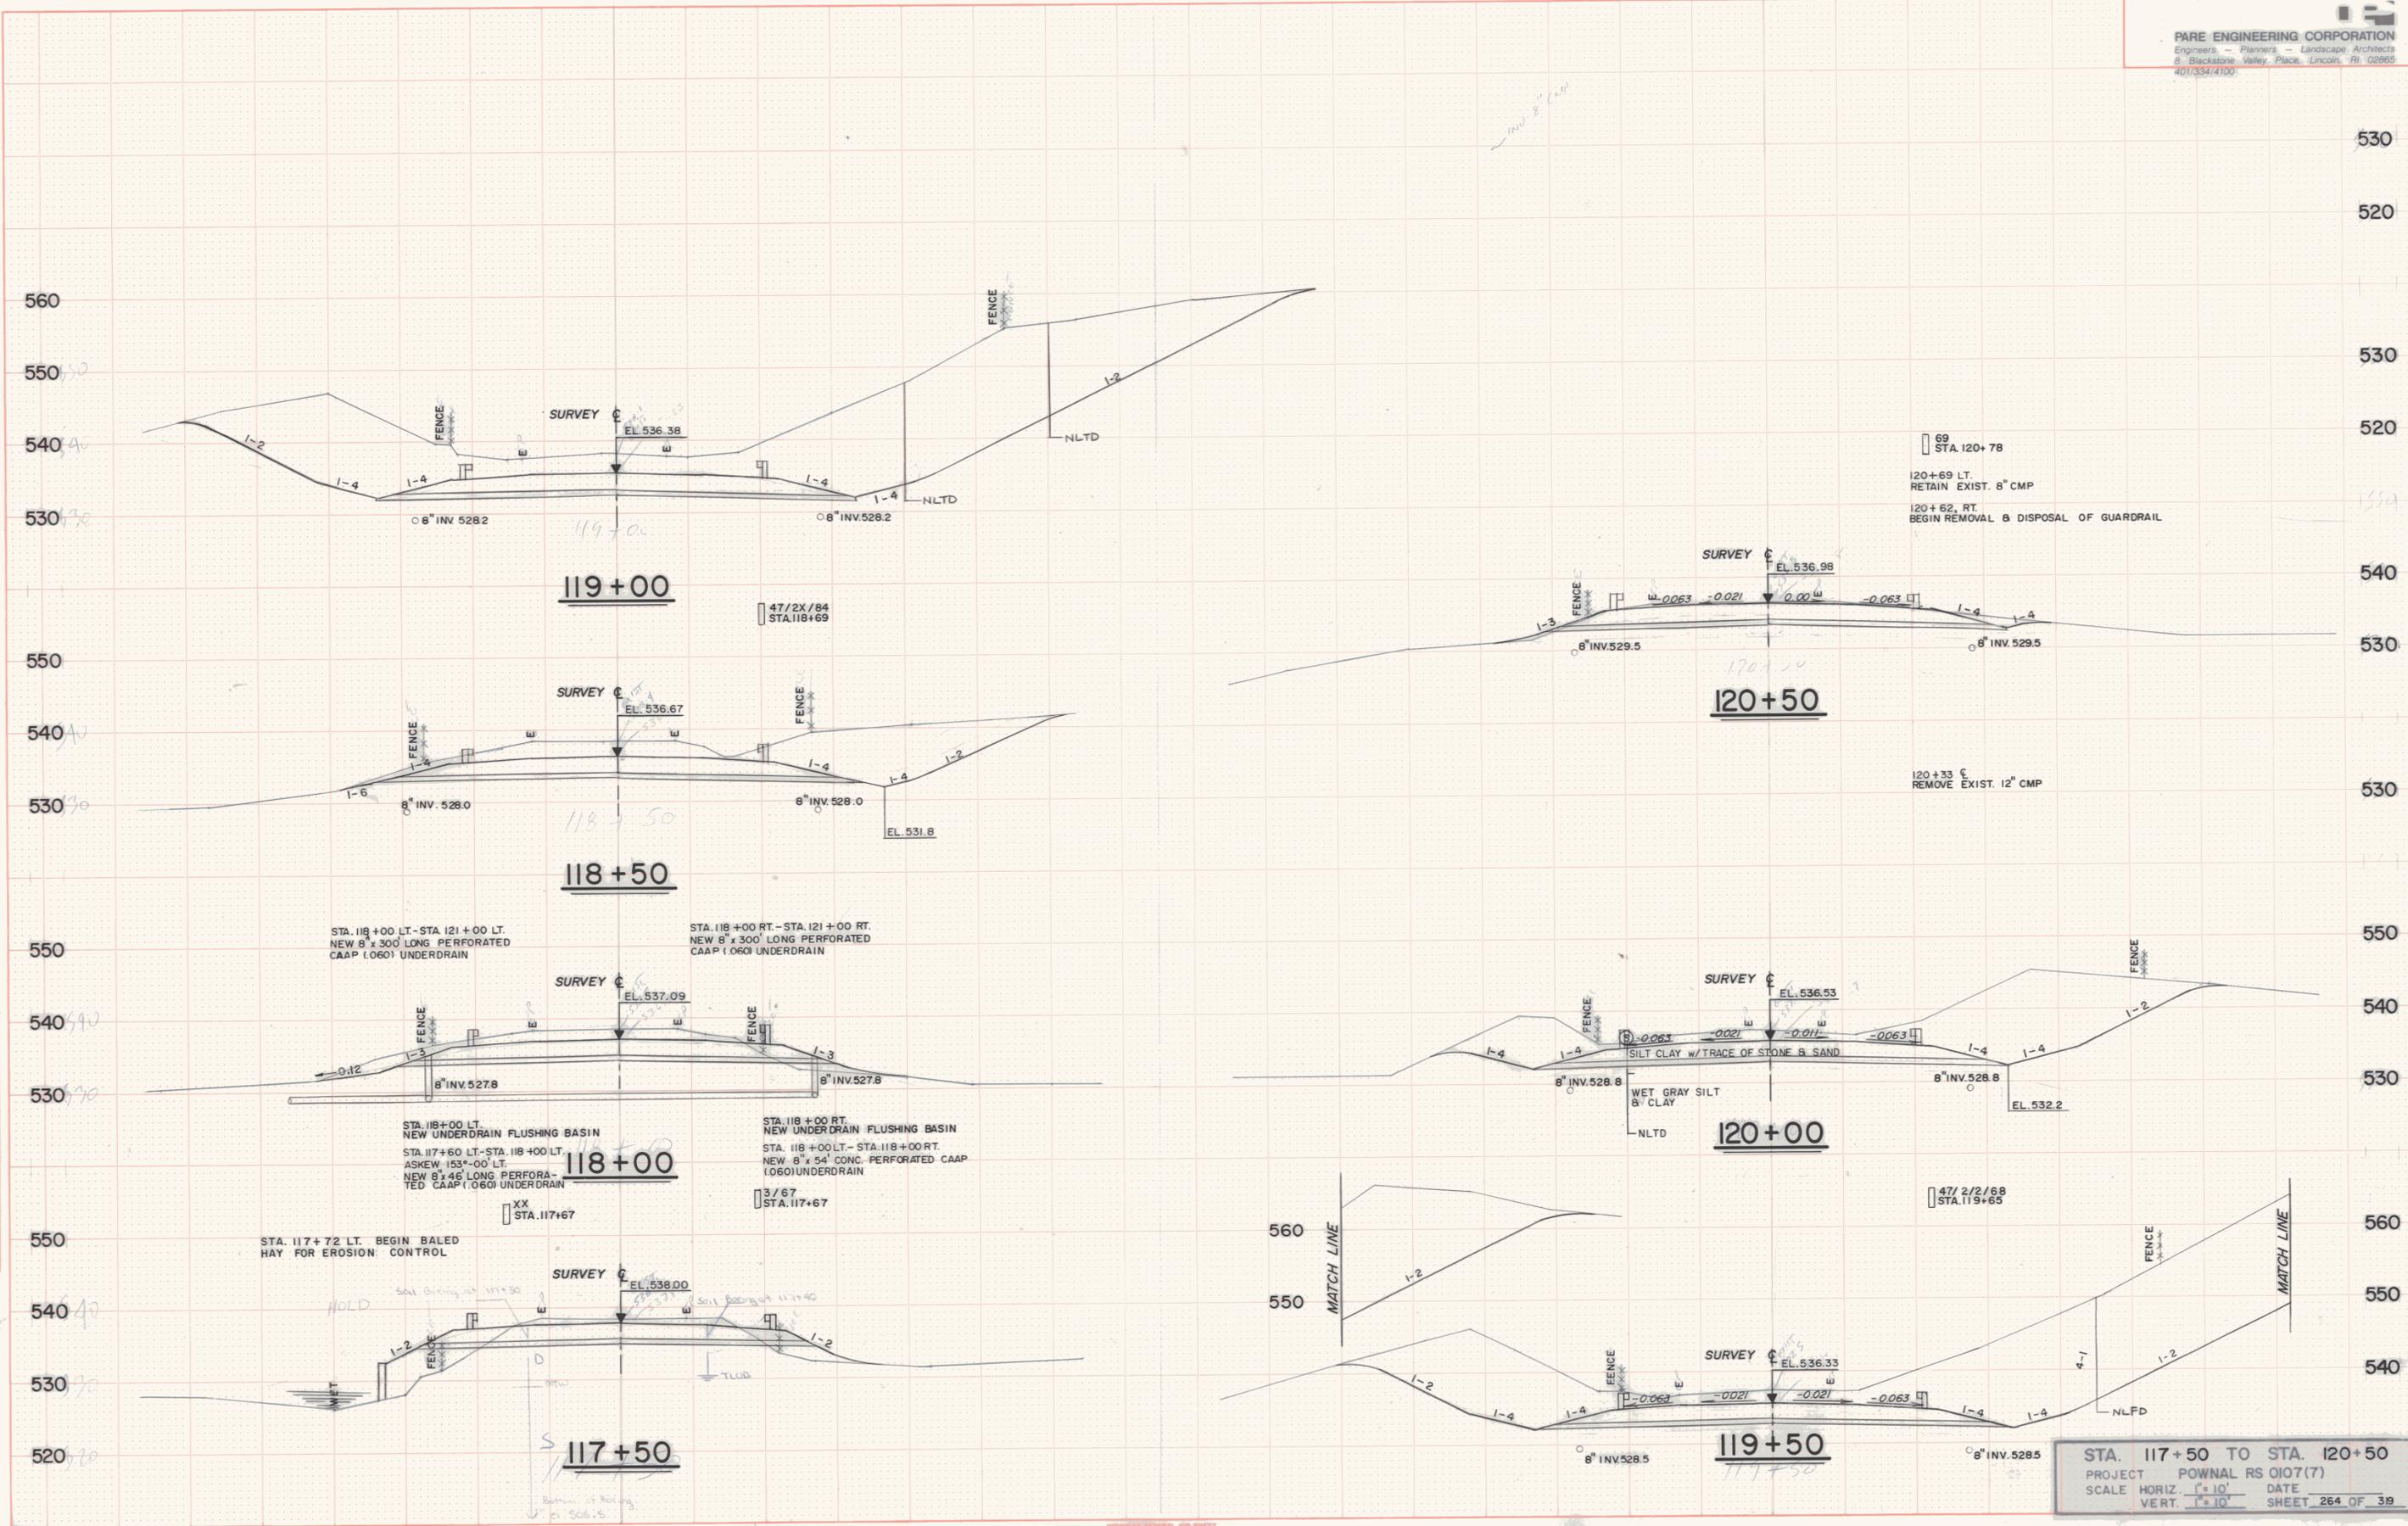

STA. 117+50 TO STA. 120+50
 PROJECT POWNAL RS 0107(7)
 SCALE HORIZ. 1"=10' DATE
 VERT. 1"=10' SHEET 264 OF 39