

DATE: _____
 BY: _____
 ORIGINAL SURVEY PLOTTED: _____
 SURVEY TEMPLATE: _____
 NOTE BOOK NO.: _____
 AREAS CHECKED: _____

DATE: _____
 BY: _____
 ORIGINAL SURVEY PLOTTED: _____
 SURVEY TEMPLATE: _____
 NOTE BOOK NO.: _____
 AREAS CHECKED: _____

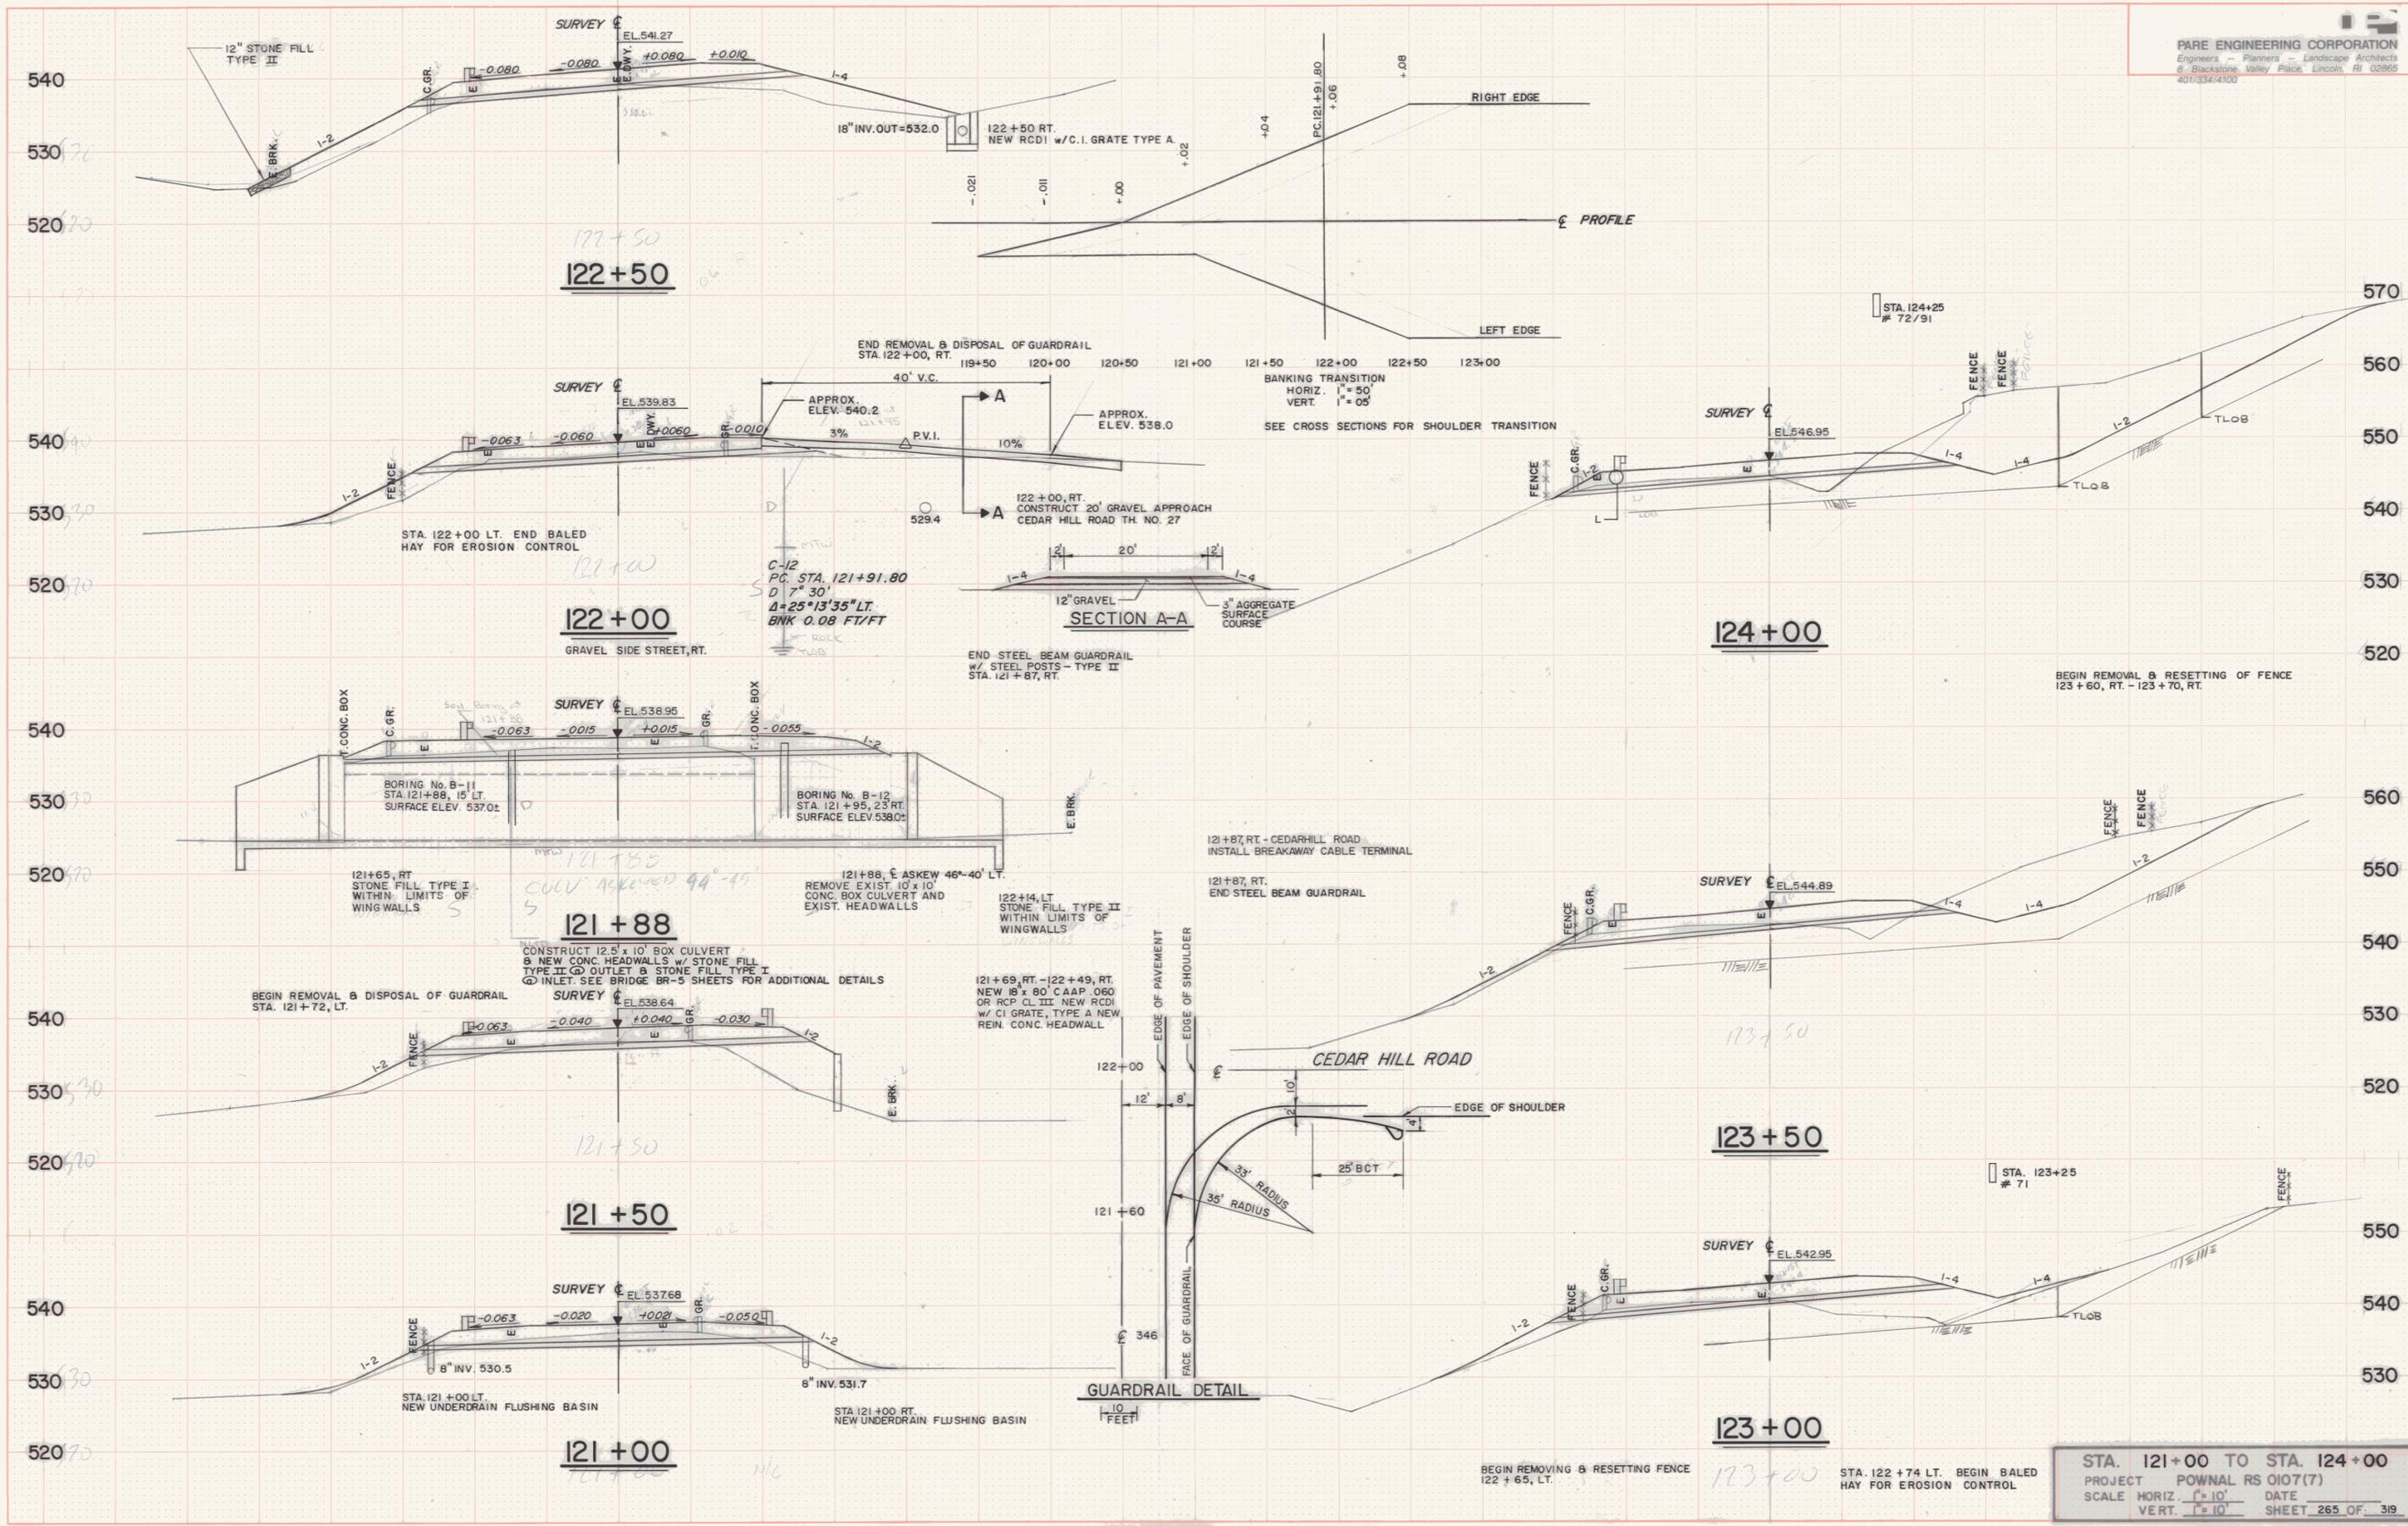


PLATE 3-FULL CROSS SECTION/FULL DOT
 1/2" = 10' HORIZ.
 1/8" = 1' VERT.

STA. 121+00 TO STA. 124+00	
PROJECT POWNAL RS 0107(7)	
SCALE HORIZ. 1" = 10'	DATE _____
VERT. 1/8" = 1'	SHEET 265 OF 319