
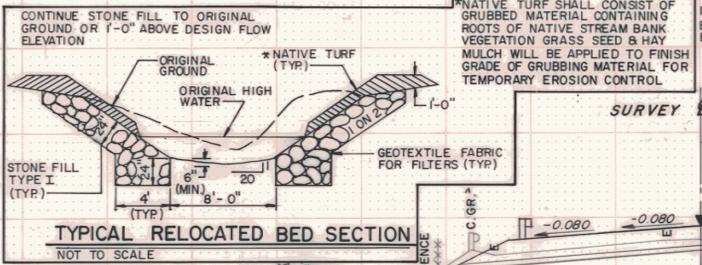


FINAL SURVEY
 REVIEWED
 PLOTTED
 NOTE BOOK
 NO. 123456789
 DATE 12/31/2010

ORIGINAL SURVEY
 REVIEWED
 PLOTTED
 NOTE BOOK
 NO. 123456789
 DATE 12/31/2010

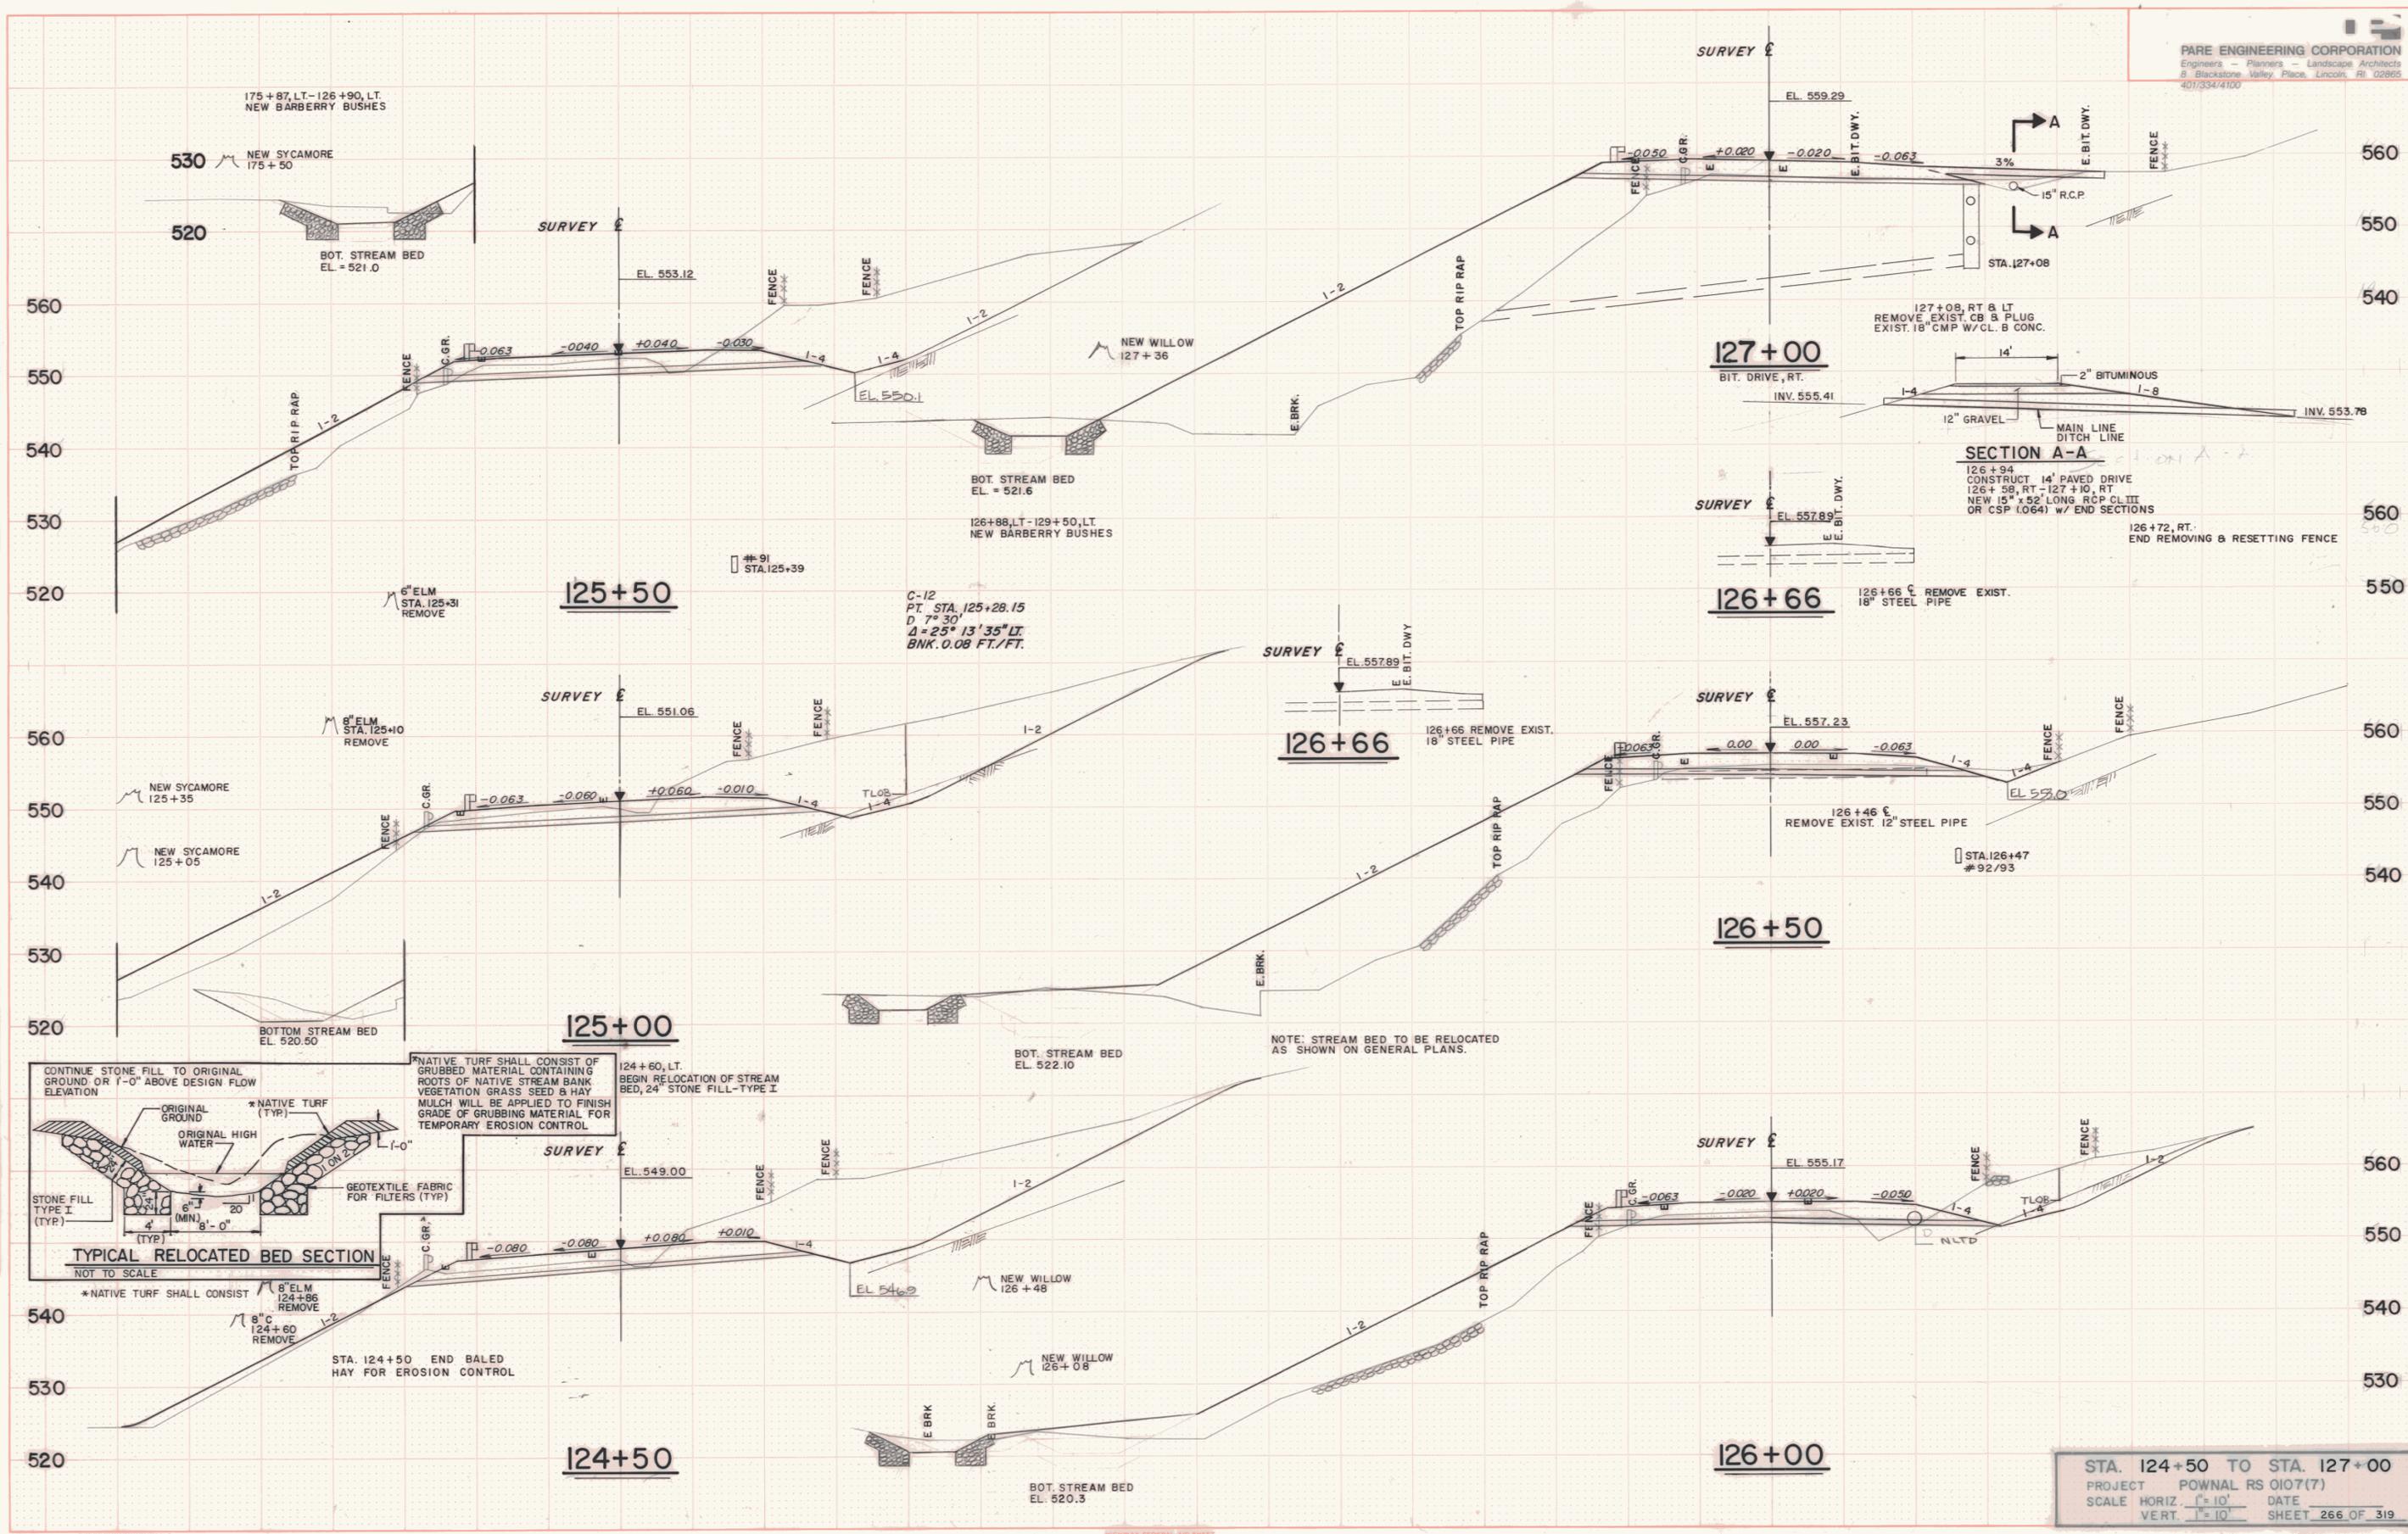

STA. 124+50 TO STA. 127+00
 PROJECT POWNAL RS 0107(7)
 SCALE HORIZ. 1"=10' DATE _____
 VERT. 1"=10' SHEET 266 OF 319