


FINAL SURVEY	BY	DATE
SURVEYED		
PLOTTED		
TEMP. PLATE		
NOTE BOOK		
AREA		
NO.		
AREAS CHECKED		

ORIGINAL SURVEY	BY	DATE
SURVEYED		
PLOTTED		
TEMP. PLATE		
NOTE BOOK		
AREA		
NO.		
AREAS CHECKED		

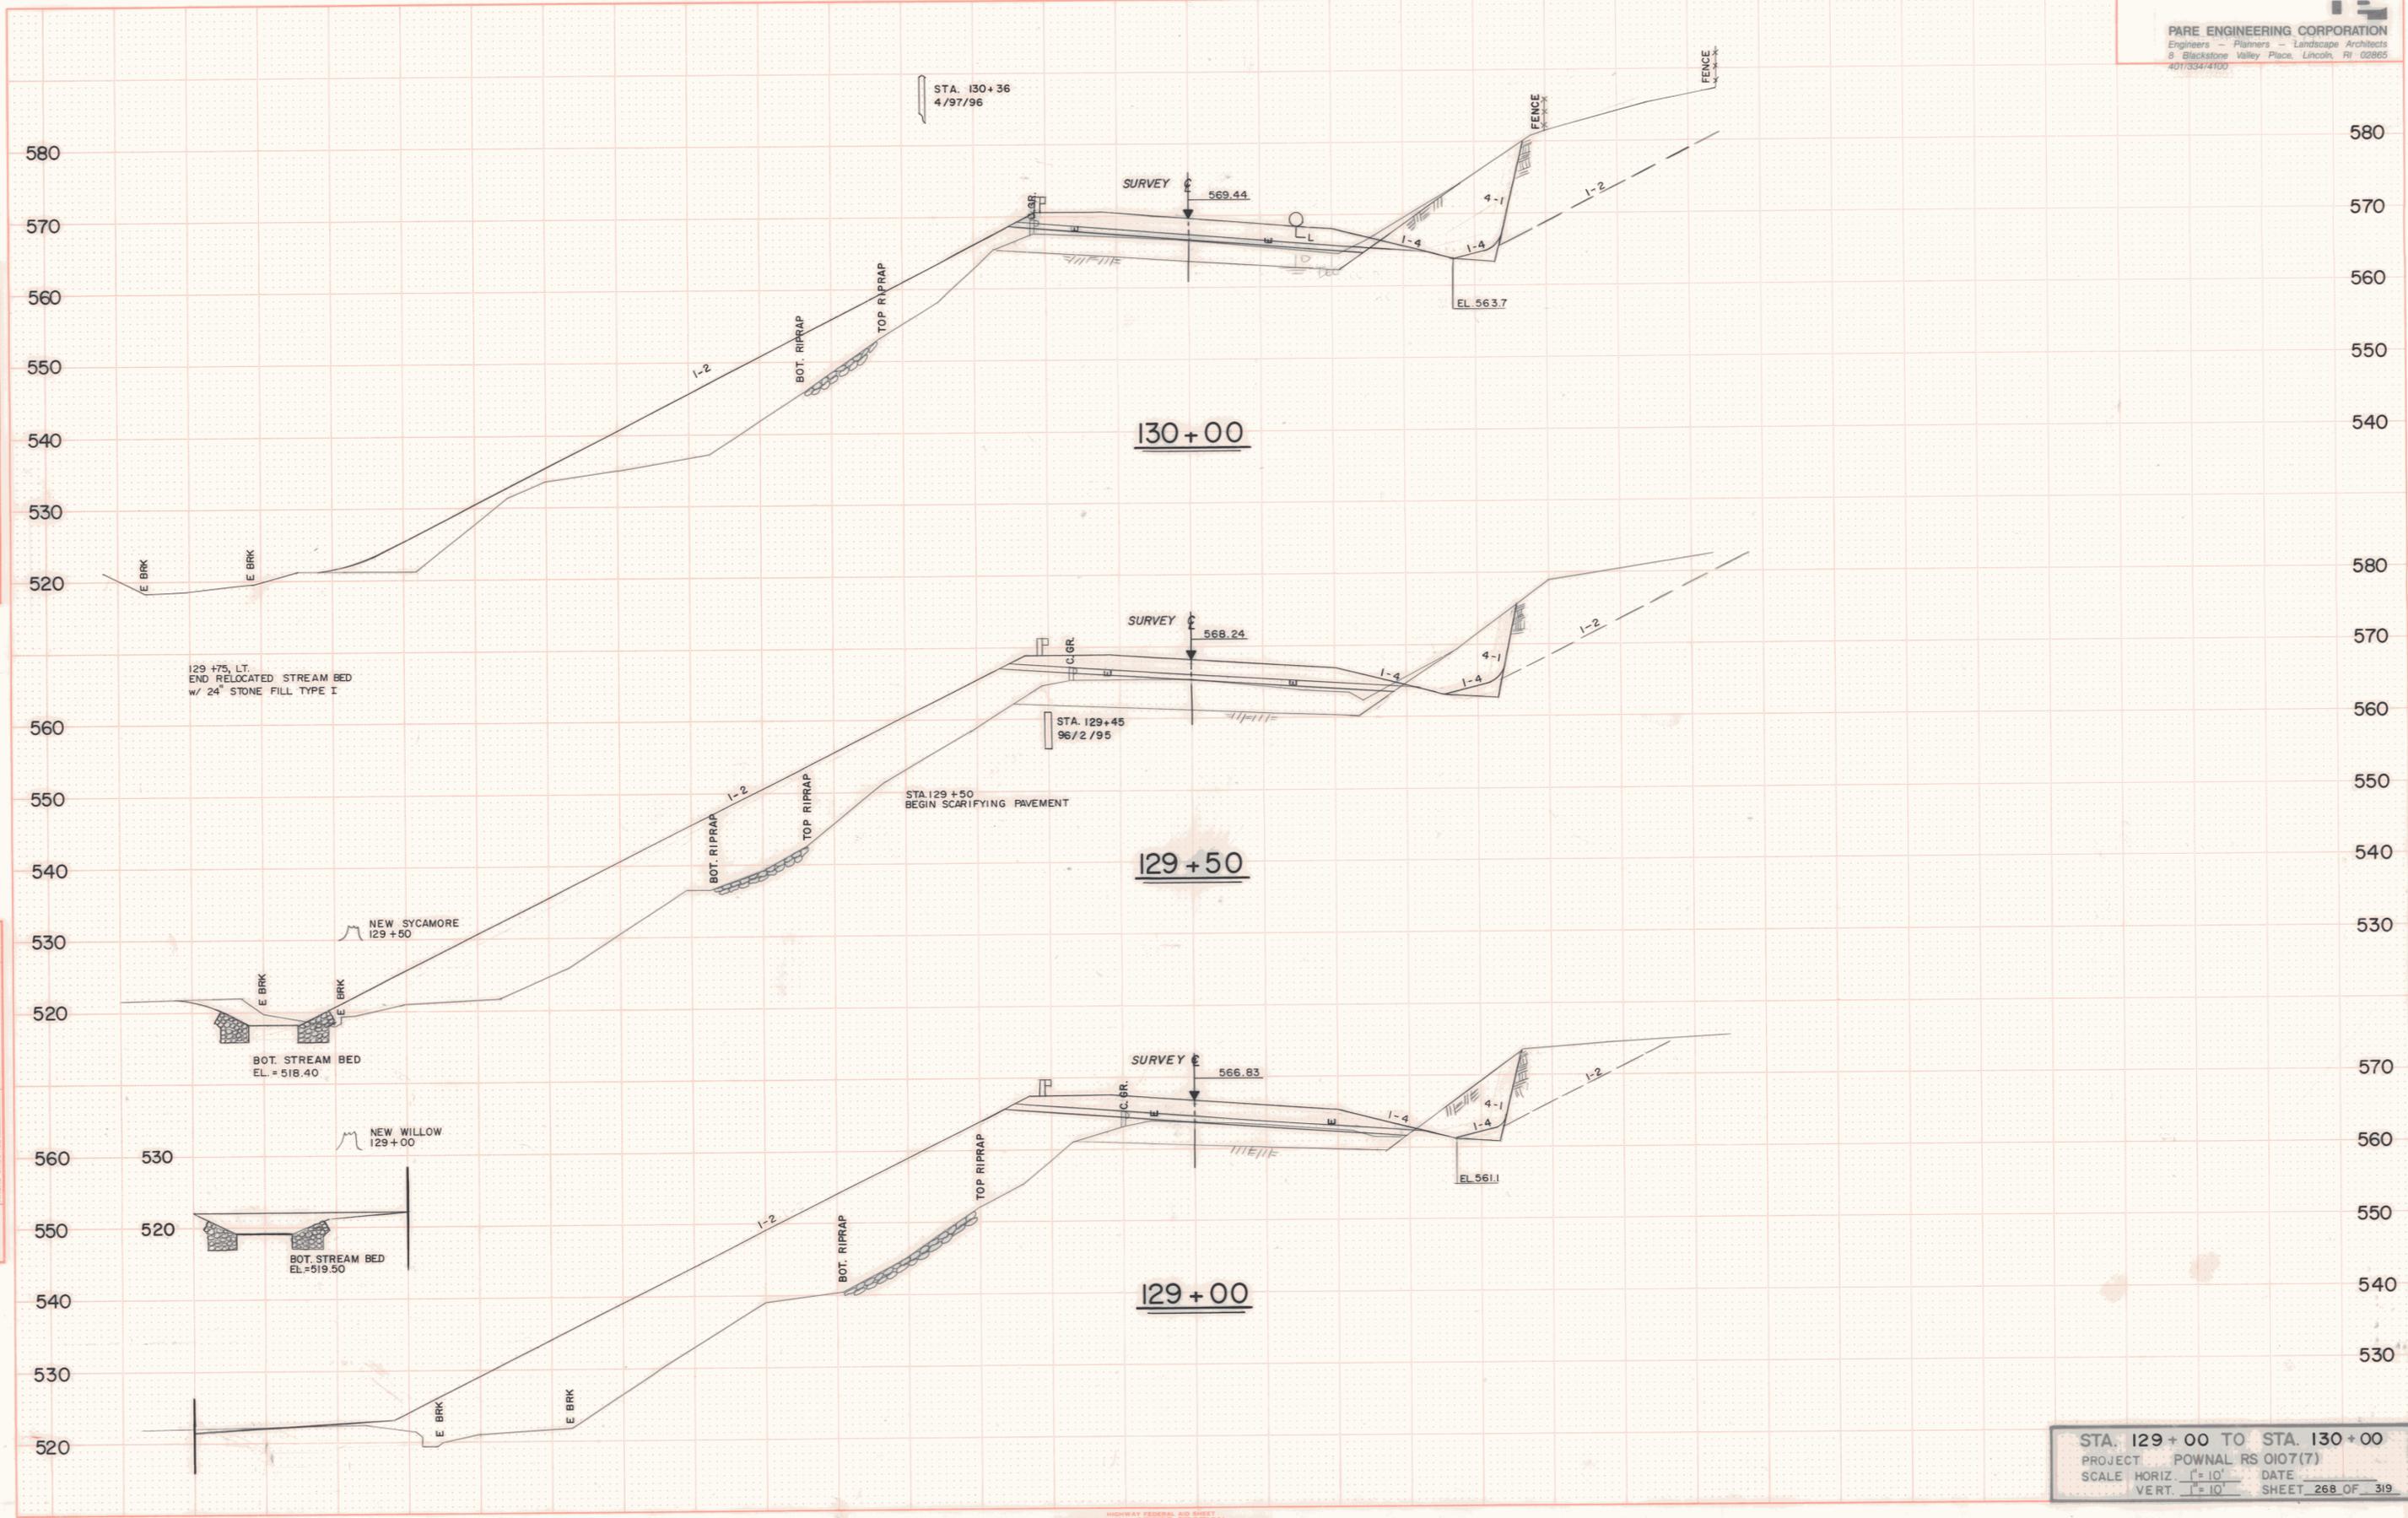

STA. 130+36
4/97/96

SURVEY
569.44

EL. 563.7

130+00

129+75, LT.
END RELOCATED STREAM BED
w/ 24" STONE FILL TYPE I

SURVEY
568.24

STA. 129+45
96/2/95

STA. 129+50
BEGIN SCARIFYING PAVEMENT

129+50

NEW SYCAMORE
129+50

BOT. STREAM BED
EL. = 518.40

SURVEY
566.83

EL. 561.1

NEW WILLOW
129+00

BOT. STREAM BED
EL. = 519.50

129+00

STA. 129+00 TO STA. 130+00
 PROJECT POWNAL RS 0107(7)
 SCALE HORIZ. 1"=10' DATE
 VERT. 1"=10' SHEET 268 OF 319