


BY _____ DATE _____
 ORIGINAL SURVEY PLOTTED _____
 NOTE BOOK TEMPLATE _____
 NO. _____

BY _____ DATE _____
 ORIGINAL SURVEY PLOTTED _____
 NOTE BOOK TEMPLATE _____
 NO. _____

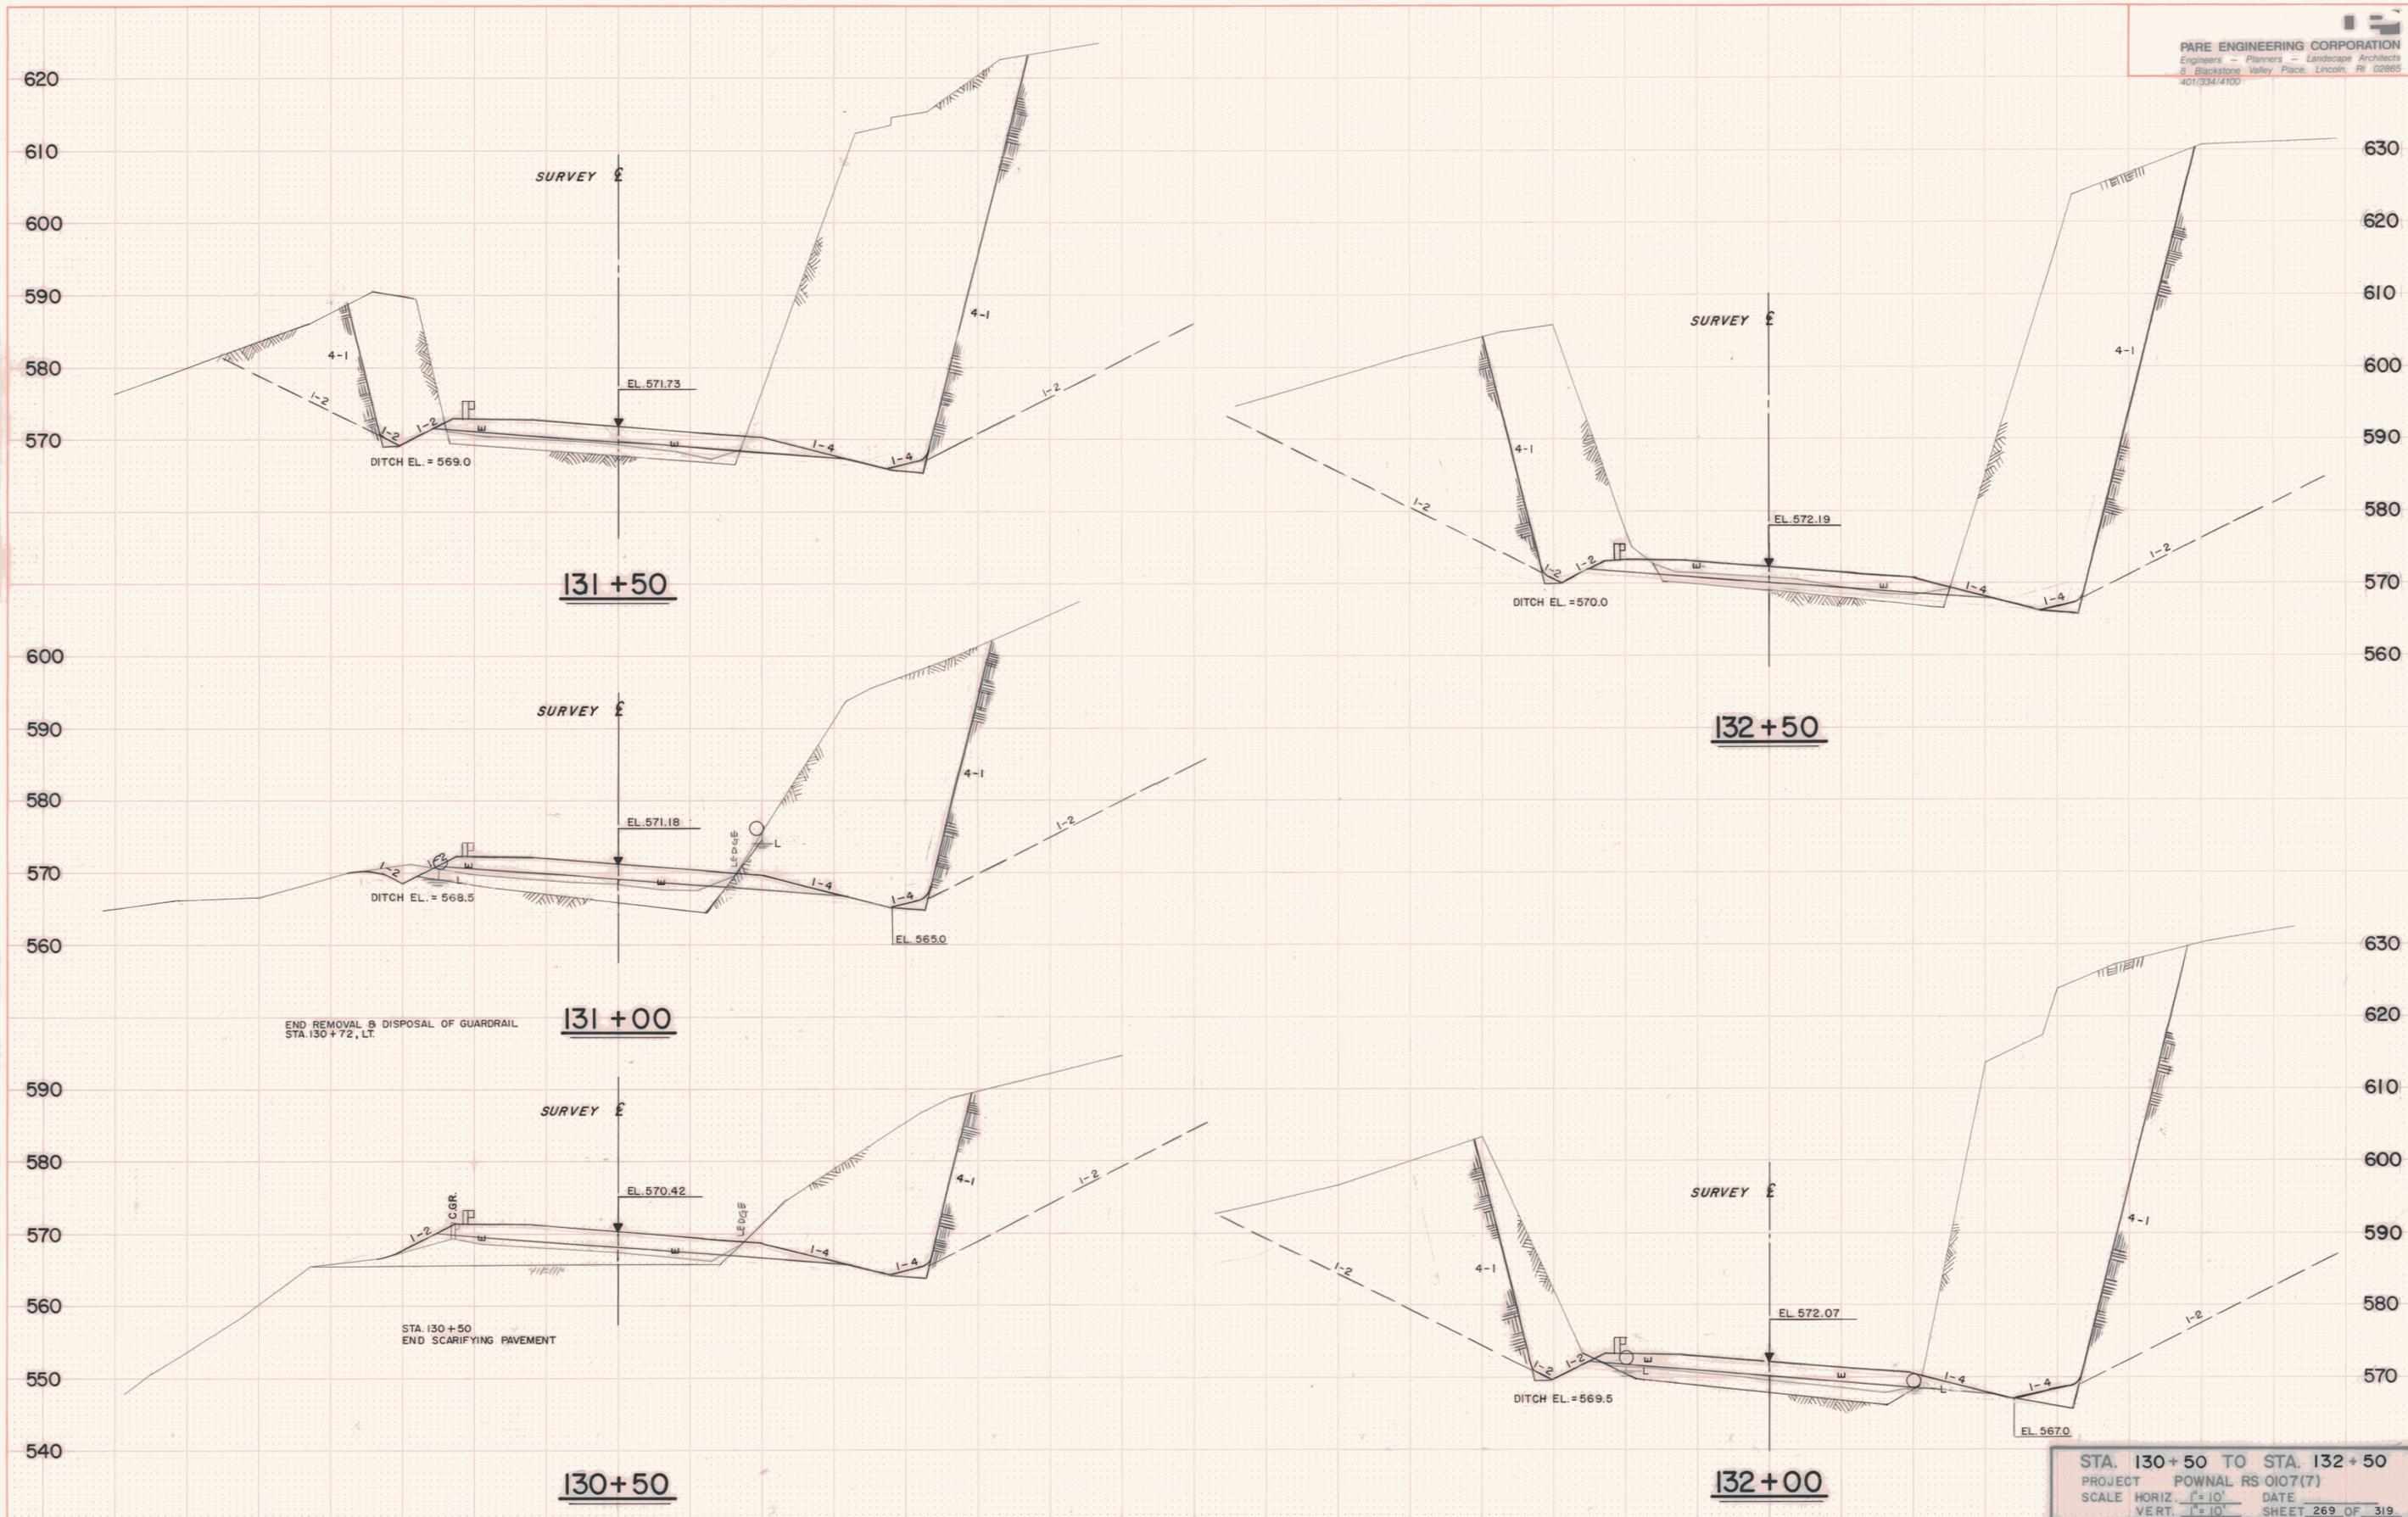

STA. 130+50 TO STA. 132+50
 PROJECT POWNAL RS 0107(7)
 SCALE HORIZ. 1"=10' DATE _____
 VERT. 1"=10' SHEET 269 OF 319