


FINAL SURVEY BY DATE
 SURVEY PLOTTED
 NOTE BOOK NO. AREAS CHECKED

ORIGINAL SURVEY BY DATE
 SURVEY PLOTTED
 NOTE BOOK NO. AREAS CHECKED

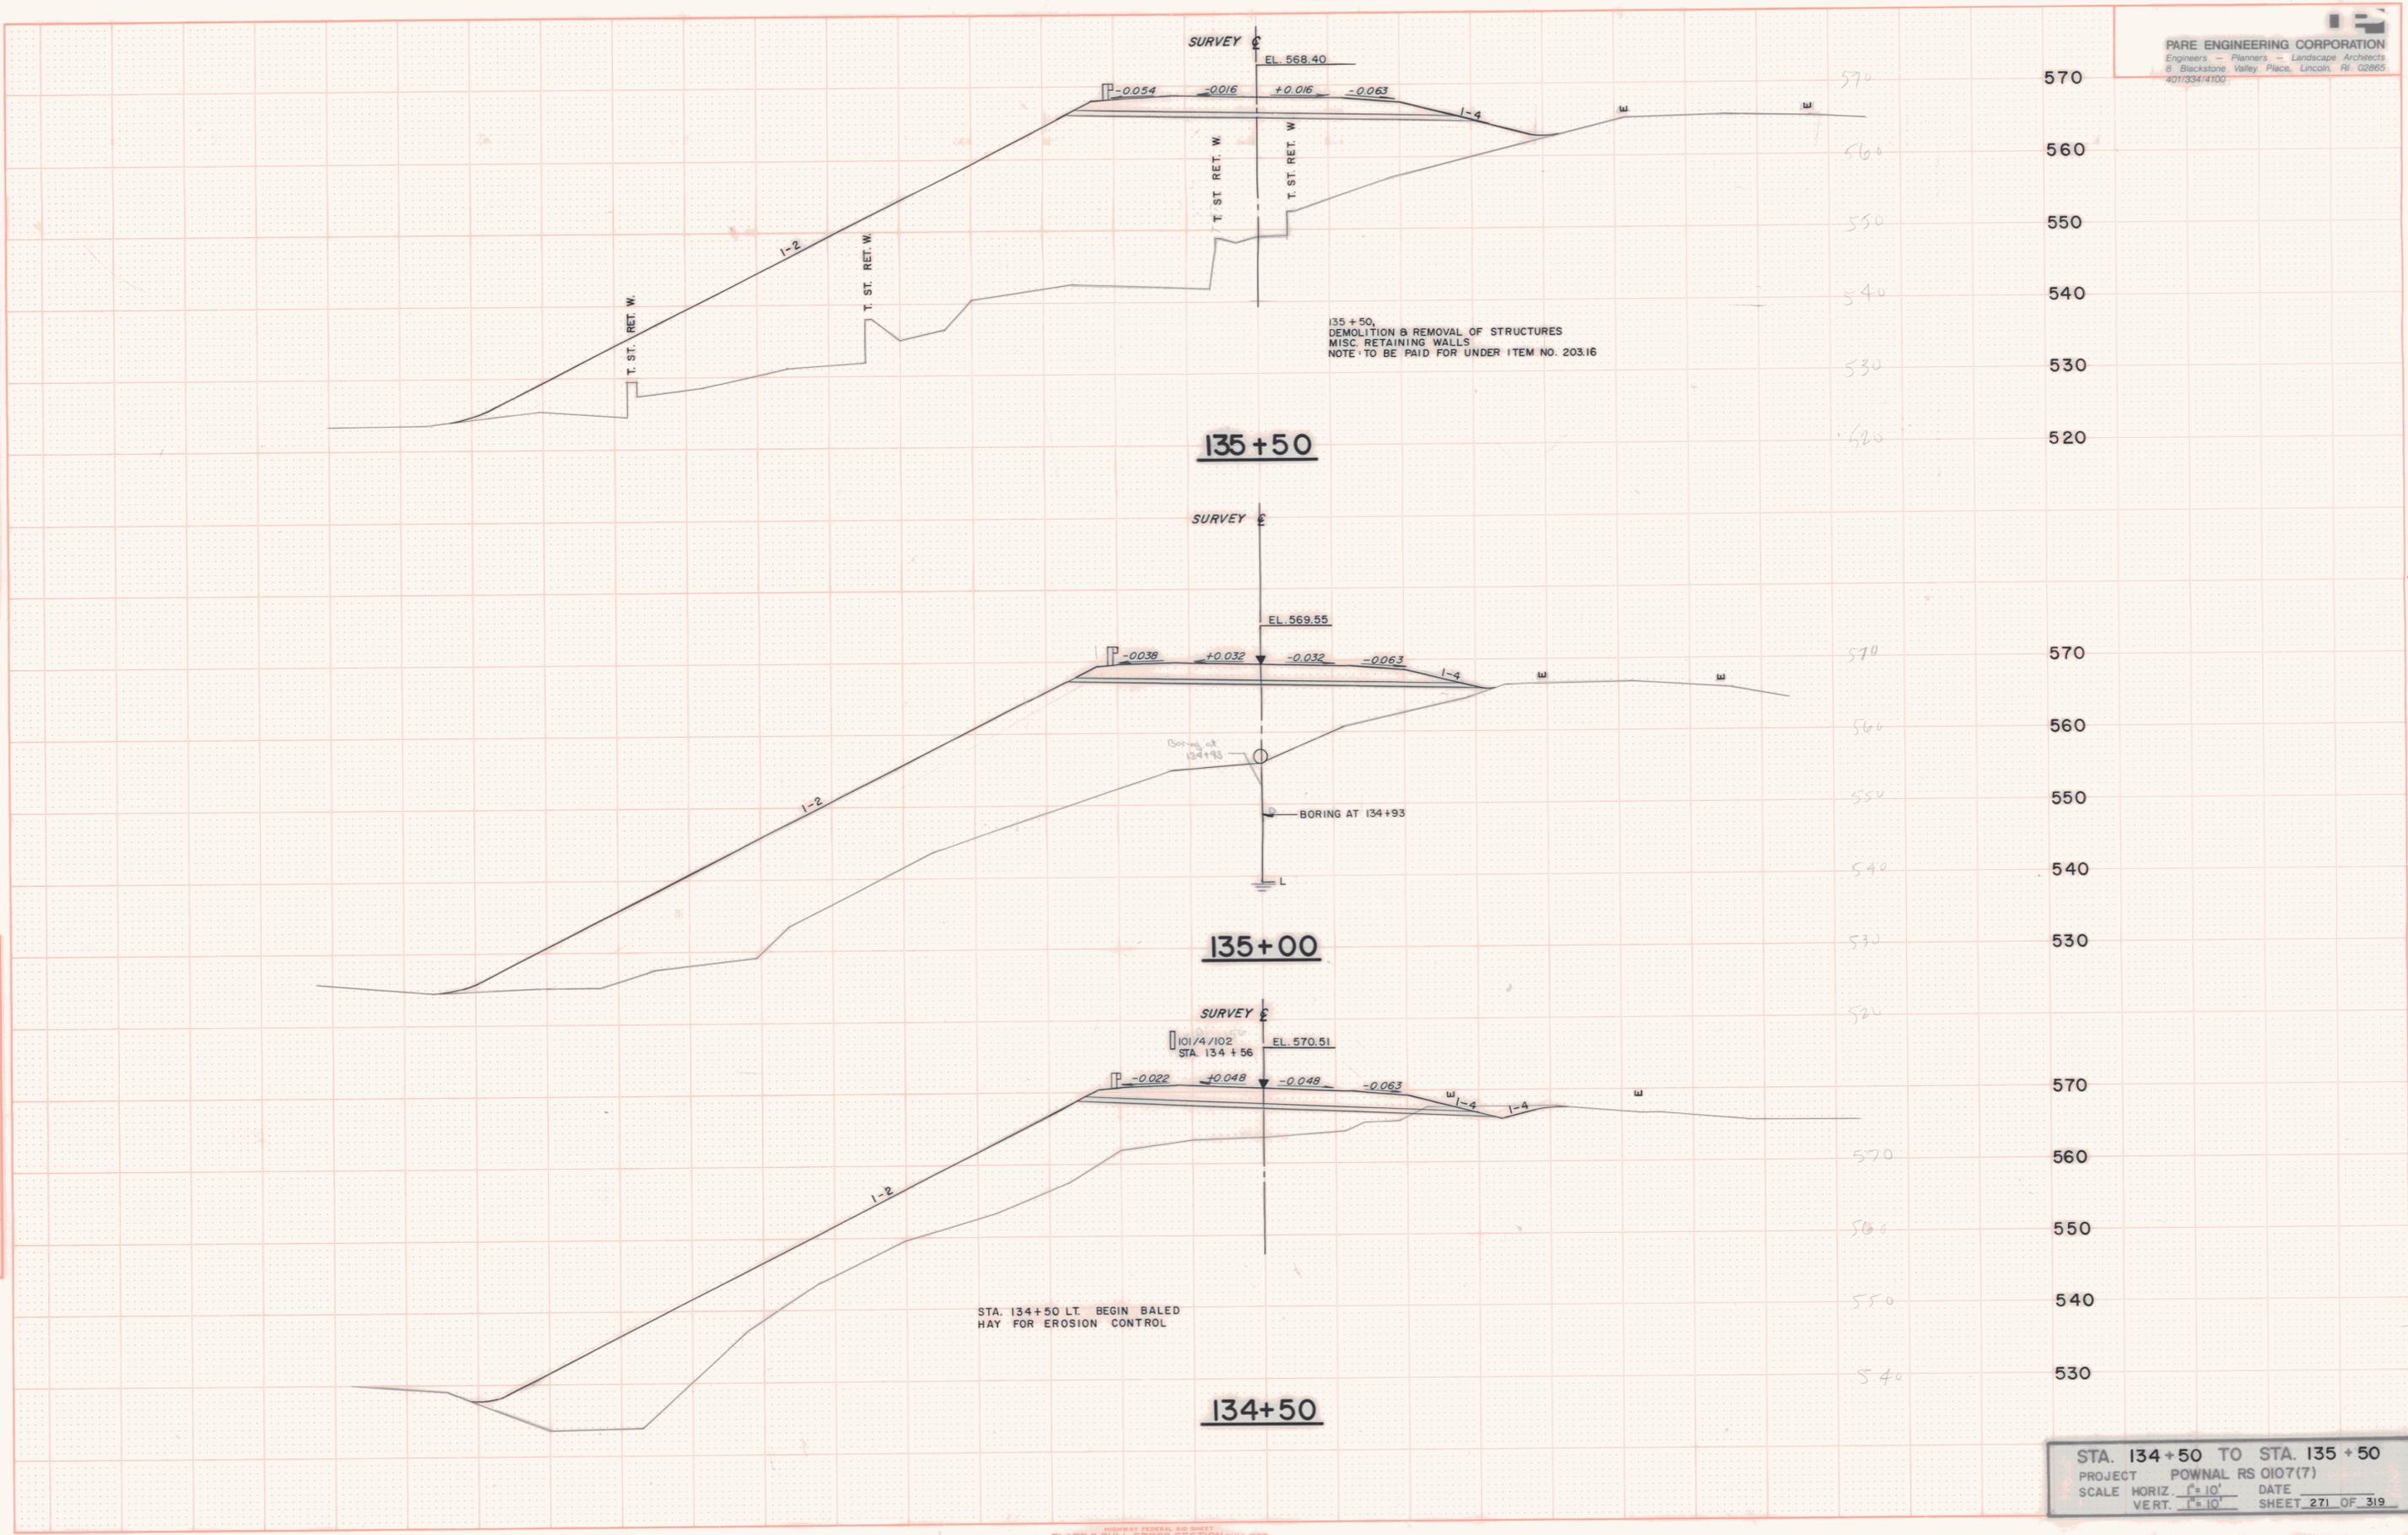

STA. 134+50 TO STA. 135+50
 PROJECT POWNAL RS 0107(7)
 SCALE HORIZ. 1"=10' DATE
 VERT. 1"=10' SHEET 271 OF 319

PS
 12/14