
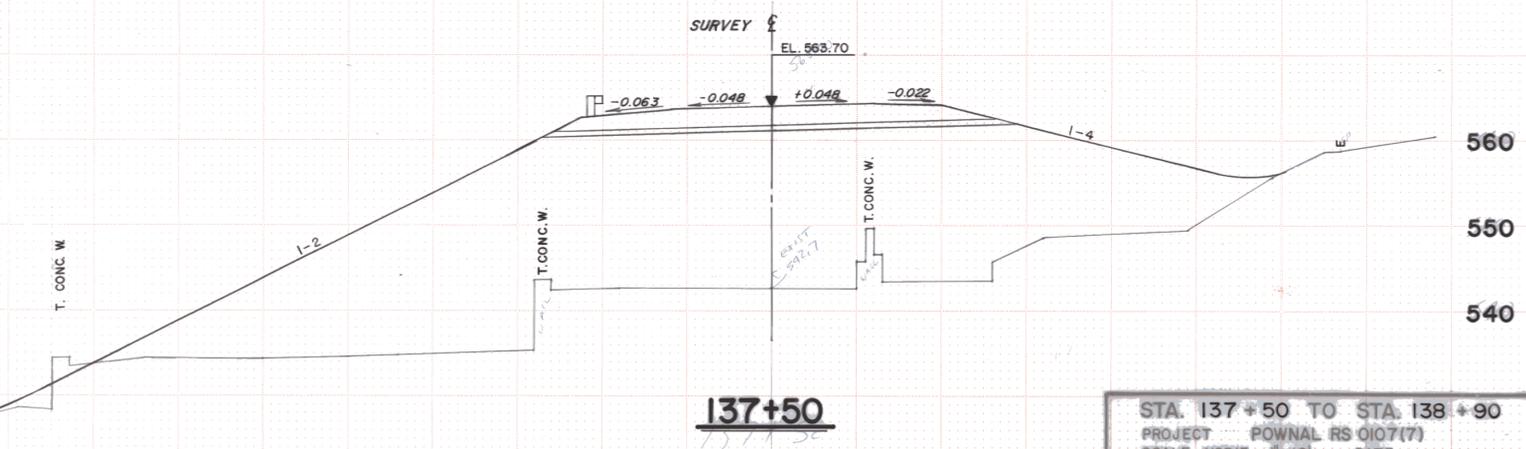
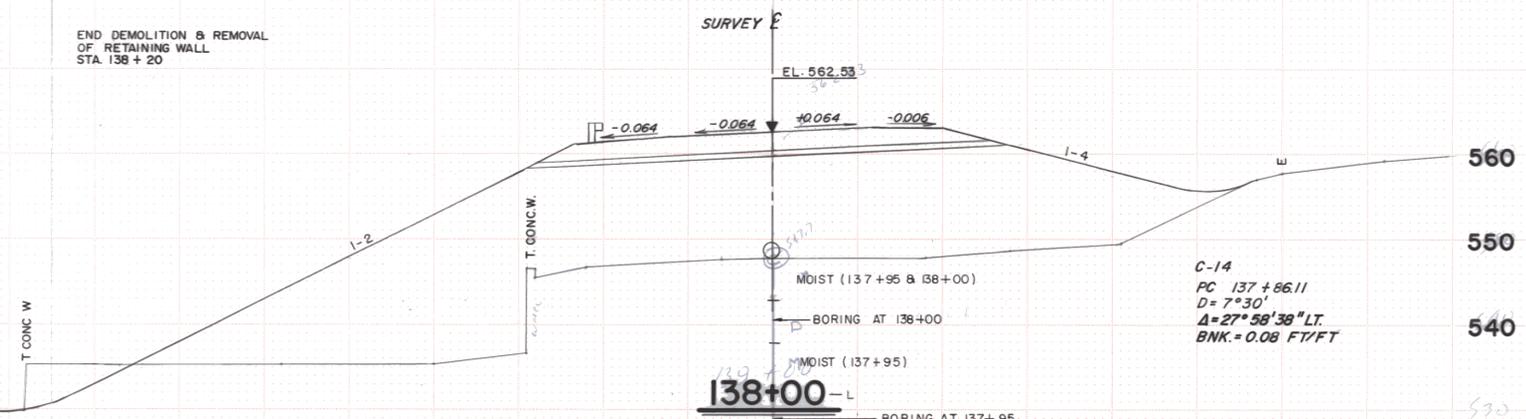
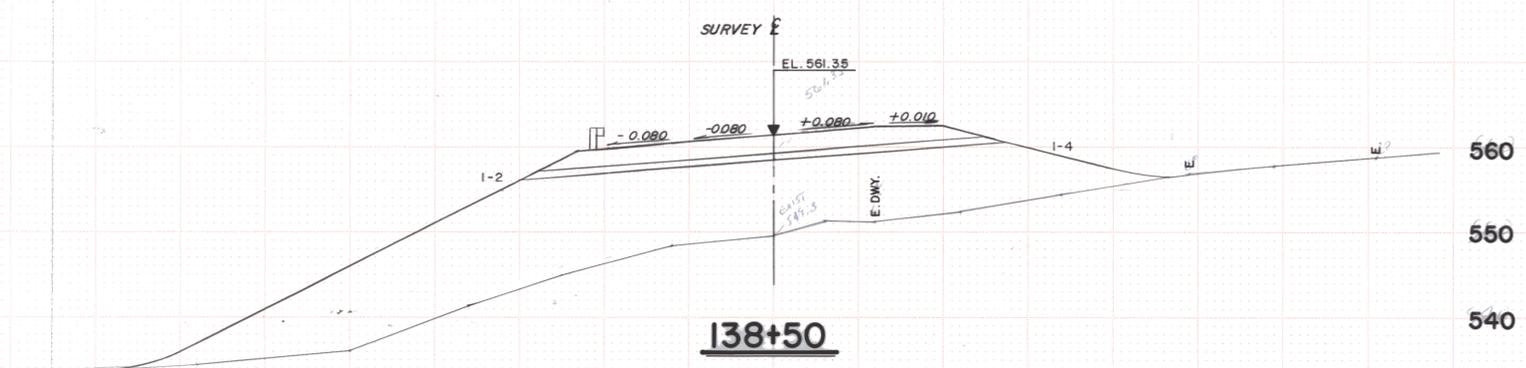
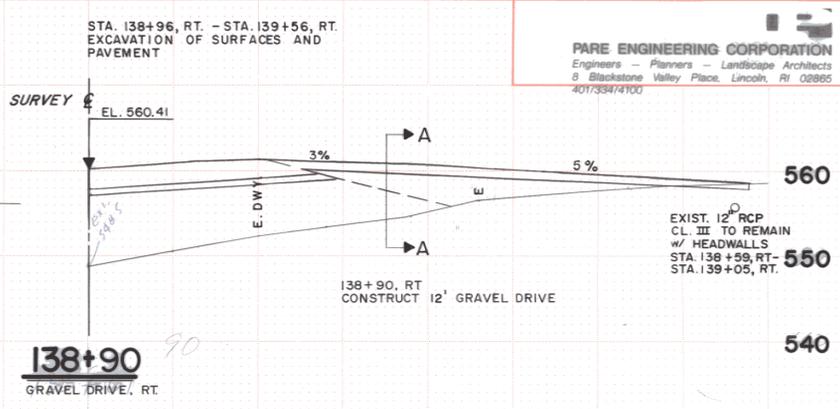
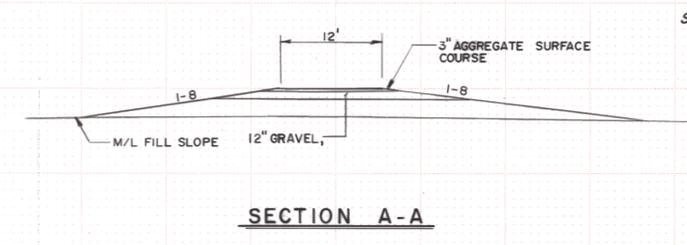


FINAL SURVEY BY DATE  
 SURVEY PLOTTED BY DATE  
 NOTE BOOK NO. TEMPLATE NO.  
 AREA CHECKED

ORIGINAL SURVEY BY DATE  
 SURVEY PLOTTED BY DATE  
 NOTE BOOK NO. TEMPLATE NO.  
 AREA CHECKED

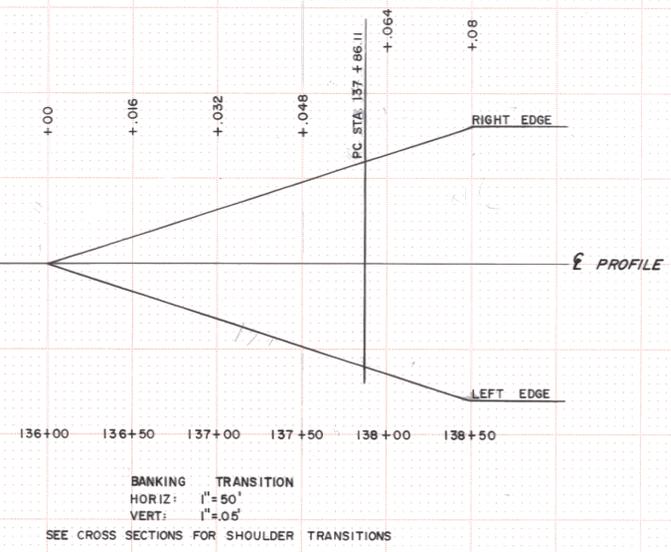

STA. 137+50 TO STA. 138+90  
 PROJECT POWNAL RS 0107(7)  
 SCALE HORIZ. 1"=10' DATE  
 VERT. 1"=10' SHEET 273 OF 319