


FINAL SURVEY PLOTTED
 NOTE BOOK TEMPLATE NO. 1
 DATE: _____

ORIGINAL SURVEY PLOTTED
 NOTE BOOK TEMPLATE NO. 1
 DATE: _____

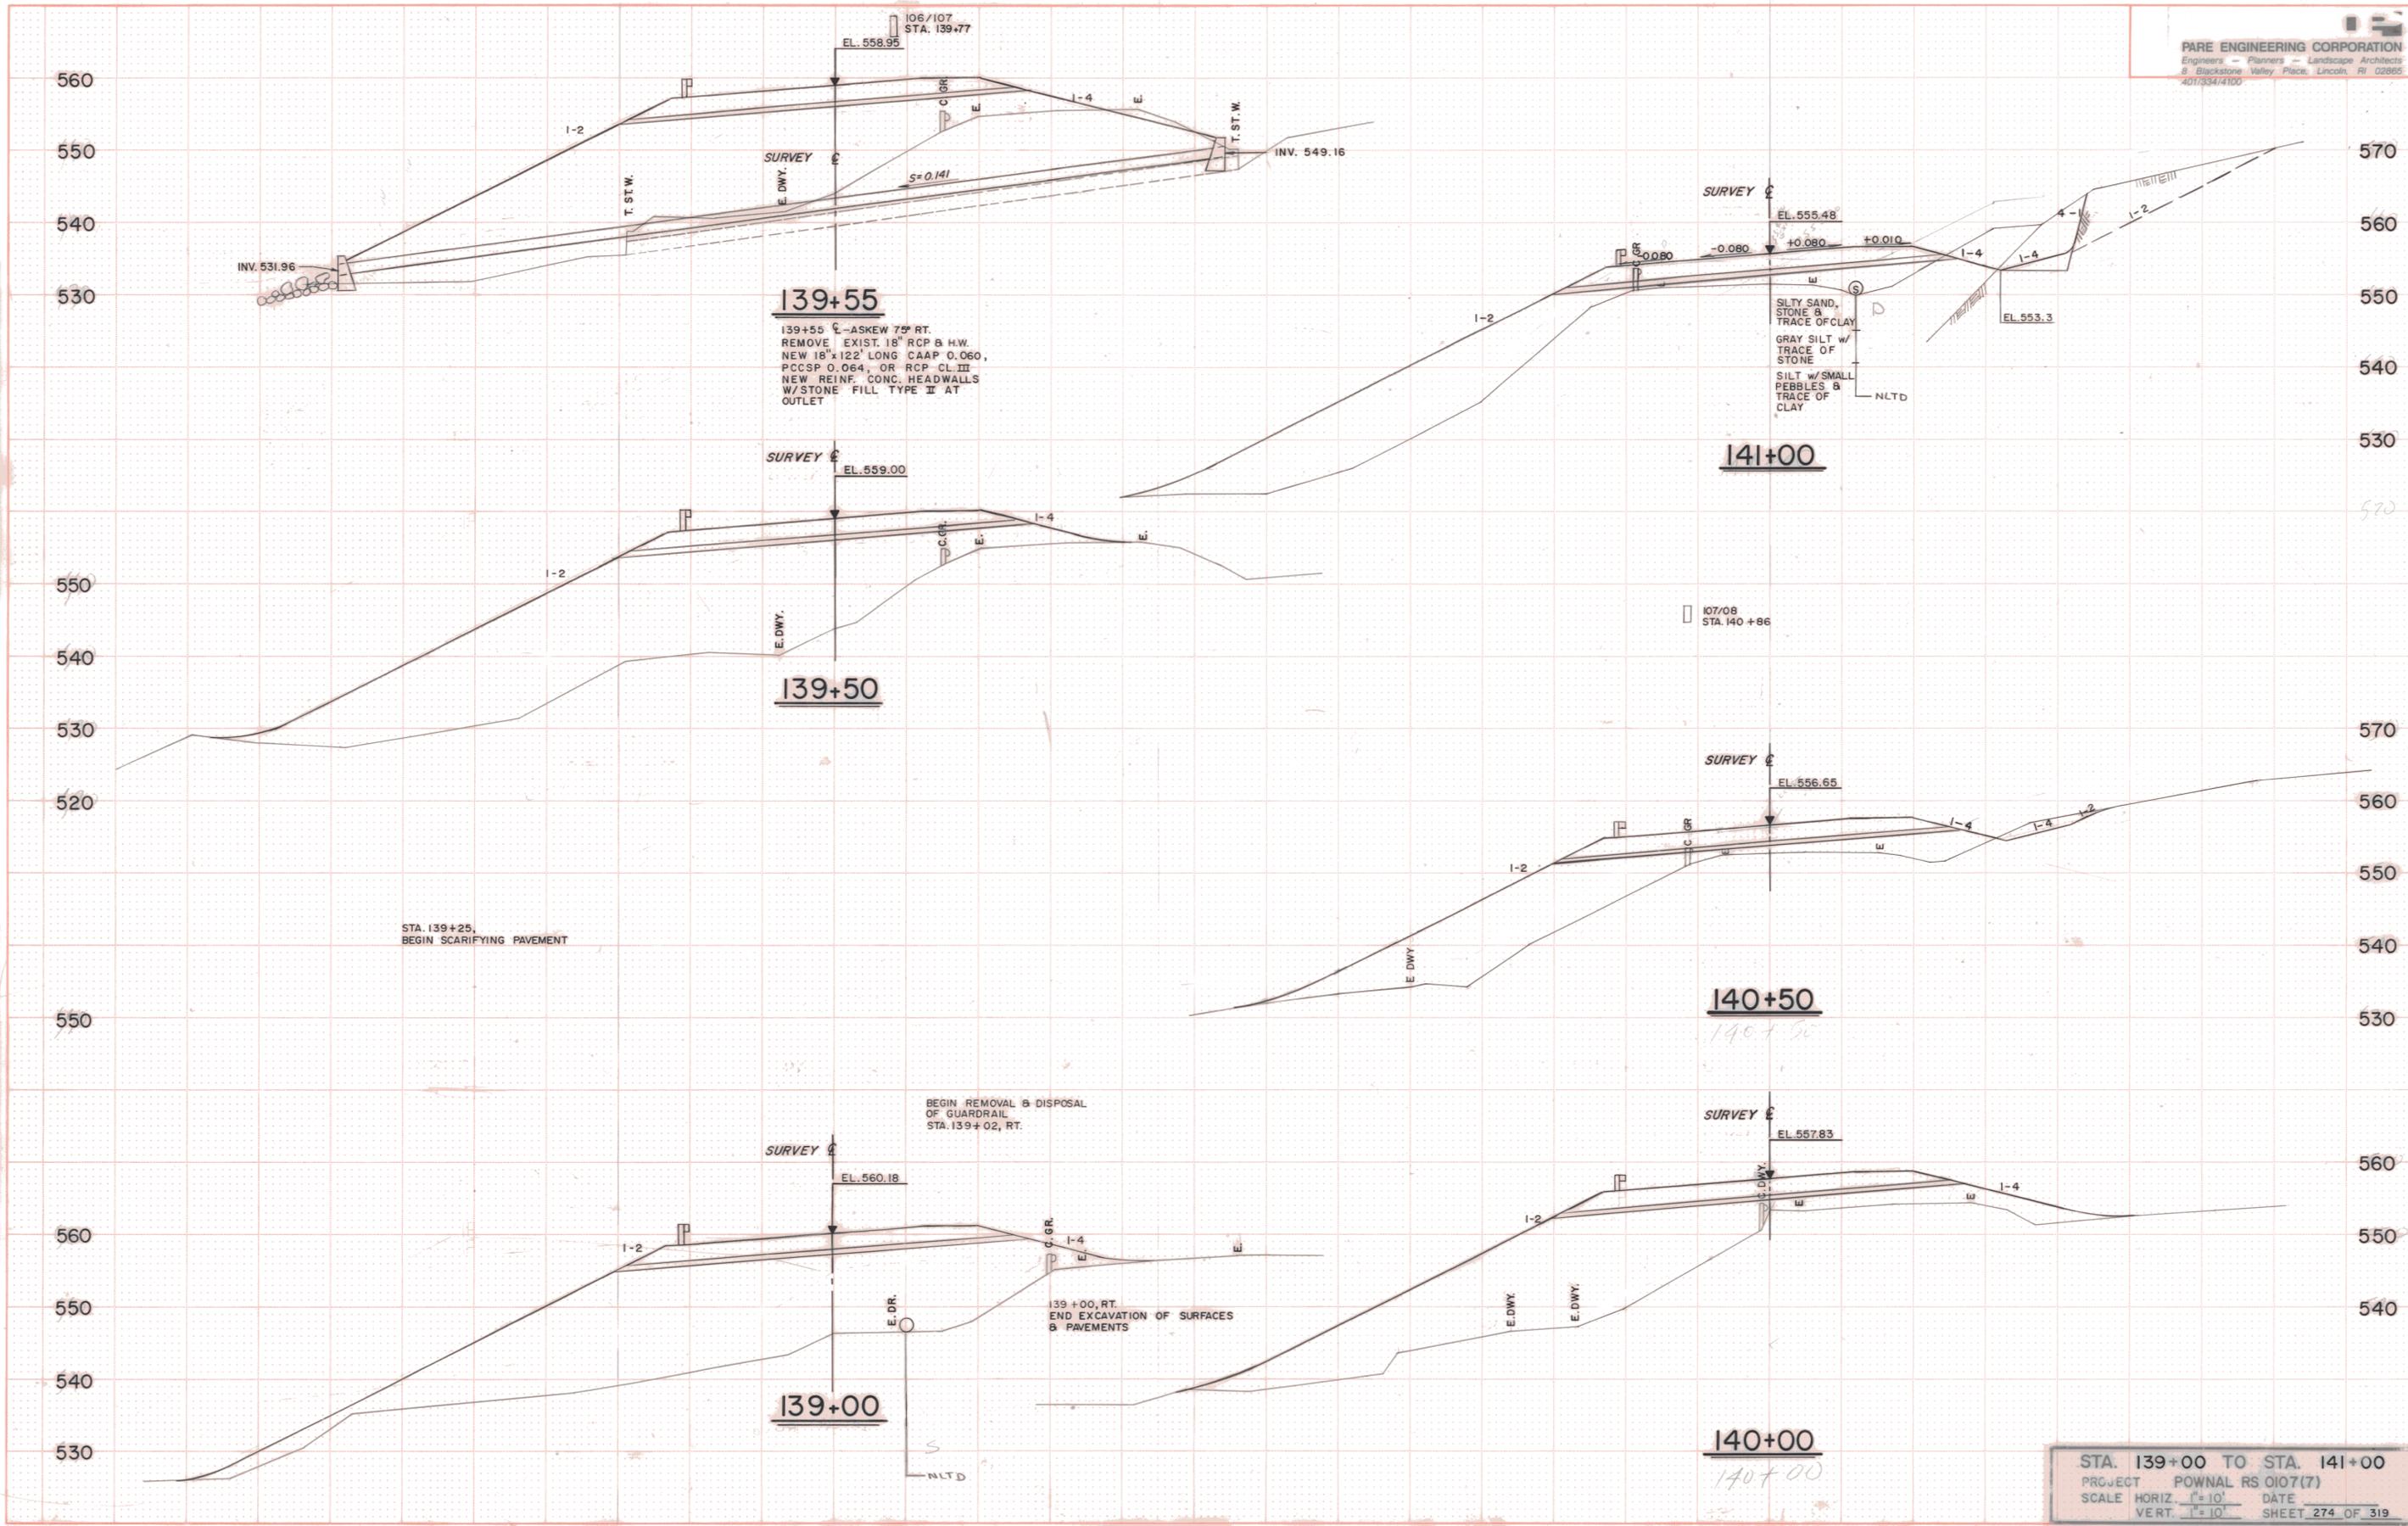

STA. 139+00 TO STA. 141+00
 PROJECT POWNAL RS 0107(7)
 SCALE HORIZ. 1" = 10'
 VERT. 1" = 10' DATE _____ SHEET 274 OF 319