


FINAL SURVEY PLOTTED
 NOTE BOOK TEMPLATE
 NO. 114 STA. 147+49

ORIGINAL SURVEY PLOTTED
 NOTE BOOK TEMPLATE
 NO. 112 STA. 146+42

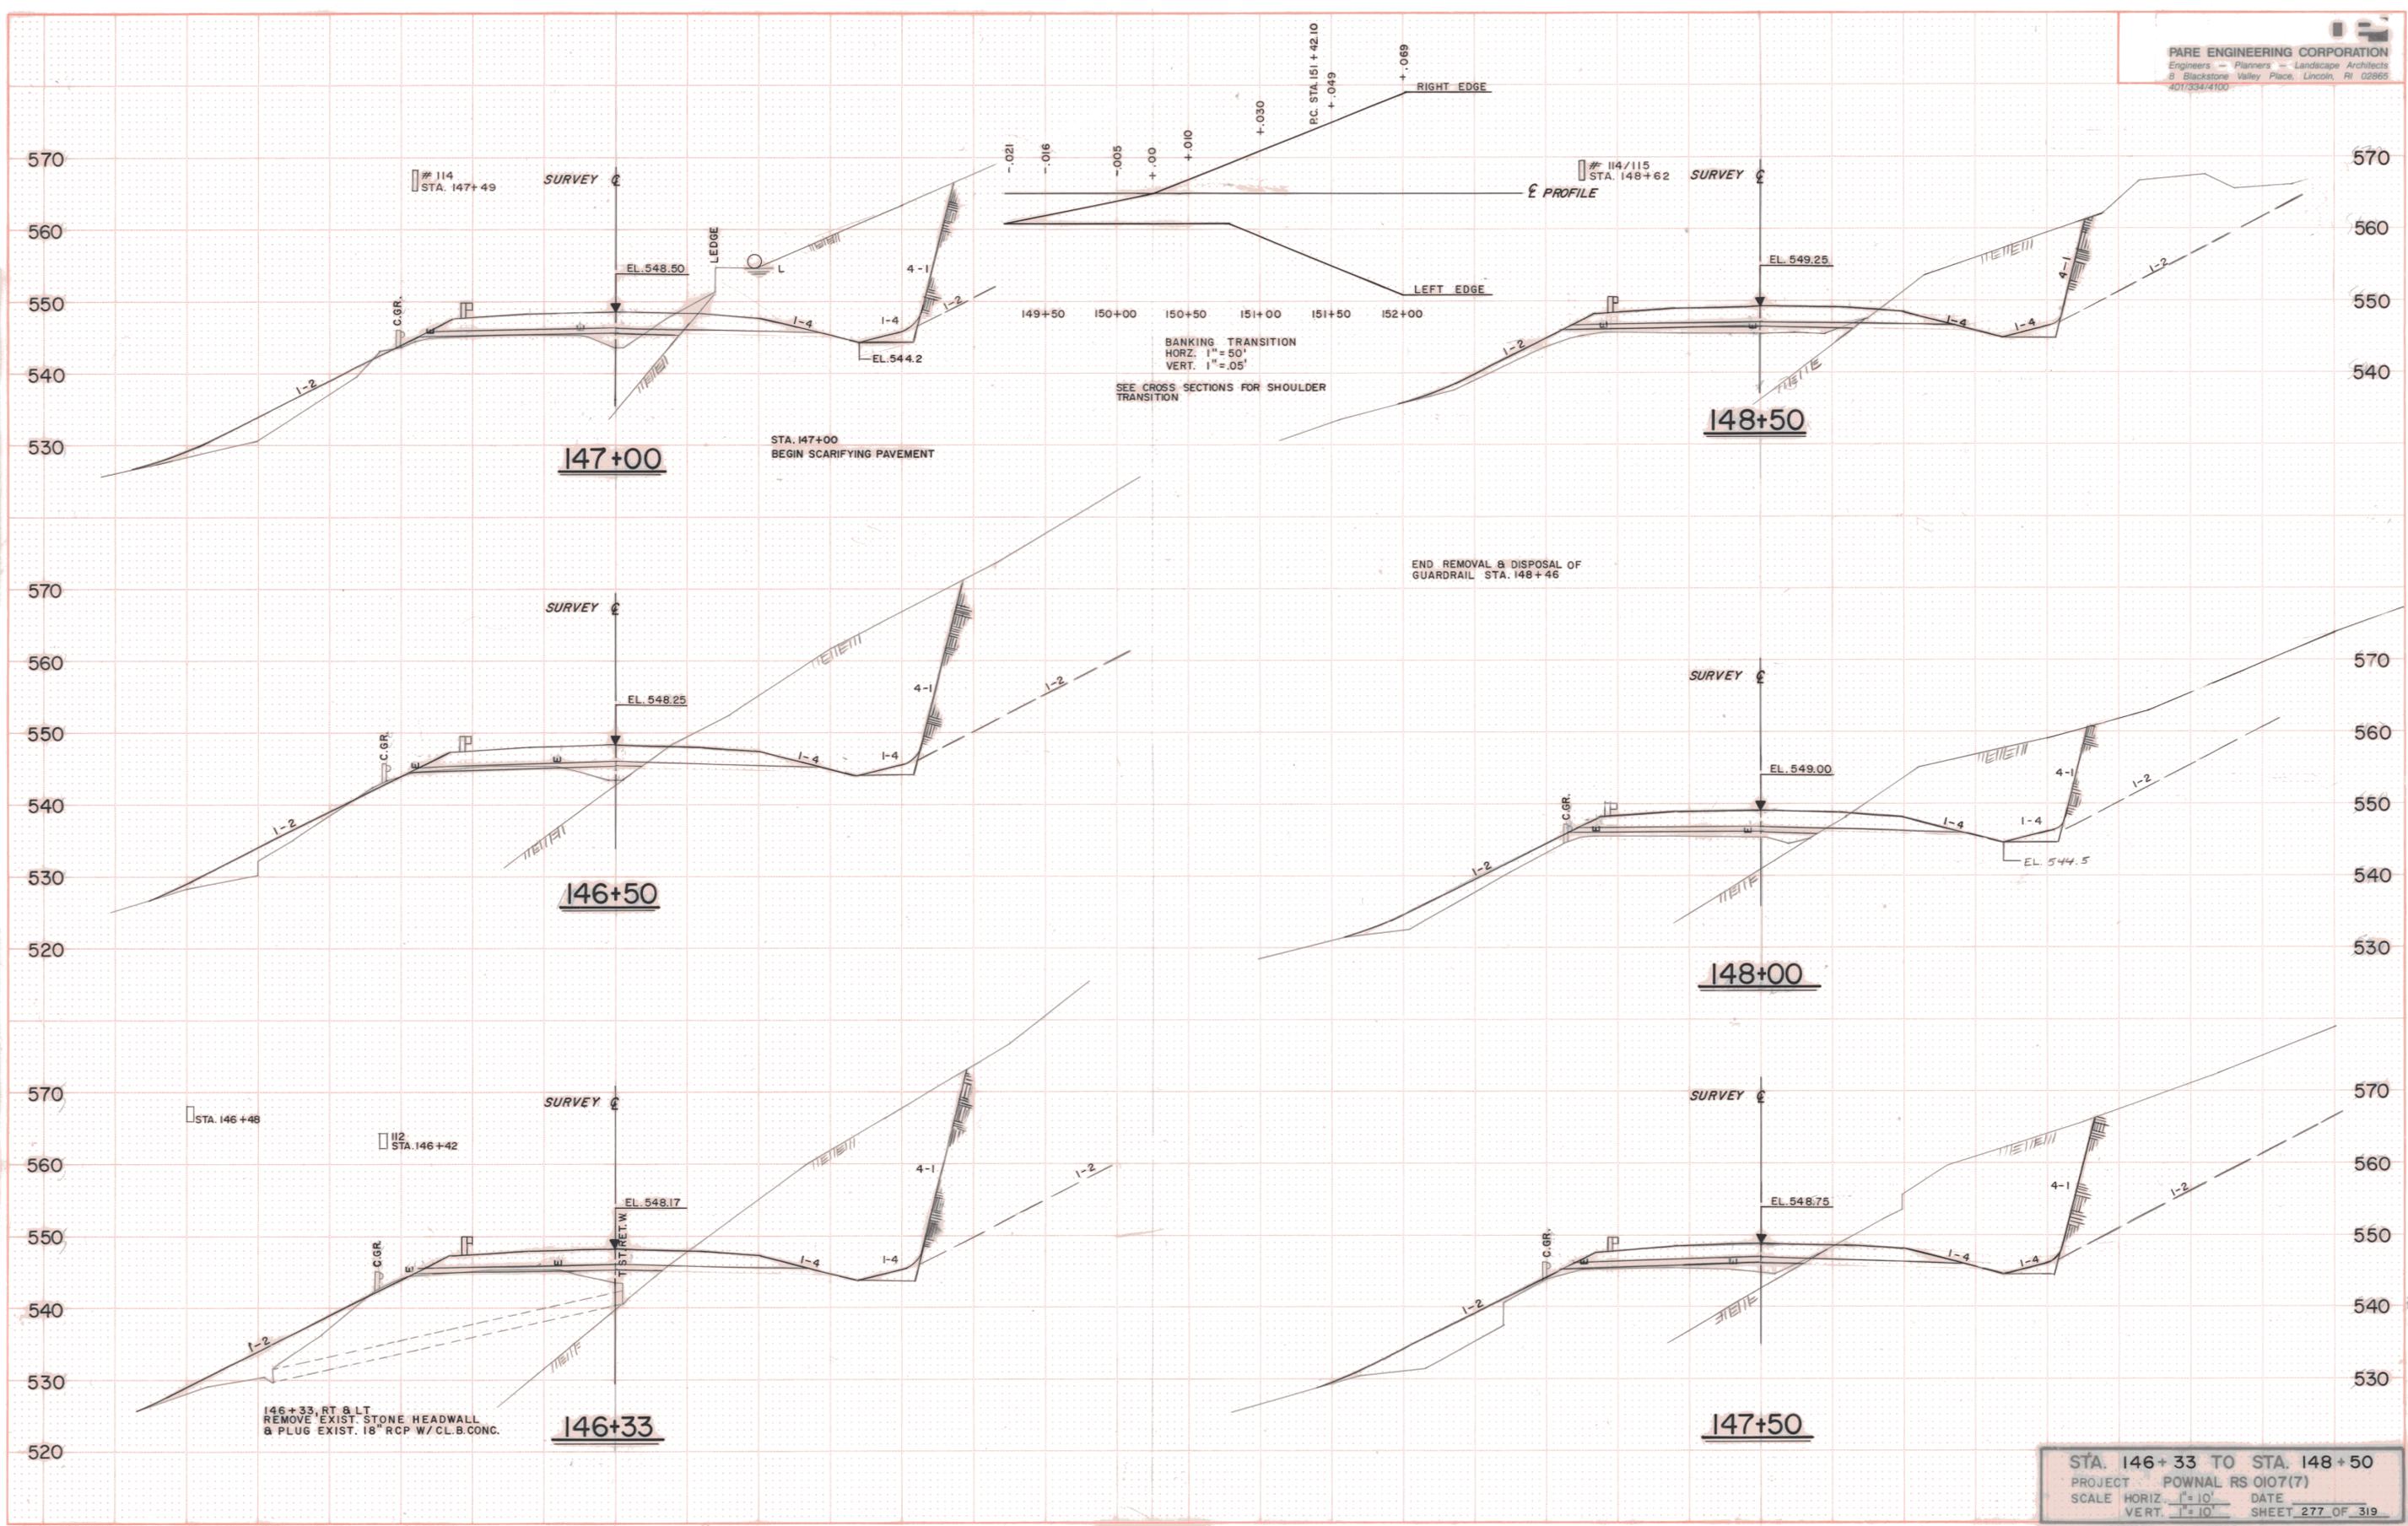

146+33, RT & LT
 REMOVE EXIST. STONE HEADWALL
 & PLUG EXIST. 18" RCP W/CL.B.CONC.

BANKING TRANSITION
 HORZ. 1" = 50'
 VERT. 1" = .05'
 SEE CROSS SECTIONS FOR SHOULDER TRANSITION

END REMOVAL & DISPOSAL OF
 GUARDRAIL STA. 148+46

STA. 146+33 TO STA. 148+50
 PROJECT POWNAL RS 0107(7)
 SCALE HORIZ. 1" = 10' DATE
 VERT. 1" = 10' SHEET 277 OF 319