


ORIGINAL SURVEY
 DATE: _____
 BY: _____
 CHECKED: _____
 IN CHARGE: _____
 NO. _____

ORIGINAL SURVEY
 DATE: _____
 BY: _____
 CHECKED: _____
 IN CHARGE: _____
 NO. _____

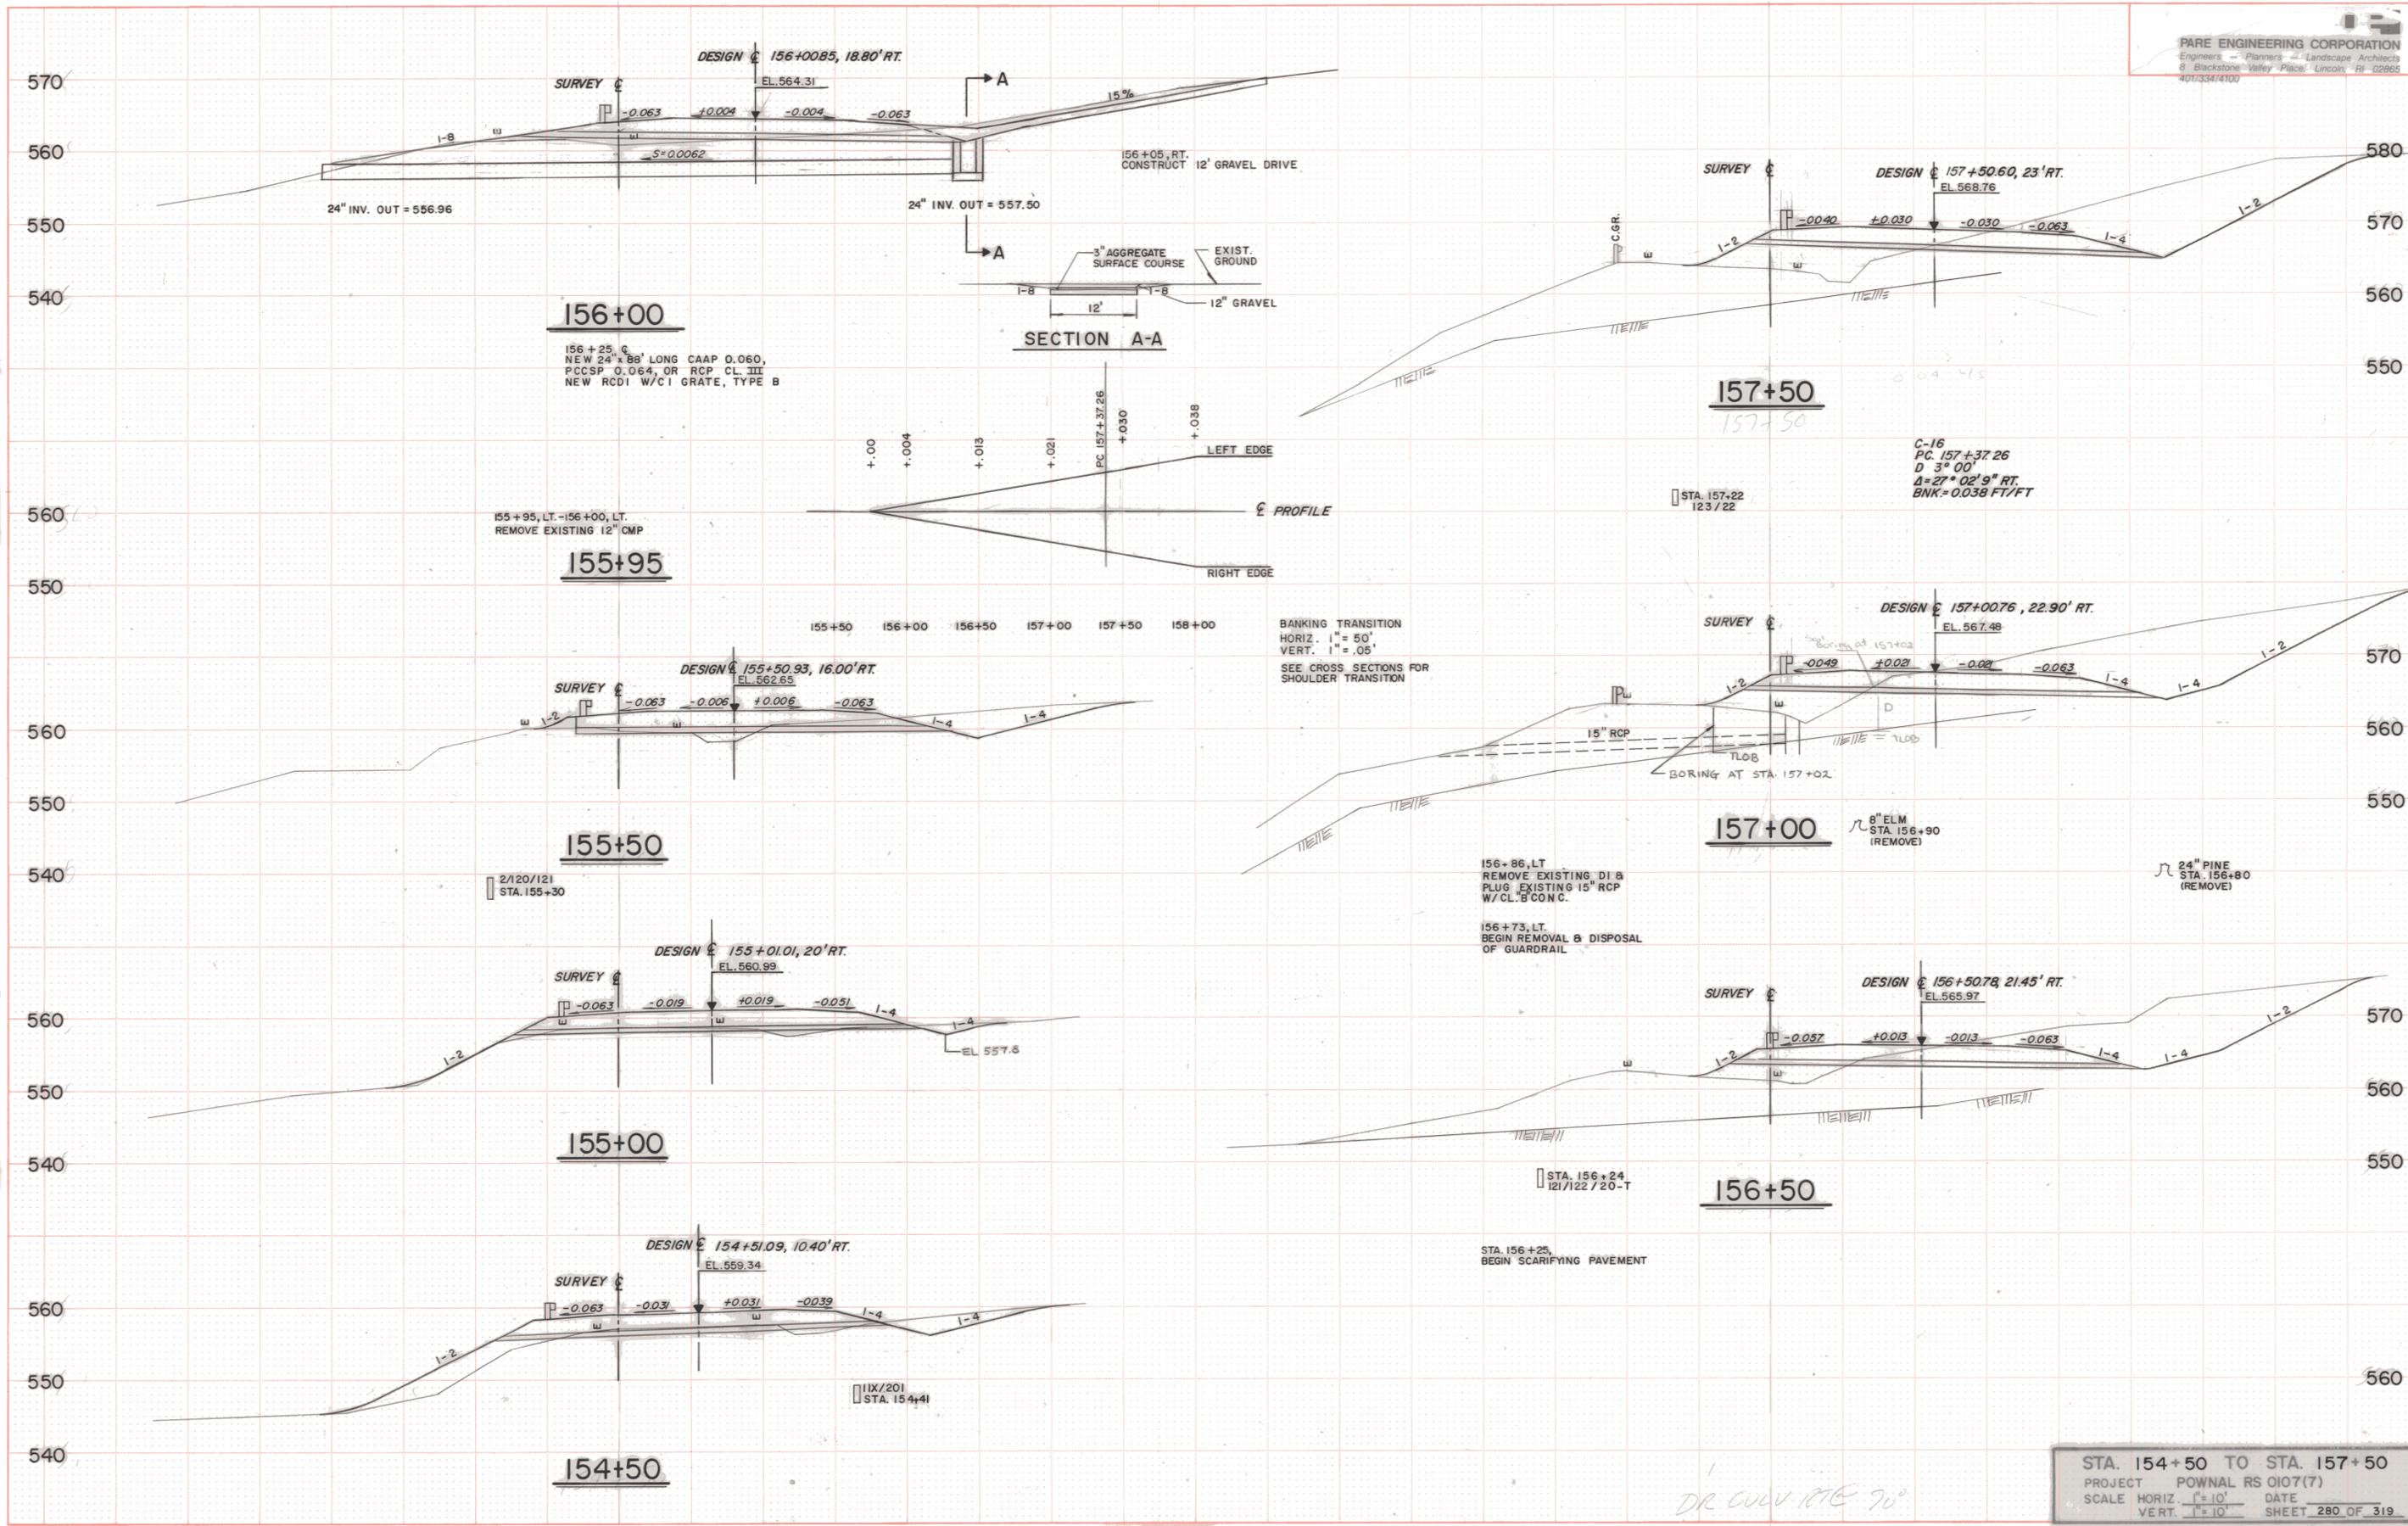

BANKING TRANSITION
 HORIZ. 1" = 50'
 VERT. 1" = .05'
 SEE CROSS SECTIONS FOR
 SHOULDER TRANSITION

DR. CULV. 10/6 70°