


DATE	
BY	
REVISION	
NO.	
DESCRIPTION	
DATE	
BY	
REVISION	
NO.	
DESCRIPTION	

DATE	
BY	
REVISION	
NO.	
DESCRIPTION	
DATE	
BY	
REVISION	
NO.	
DESCRIPTION	

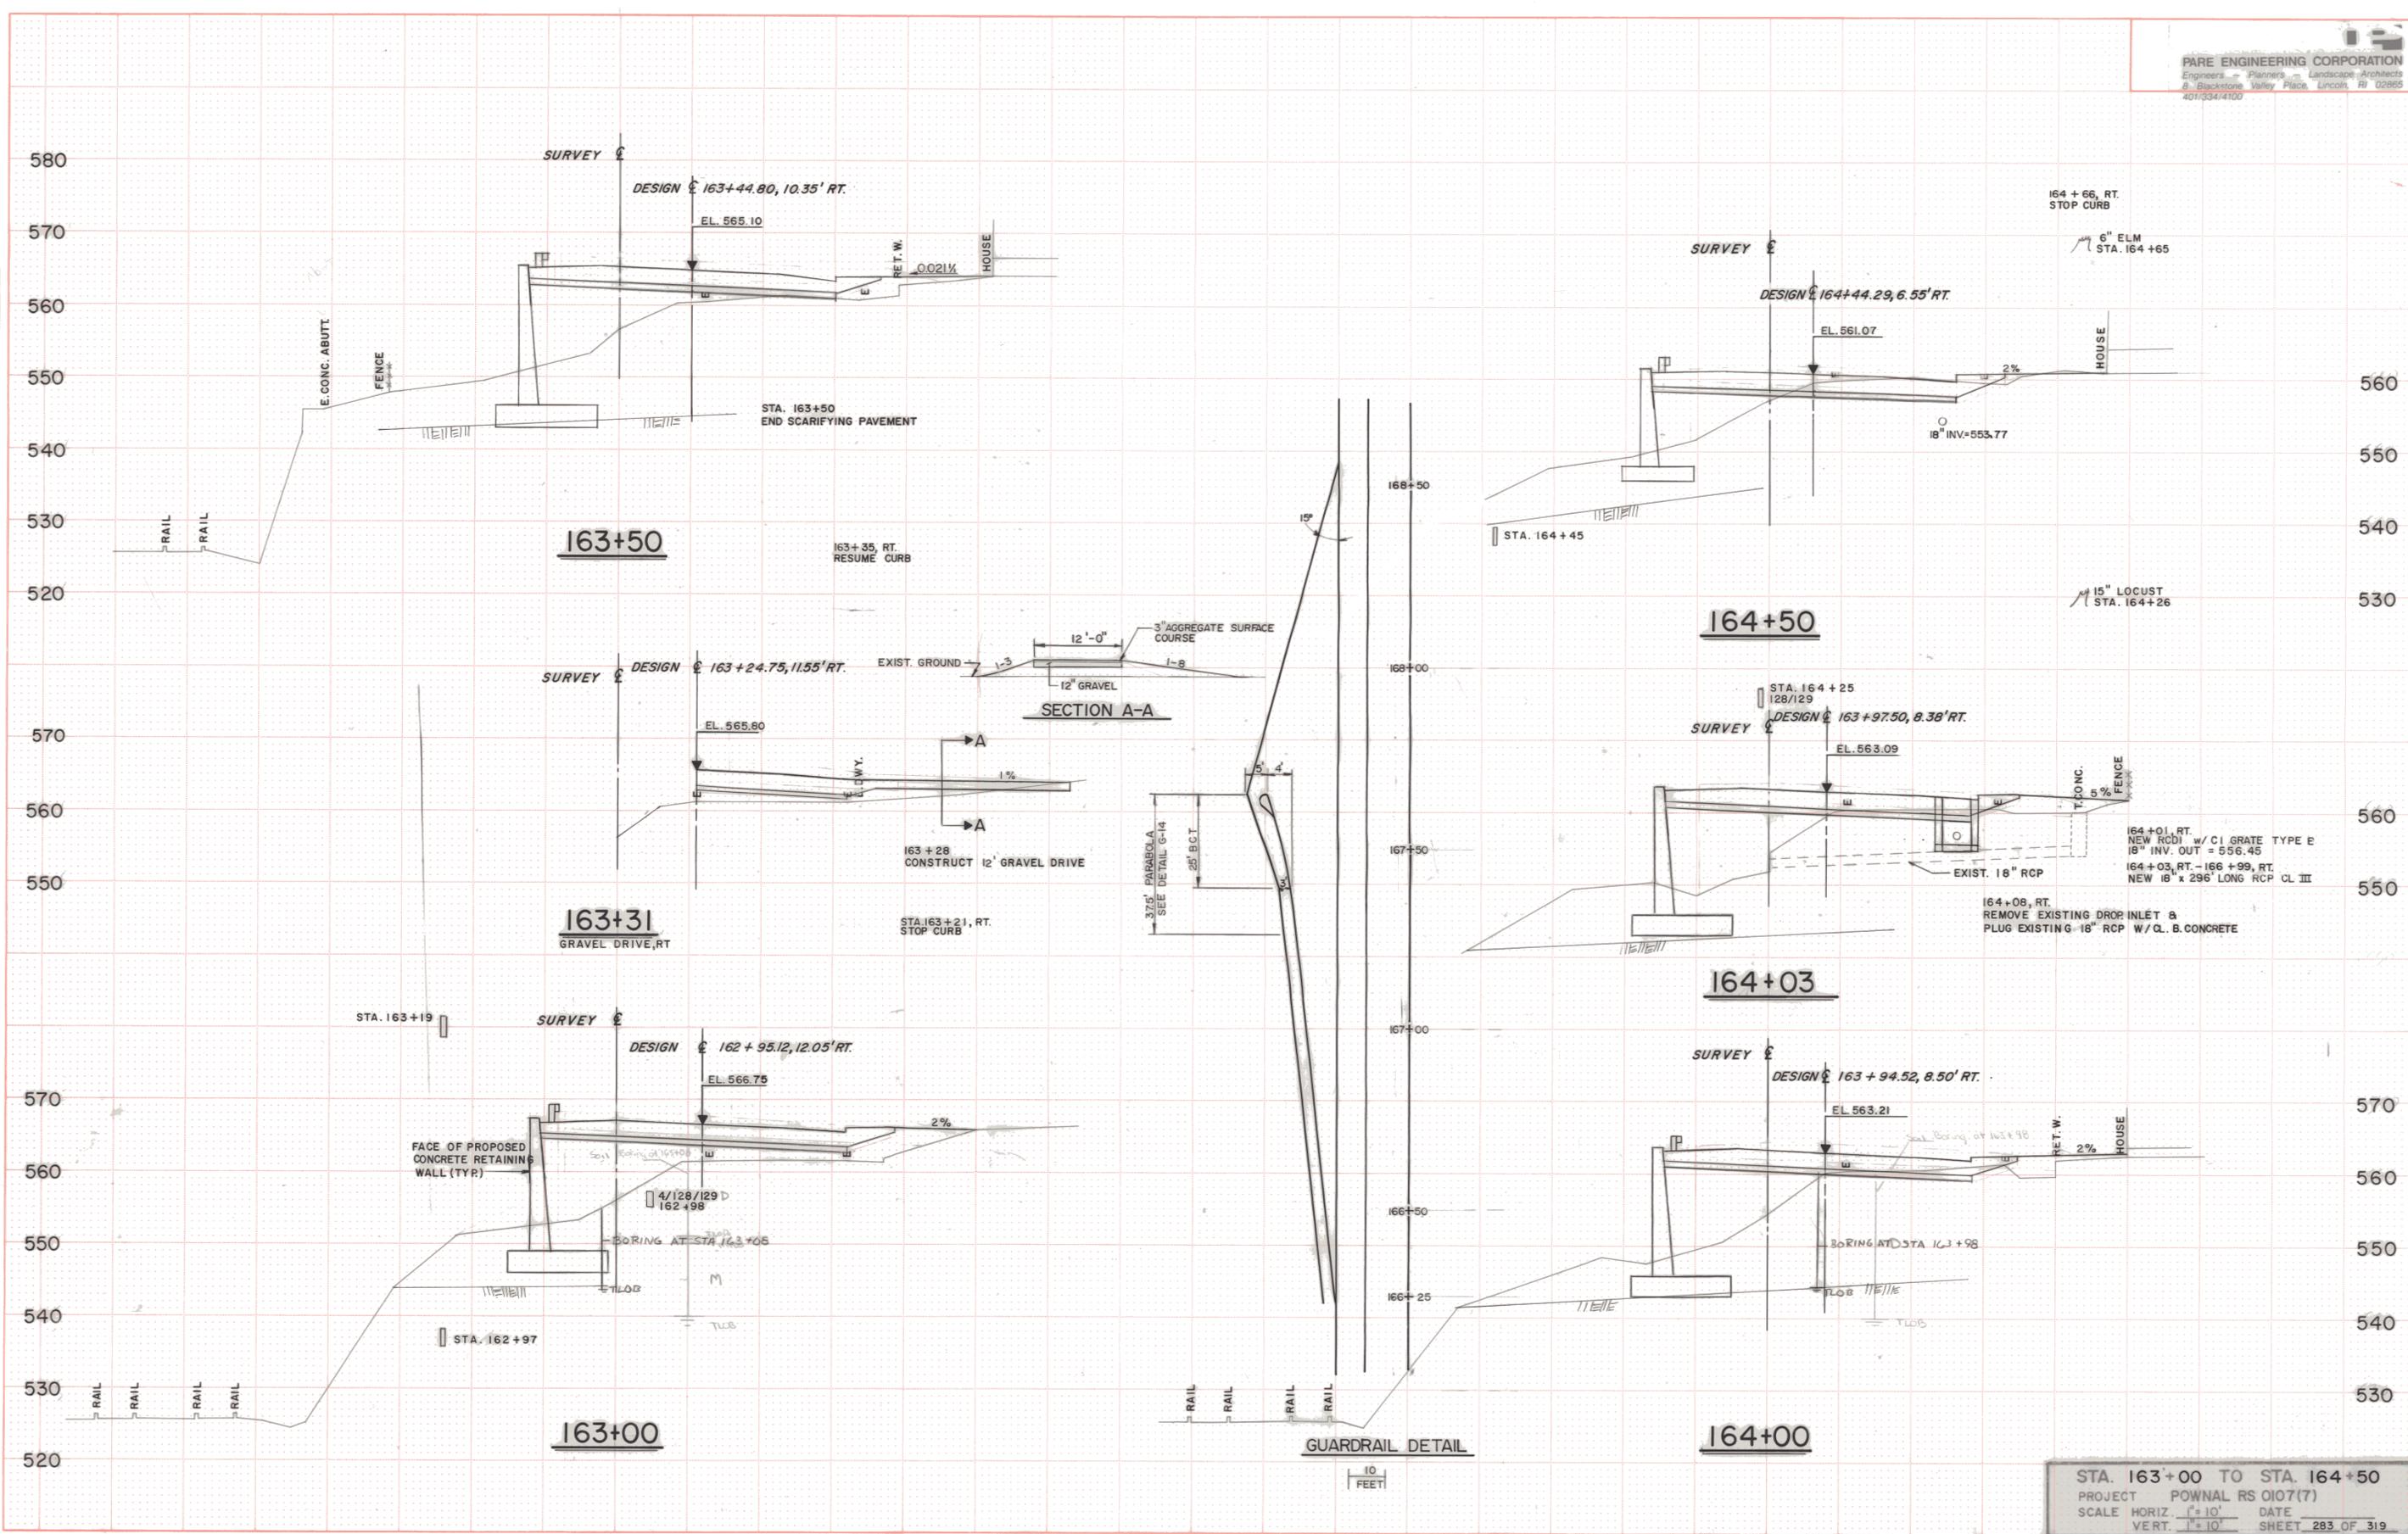

STA. 163+00 TO STA. 164+50
 PROJECT POWNAL RS 0107(7)
 SCALE HORIZ. 1"=10' DATE
 VERT. 1"=10' SHEET 283 OF 319