
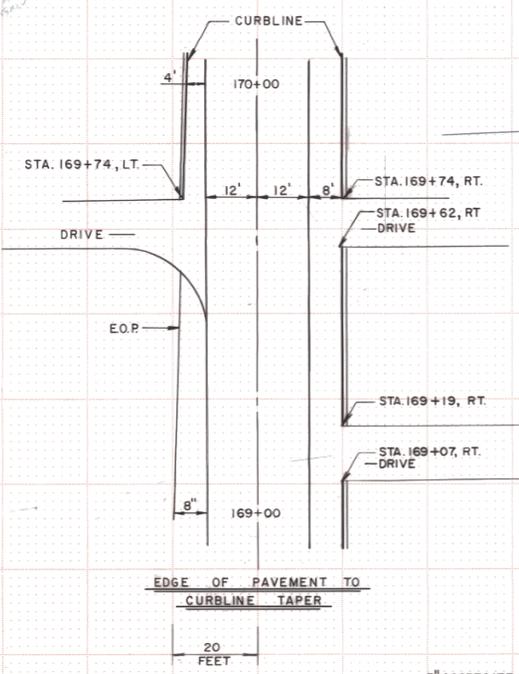
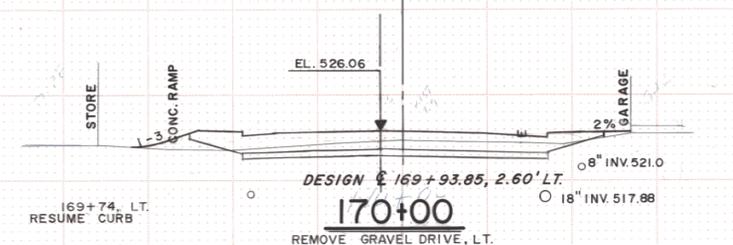
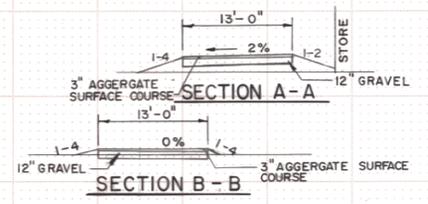


DATE: _____
 BY: _____
 CHECKED: _____
 APPROVED: _____
 ORIGINAL SURVEY PLOTTED: _____
 NOTE BOOK NO. _____
 AREA CHECKED: _____

DATE: _____
 BY: _____
 CHECKED: _____
 APPROVED: _____
 ORIGINAL SURVEY PLOTTED: _____
 NOTE BOOK NO. _____
 AREA CHECKED: _____

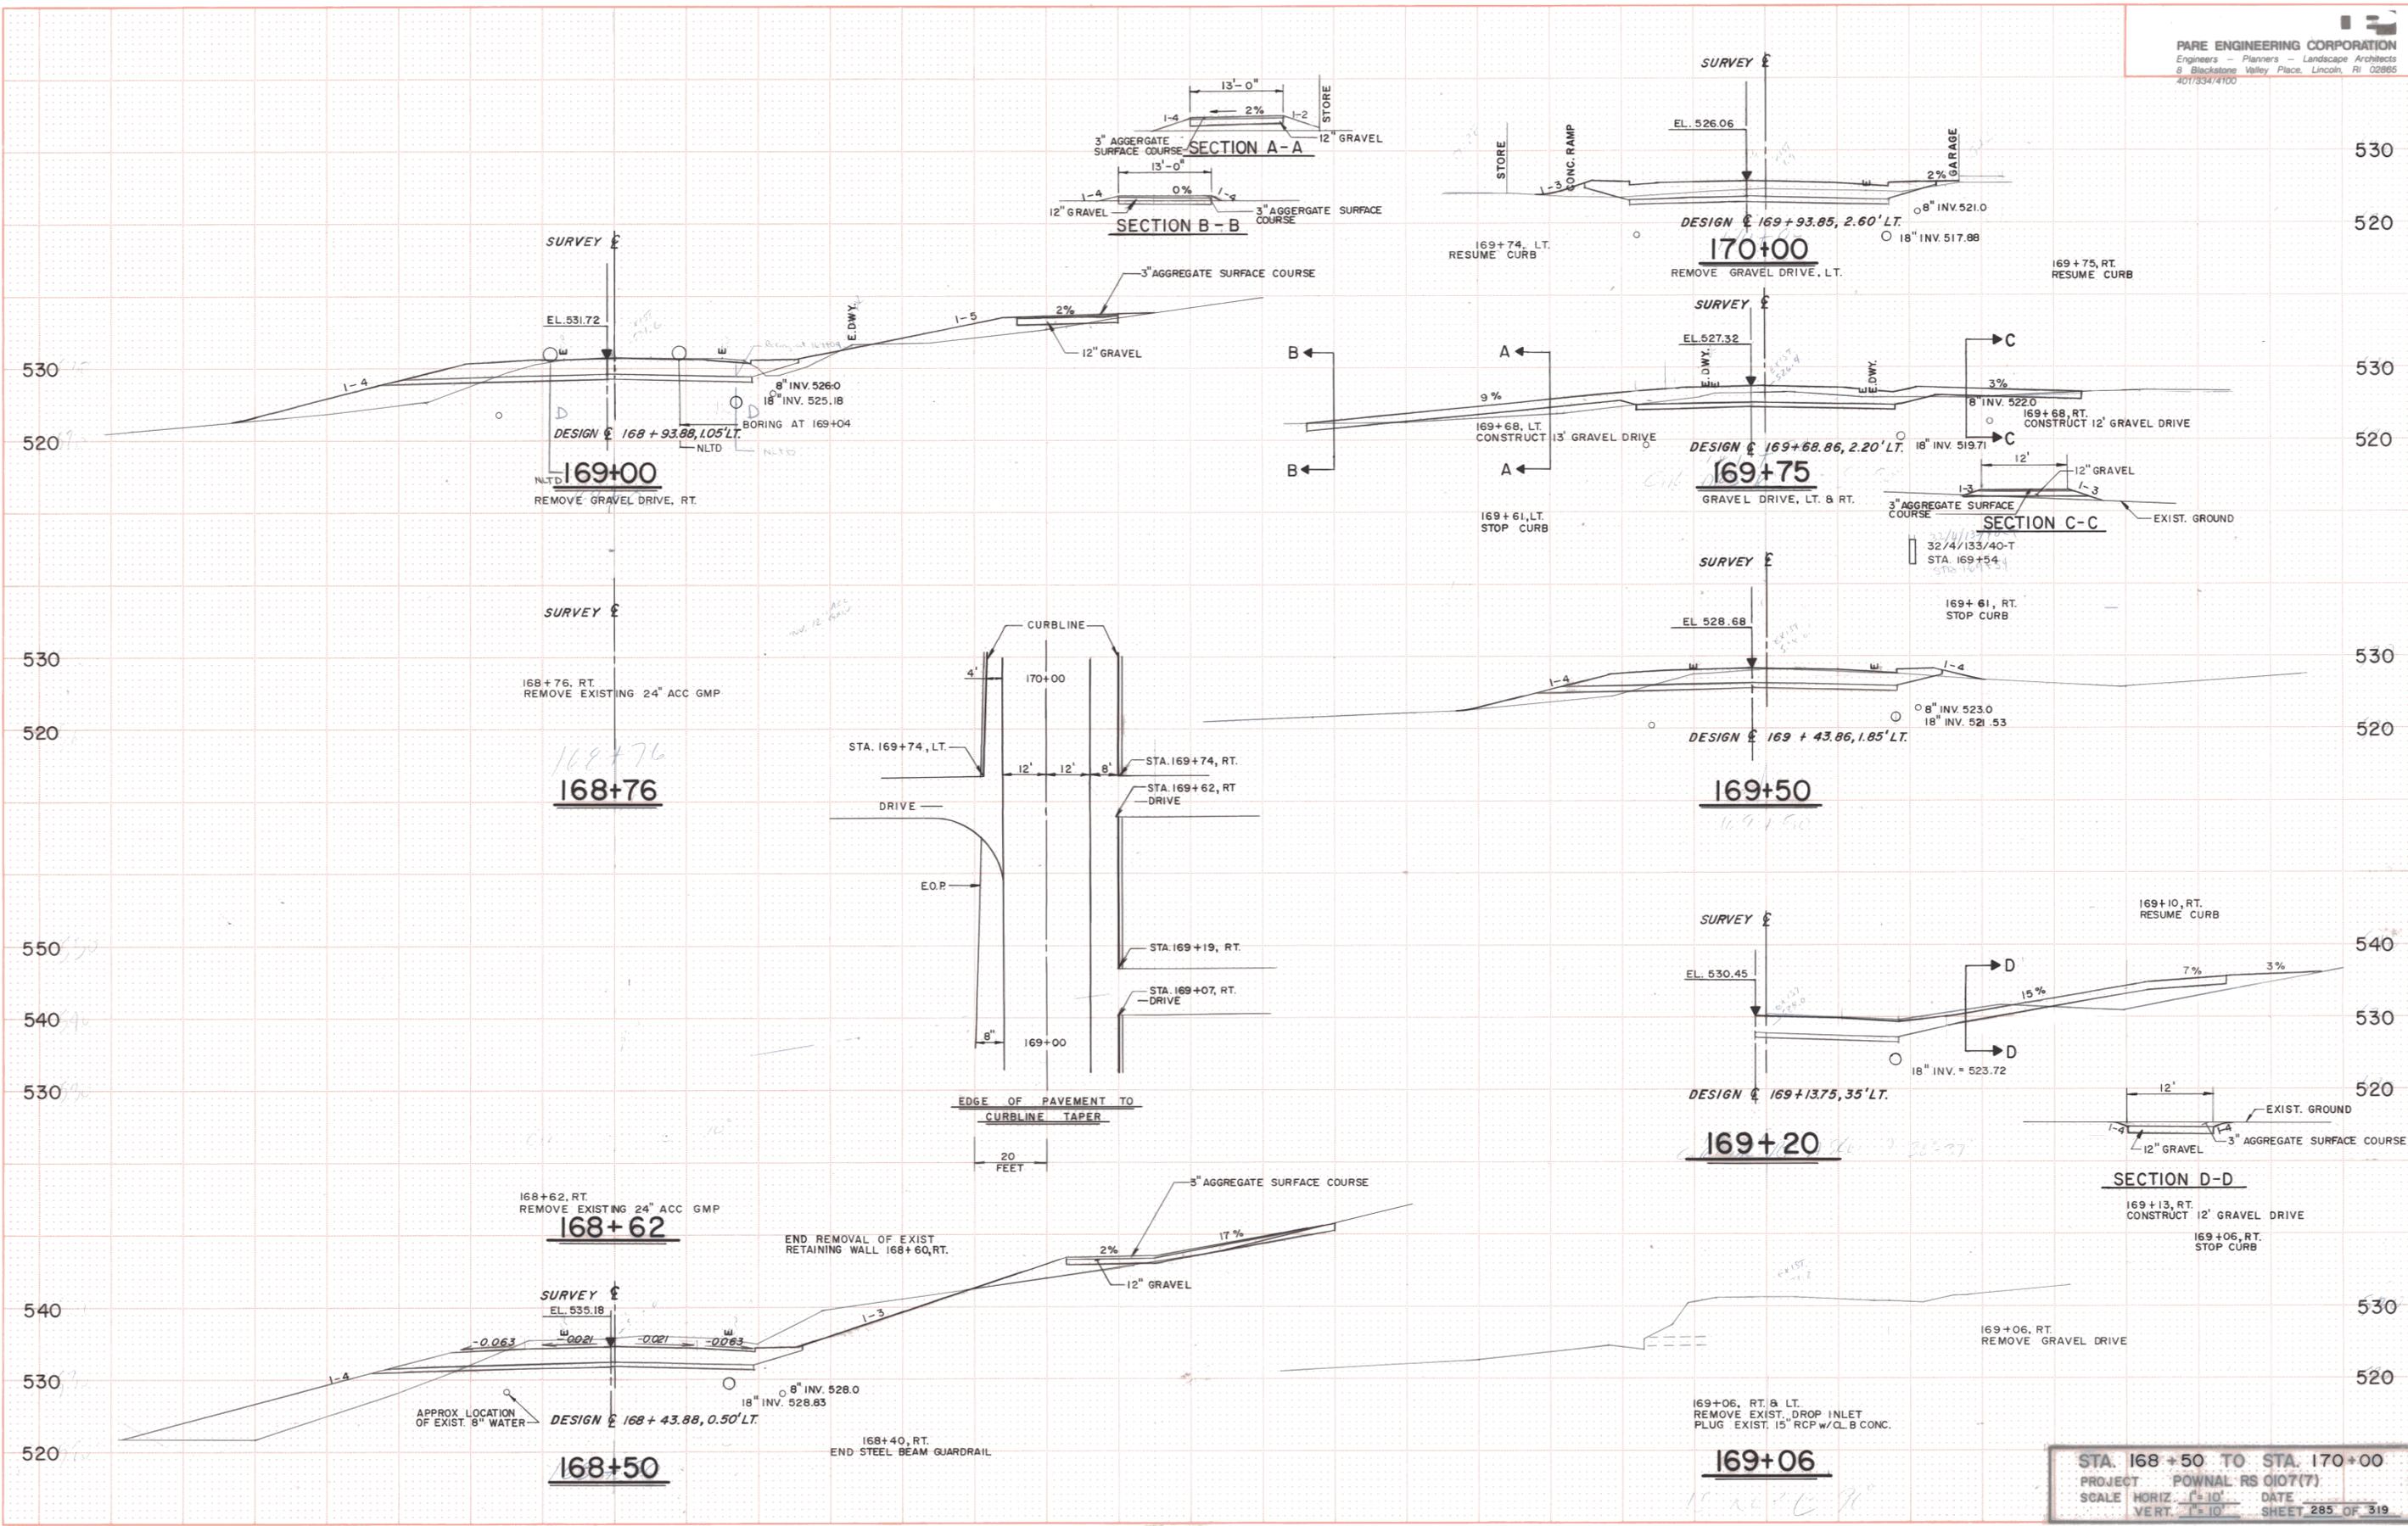

STA. 168+50 TO STA. 170+00
 PROJECT: POWNAL RS 0107(7)
 SCALE: HORIZ. 1"=10', VERT. 1"=10'
 DATE: _____
 SHEET 285 OF 319