


FINAL SURVEY SURVEYED, PLOTTED, NOTE BOOK, TEMPLATE, NO. DATE

ORIGINAL SURVEY SURVEYED, PLOTTED, NOTE BOOK, TEMPLATE, NO. DATE

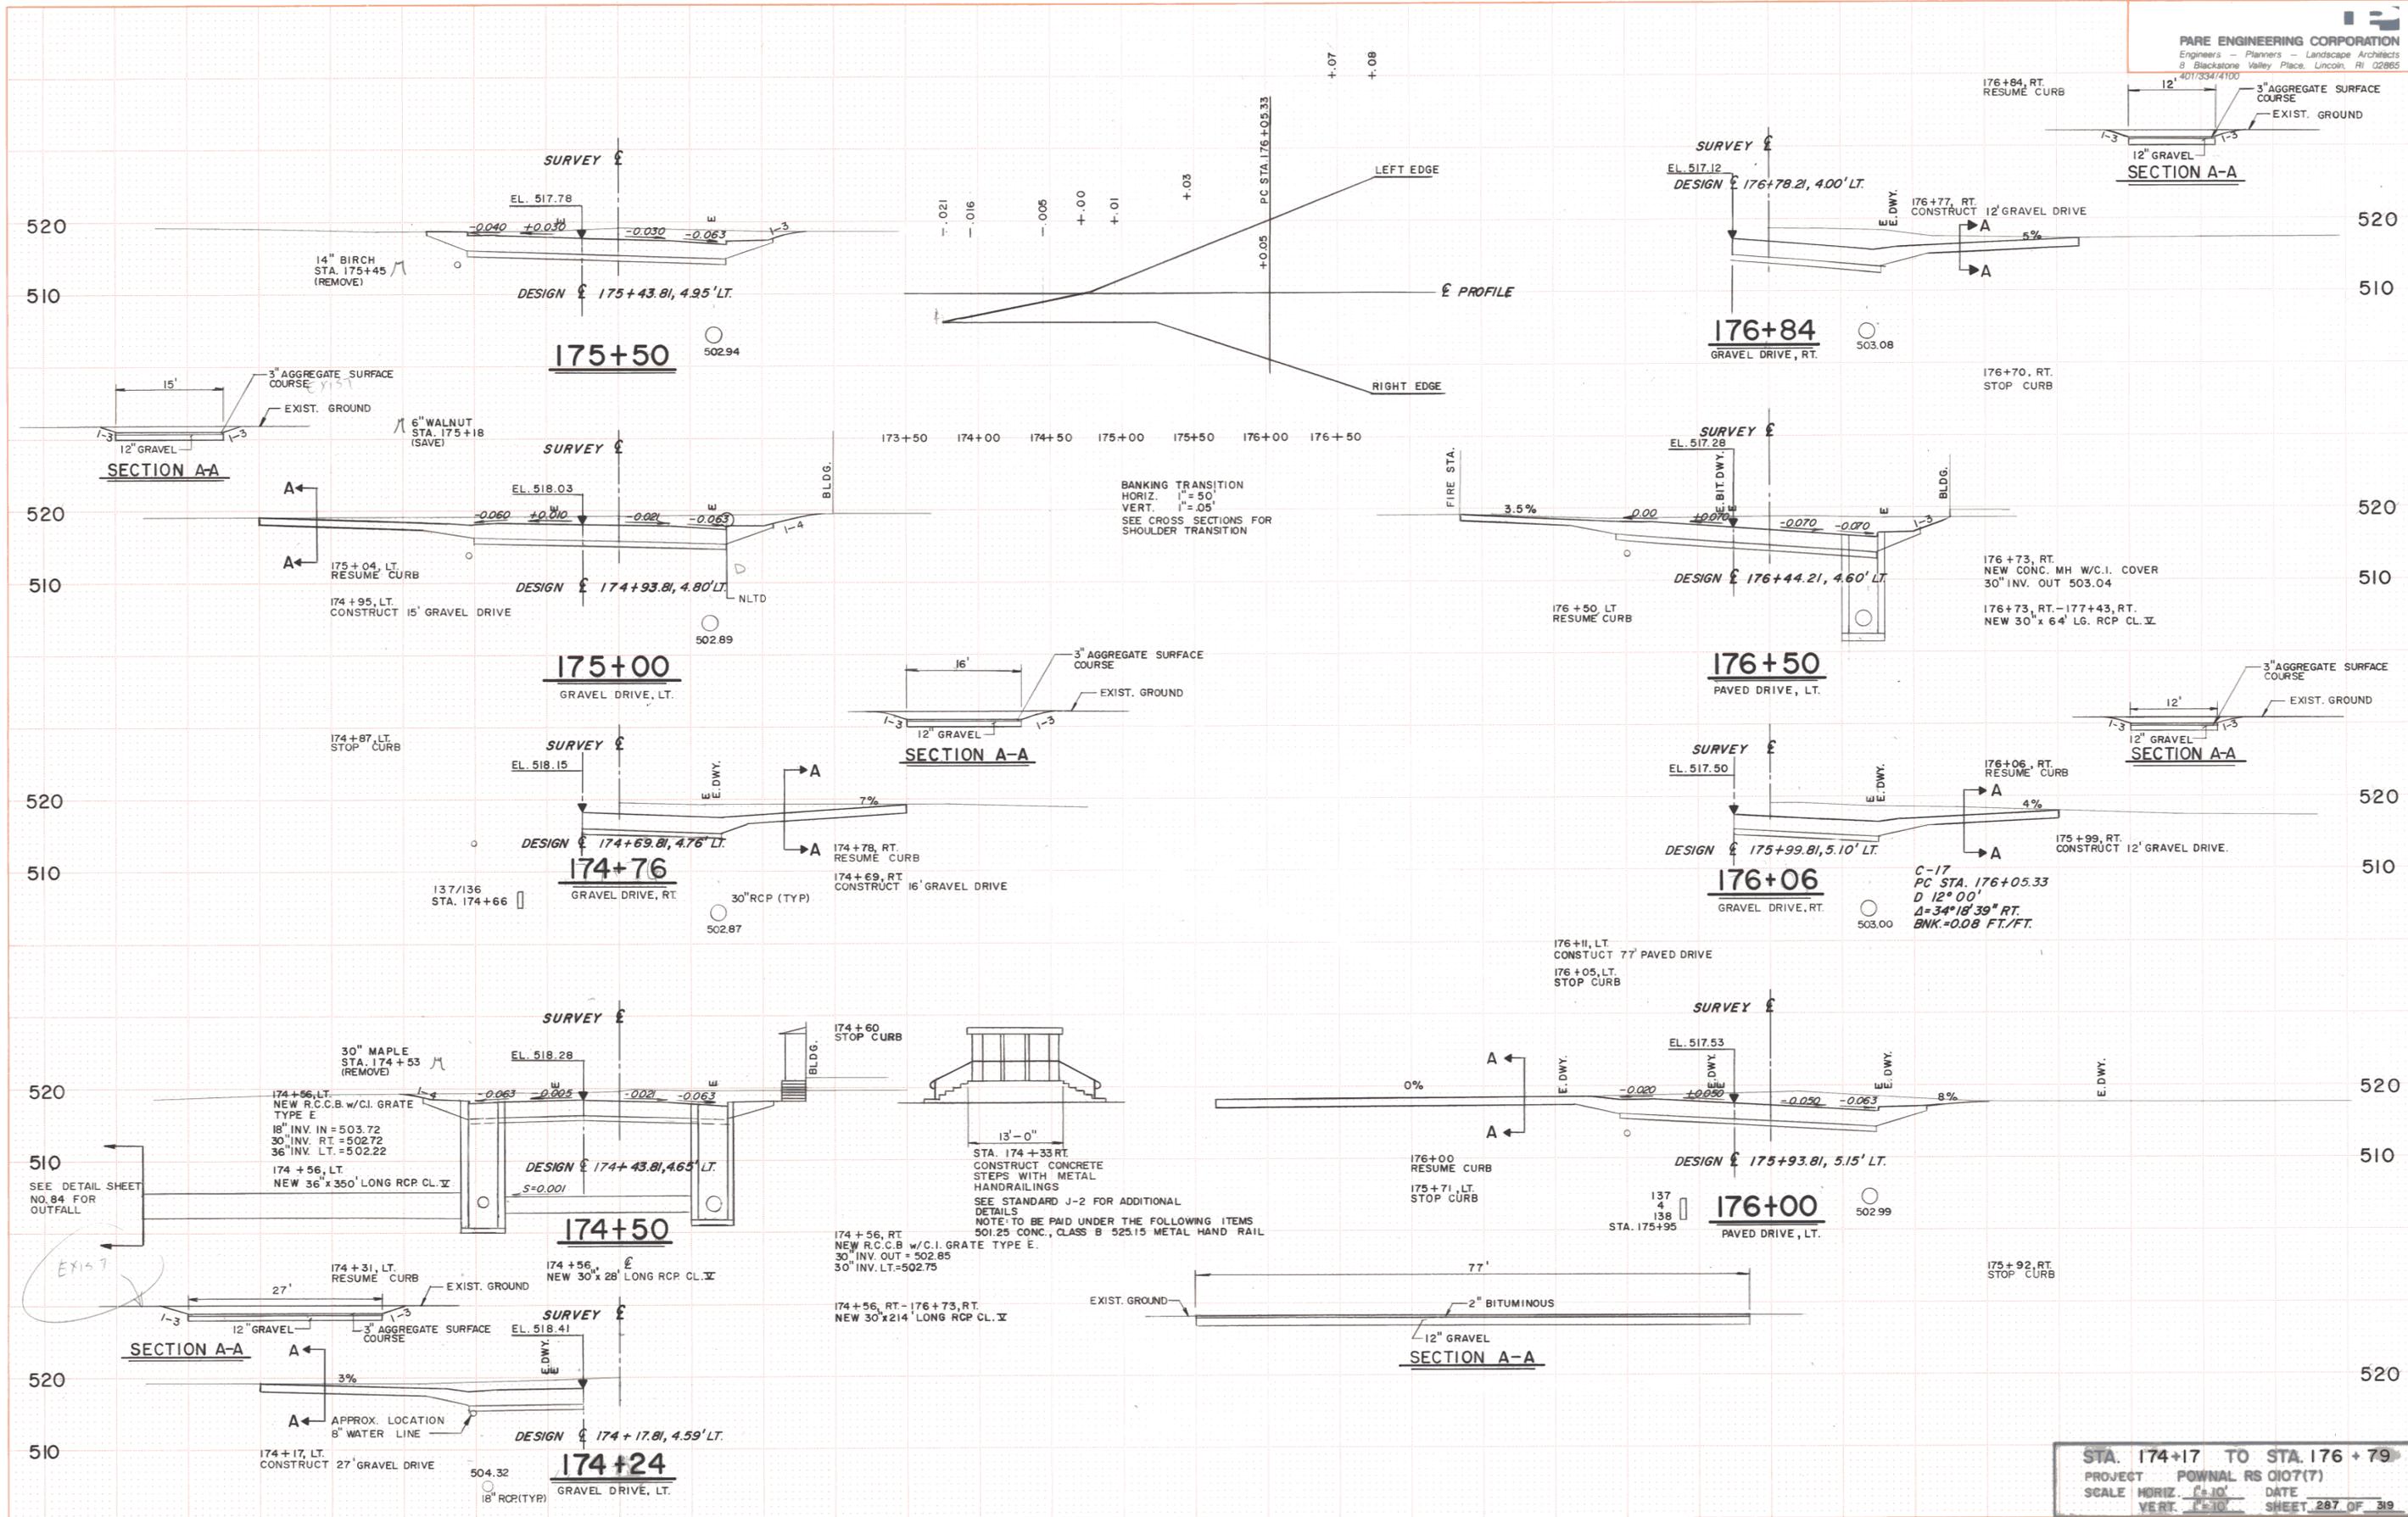

STA. 174+17 TO STA. 176+79
 PROJECT POWNAL RS 0107(7)
 SCALE HORIZ. 1"=10' DATE
 VERT. 1"=10' SHEET 287 OF 319