
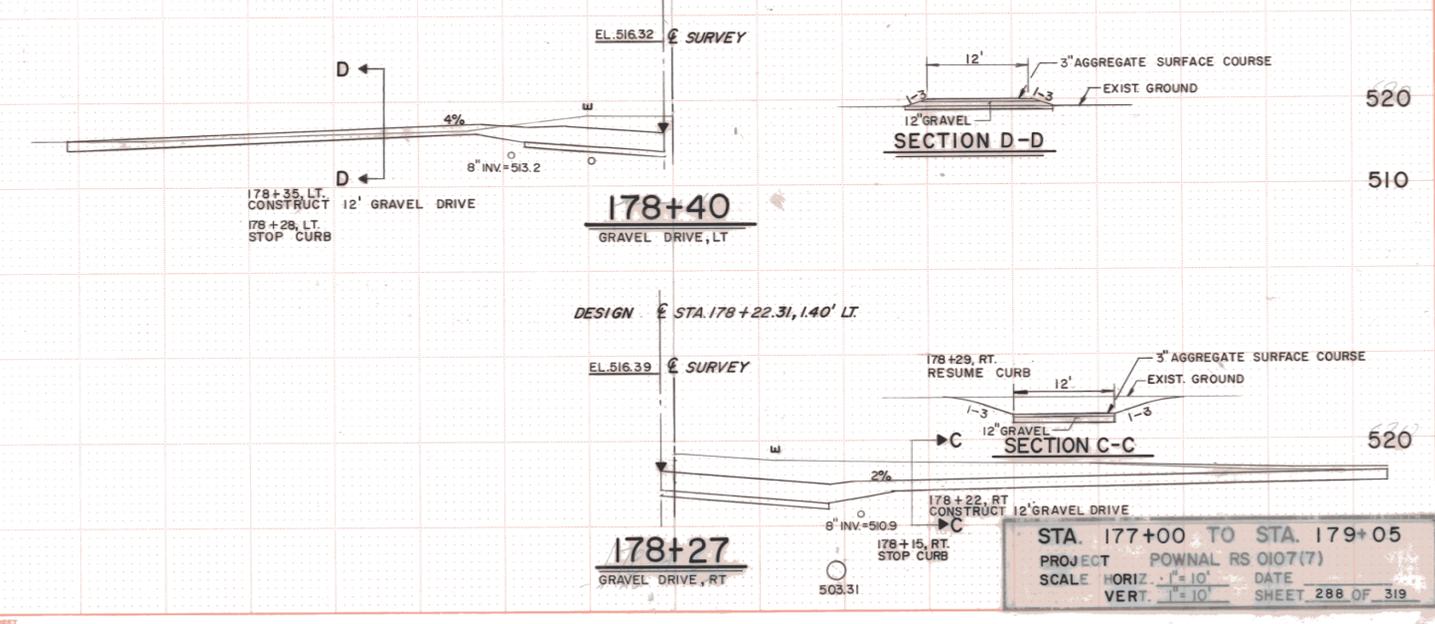
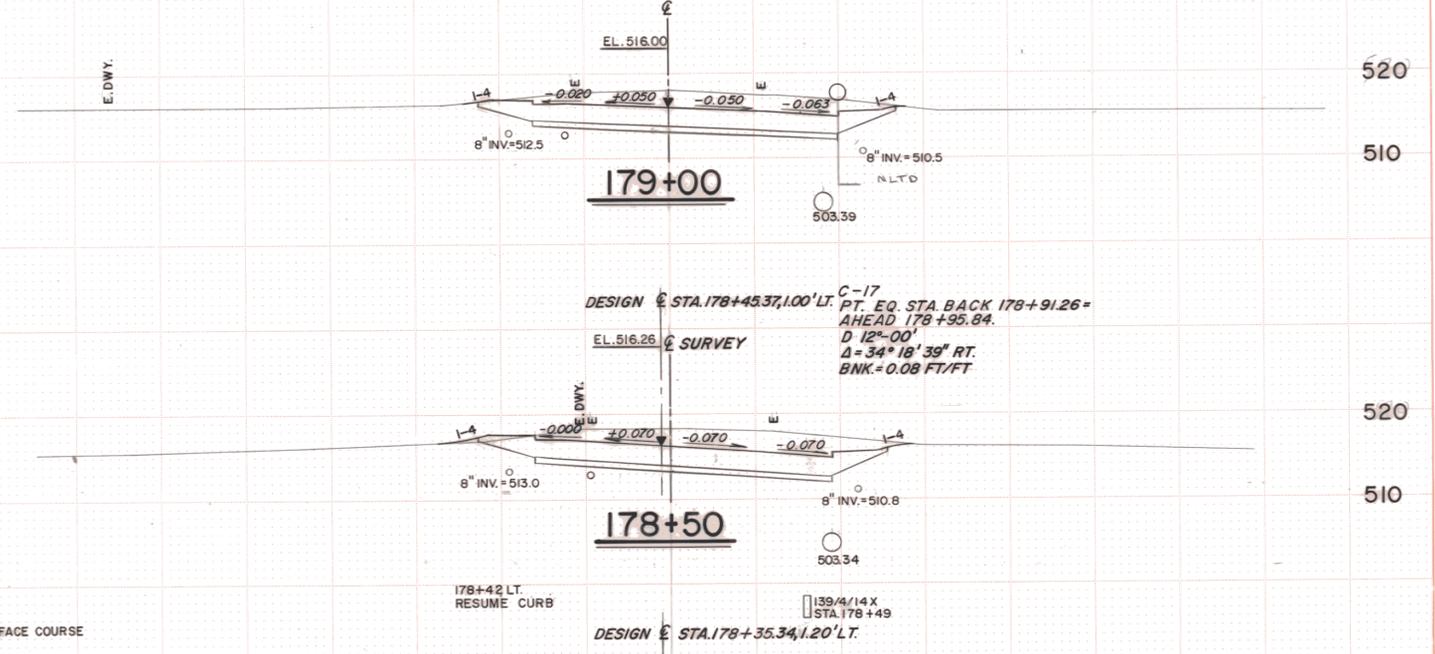
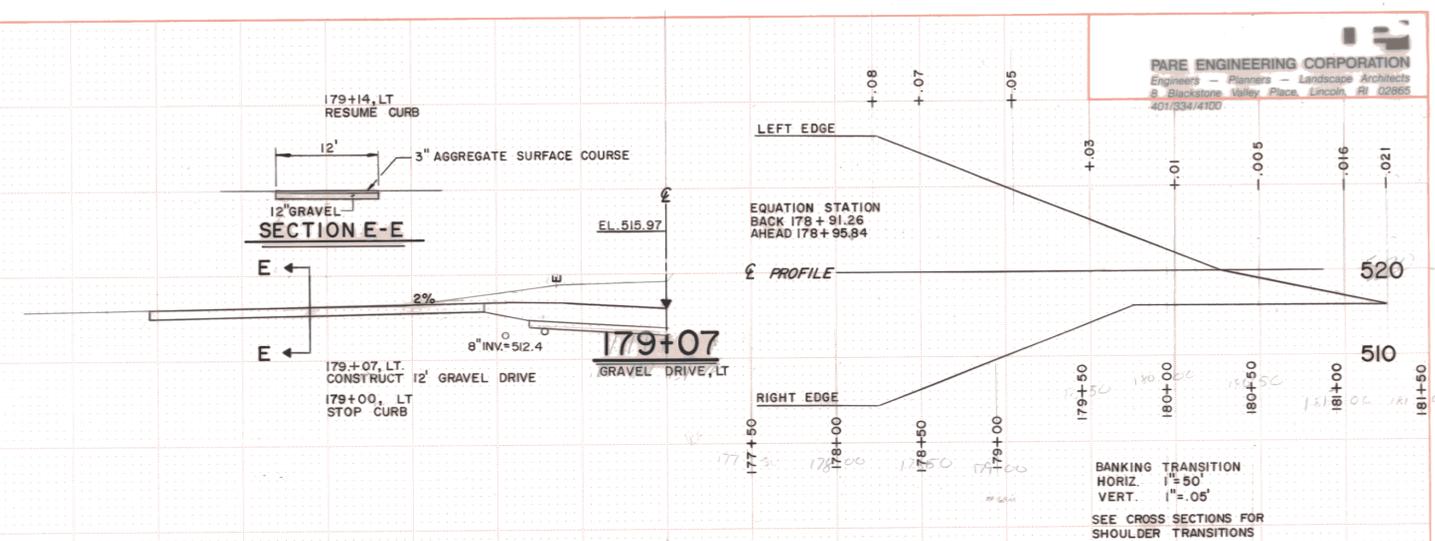


FINAL SURVEY  
 SURVEYED  
 PLOTTED  
 NOTE BOOK  
 NO. AREA CHECKED

ORIGINAL SURVEY  
 SURVEYED  
 PLOTTED  
 NOTE BOOK  
 NO. AREA CHECKED

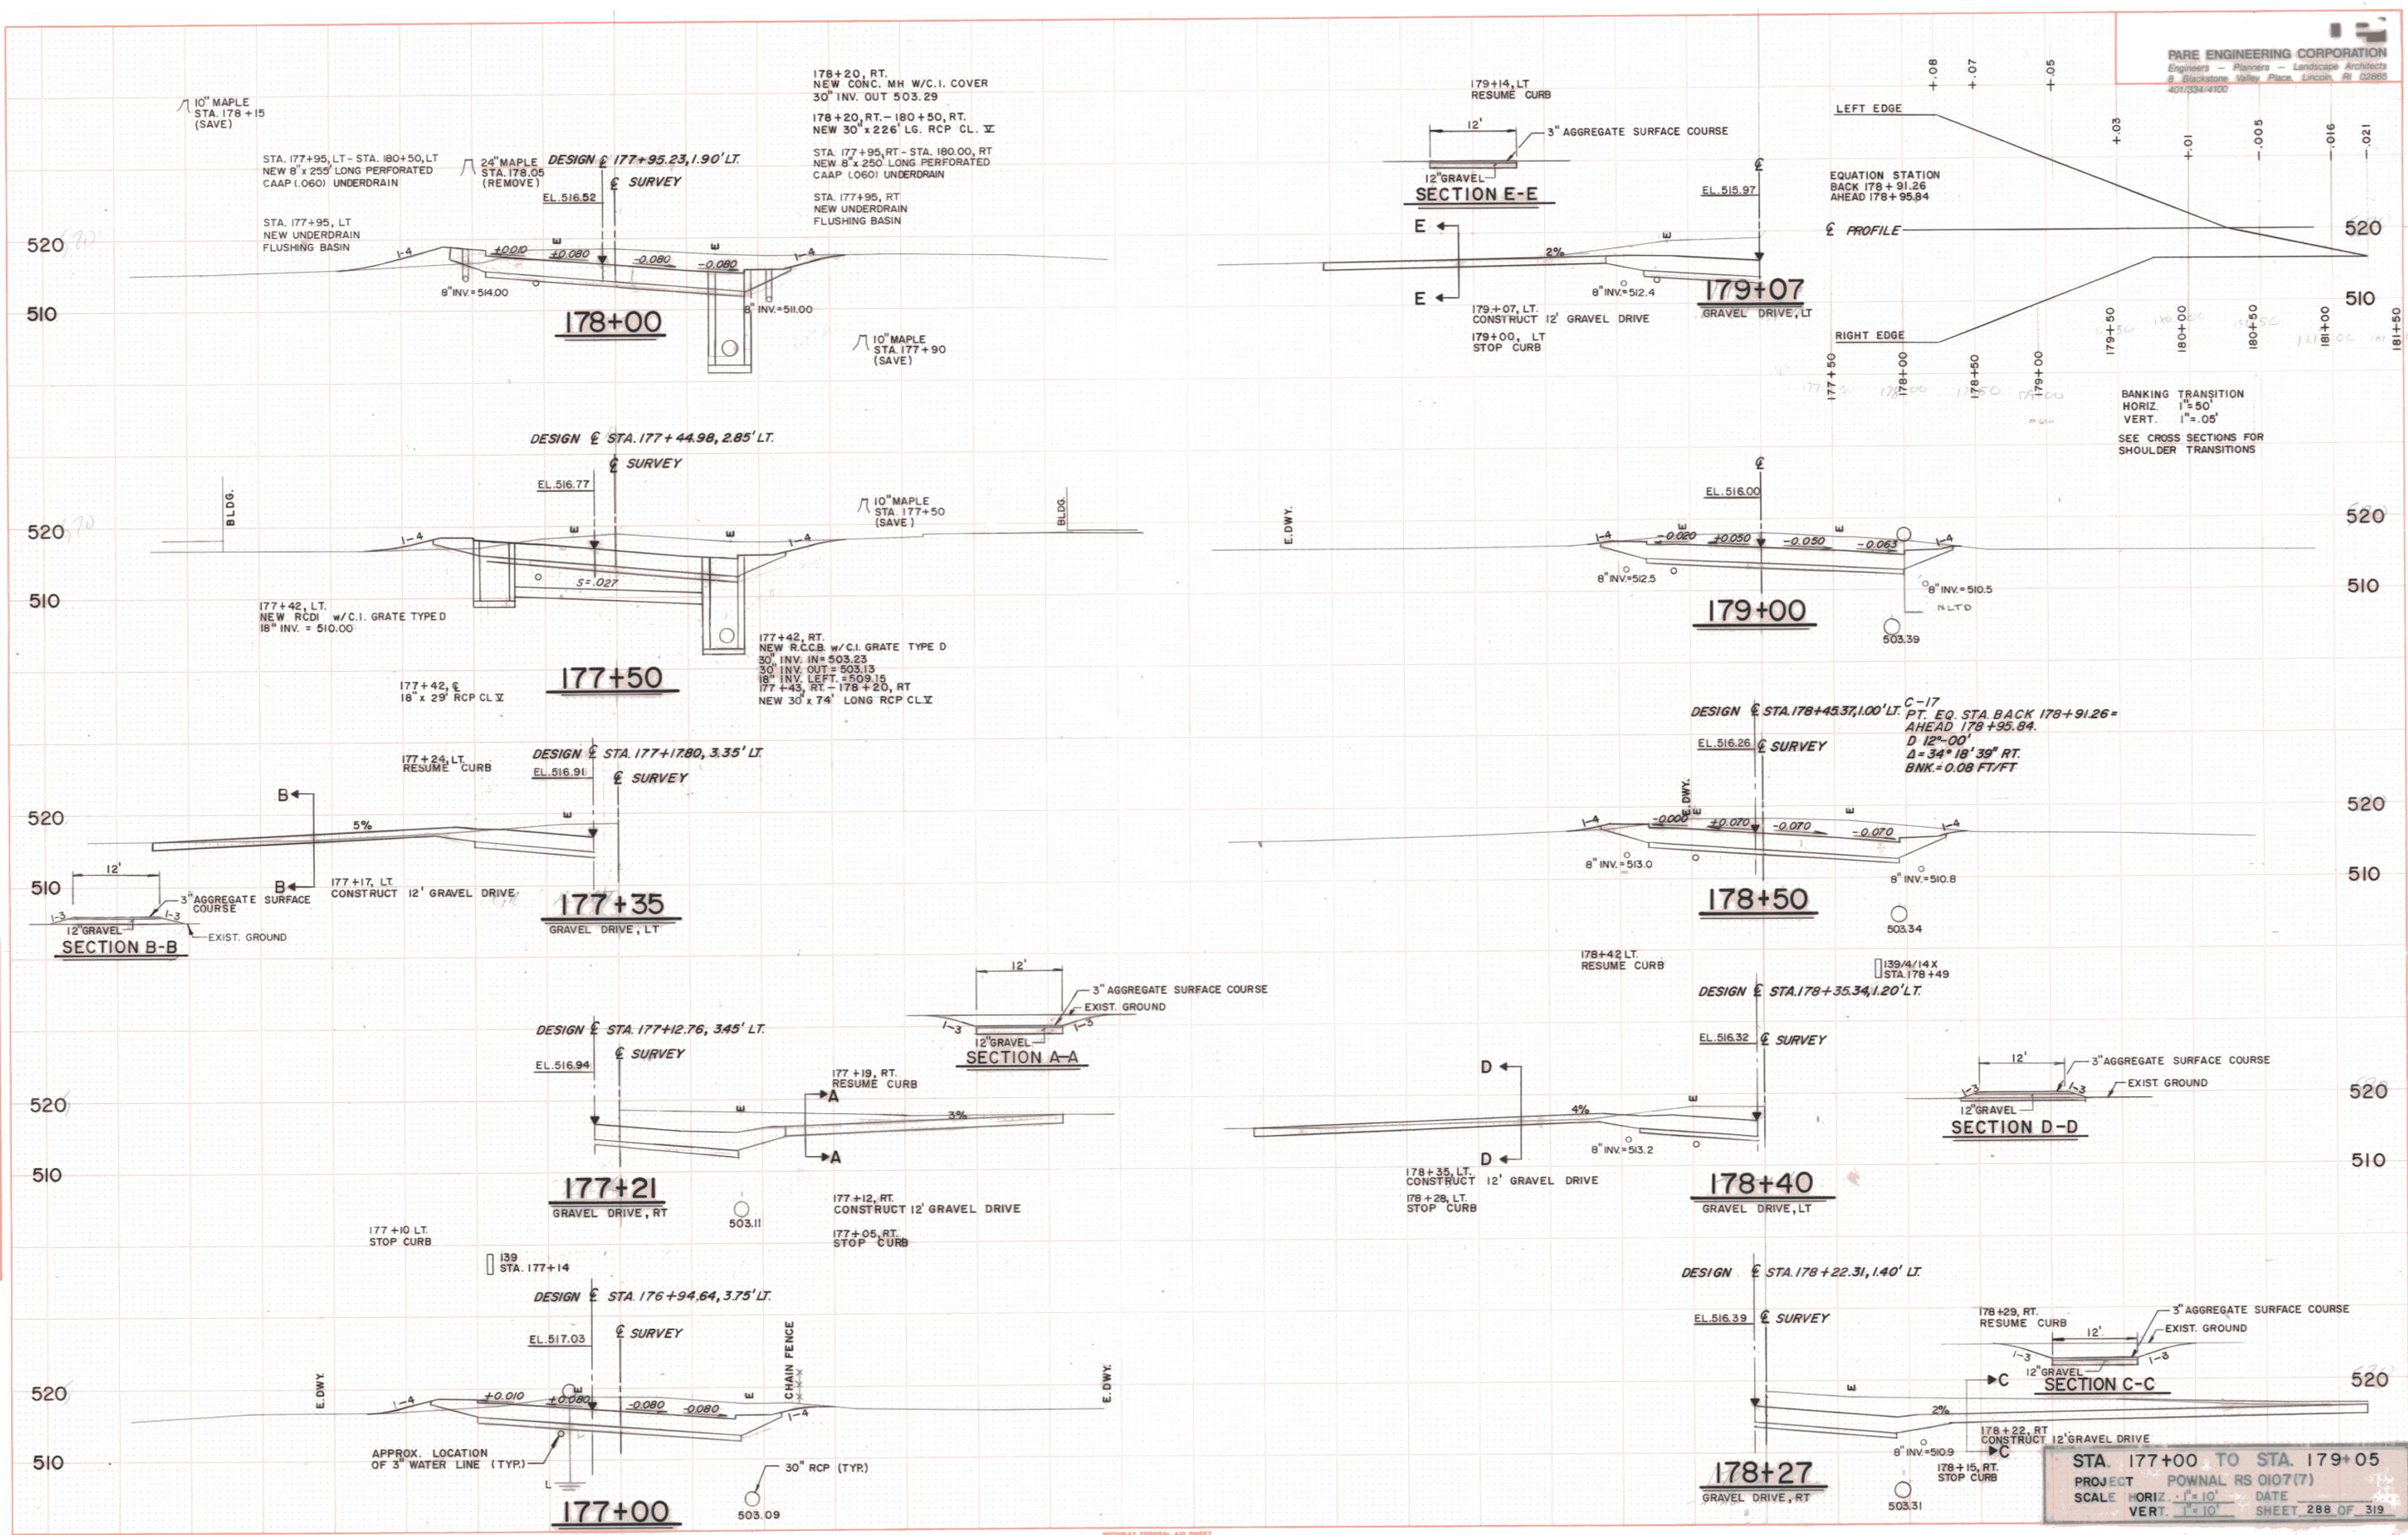

STA. 177+00 TO STA. 179+05  
 PROJECT POWNAL RS 0107(7)  
 SCALE HORIZ. 1" = 10' DATE  
 VERT. 1" = 10' SHEET 288 OF 319