


DATE  
 RT  
 ORIGINAL SURVEY  
 NUMBERED  
 PLOTTED  
 TEMPLATE  
 NOTE BOOK  
 NO.  
 AREA  
 CHECKED  
 NO.

DATE  
 RT  
 ORIGINAL SURVEY  
 NUMBERED  
 PLOTTED  
 TEMPLATE  
 NOTE BOOK  
 NO.  
 AREA  
 CHECKED  
 NO.

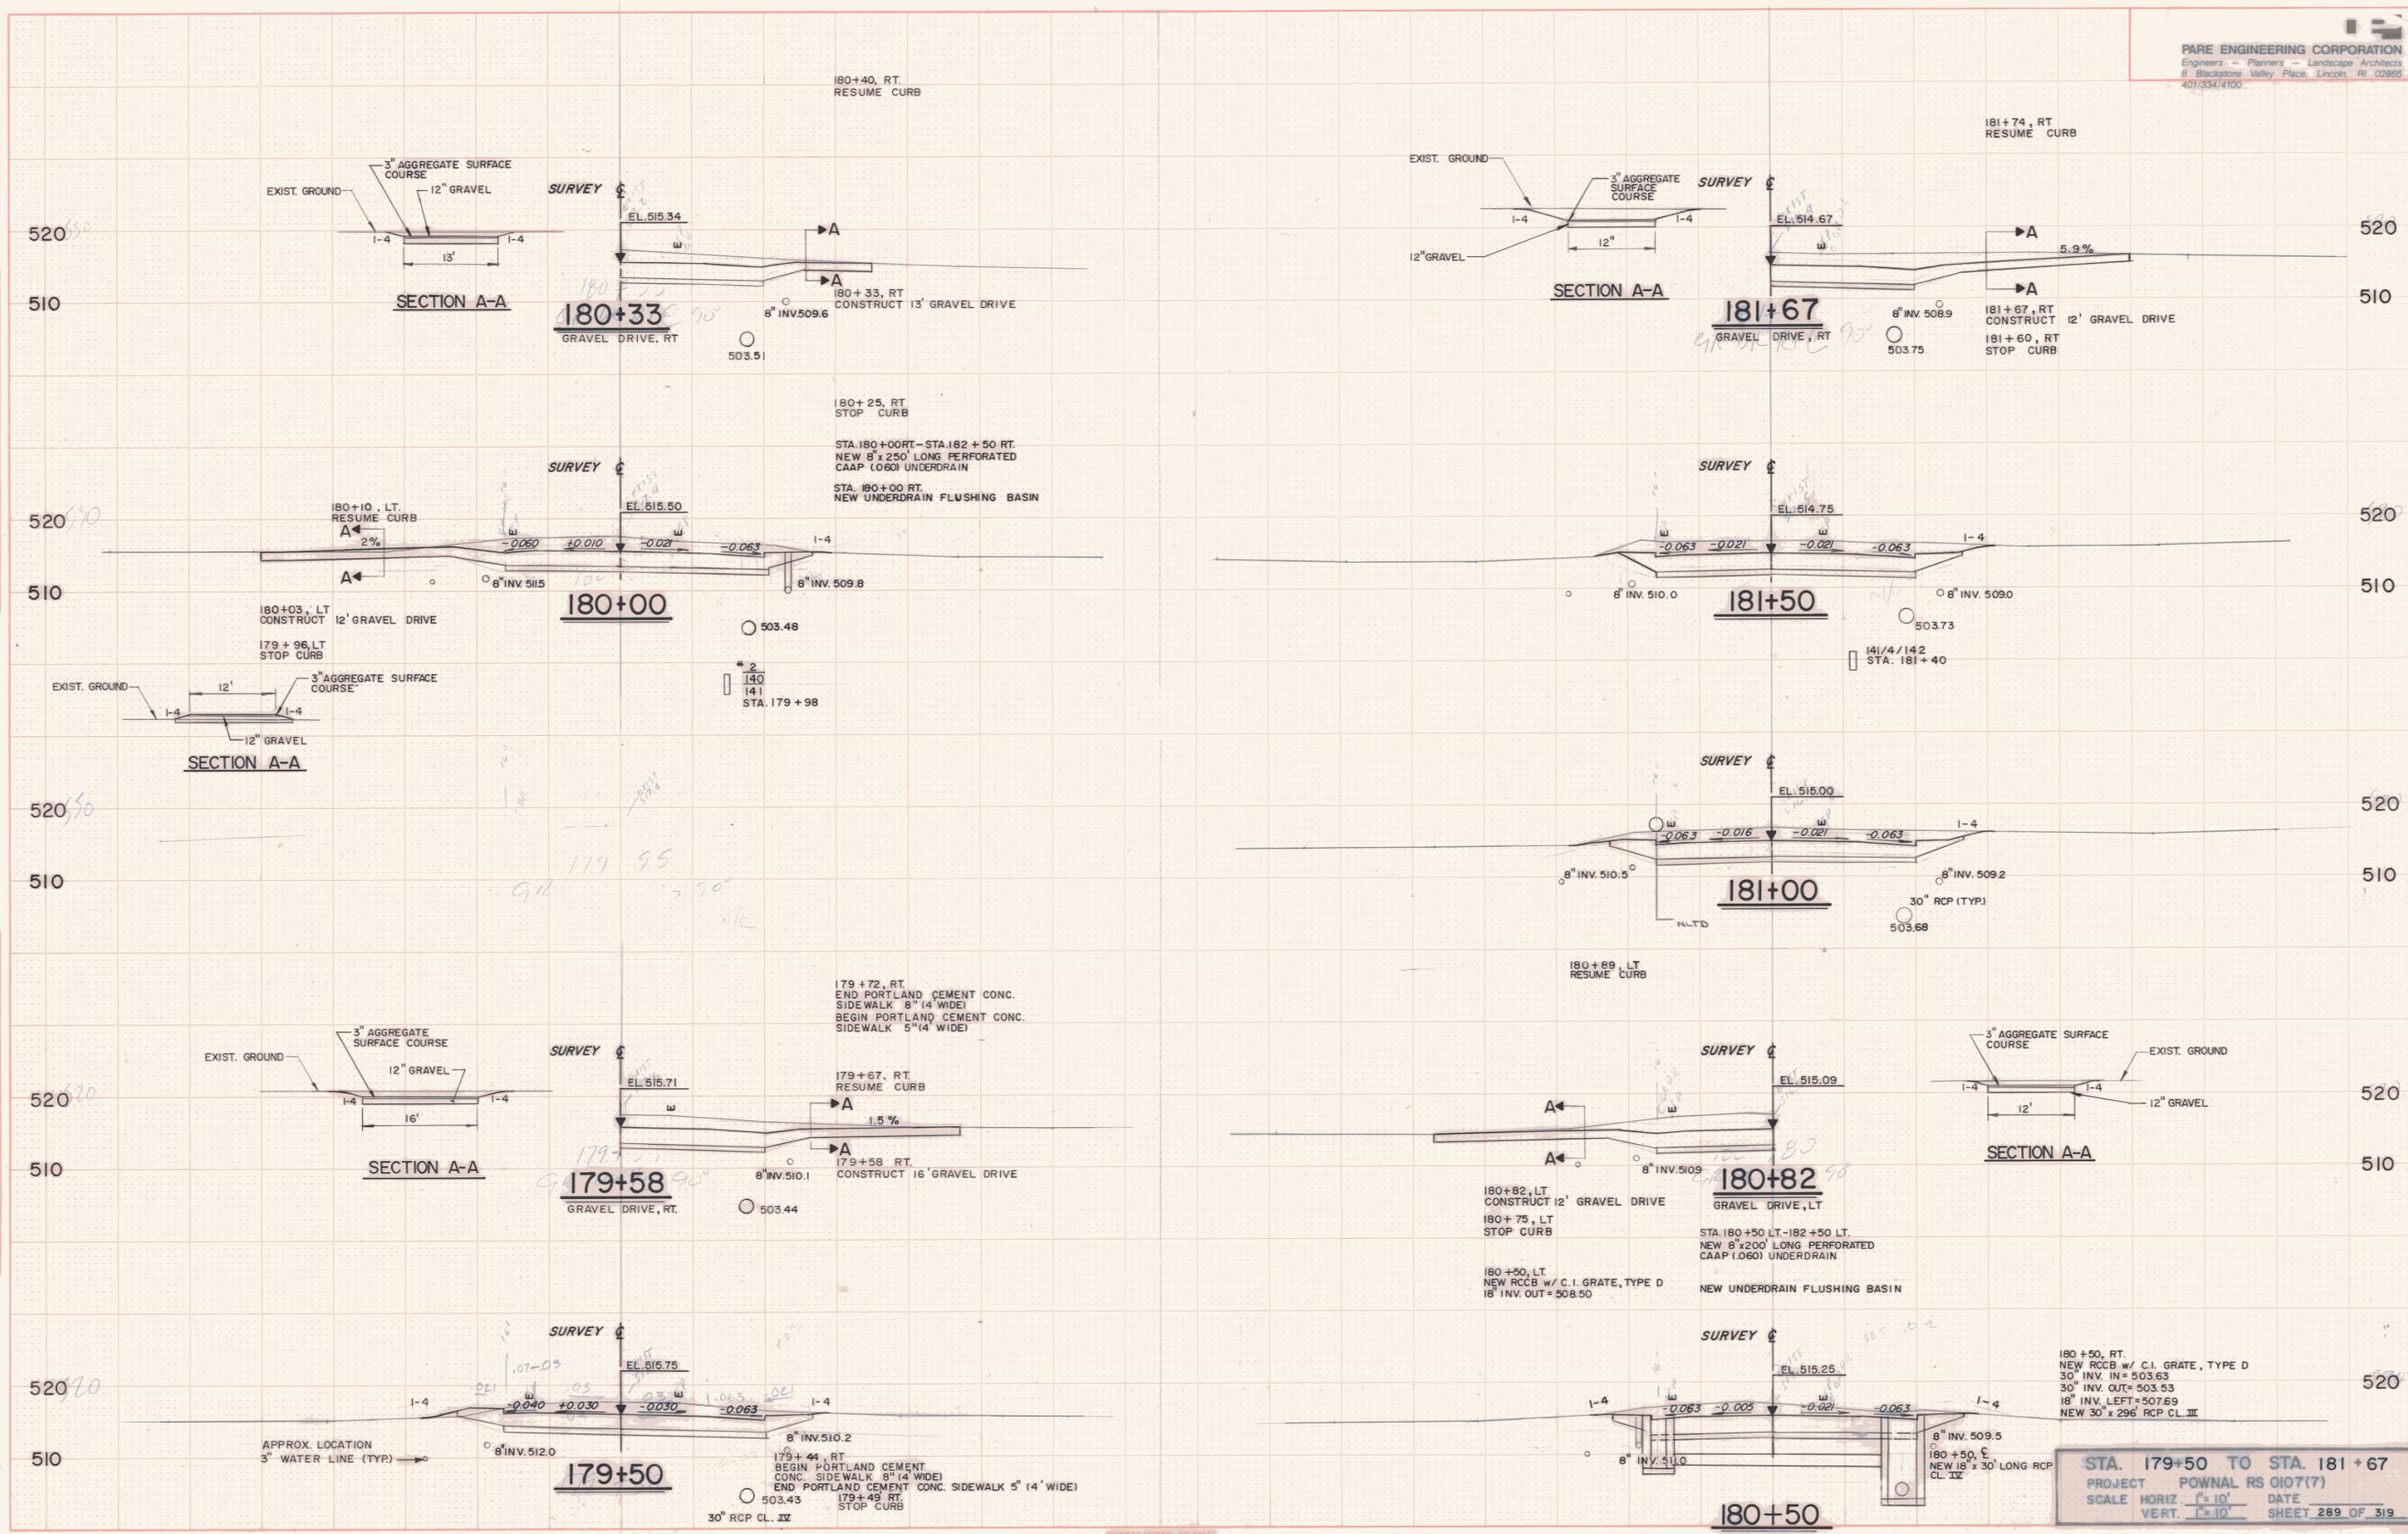

STA. 179+50 TO STA. 181+67  
 PROJECT POWNAL RS 0107(7)  
 SCALE HORIZ. 1" = 10'  
 VERT. 1" = 10'  
 DATE  
 SHEET 289 OF 319