


DATE: _____ BY: _____
 ORIGINAL SURVEY PLOTTED IN: _____
 NOTE BOOK AREA: _____
 NO. _____

DATE: _____ BY: _____
 ORIGINAL SURVEY PLOTTED IN: _____
 NOTE BOOK AREA: _____
 NO. _____

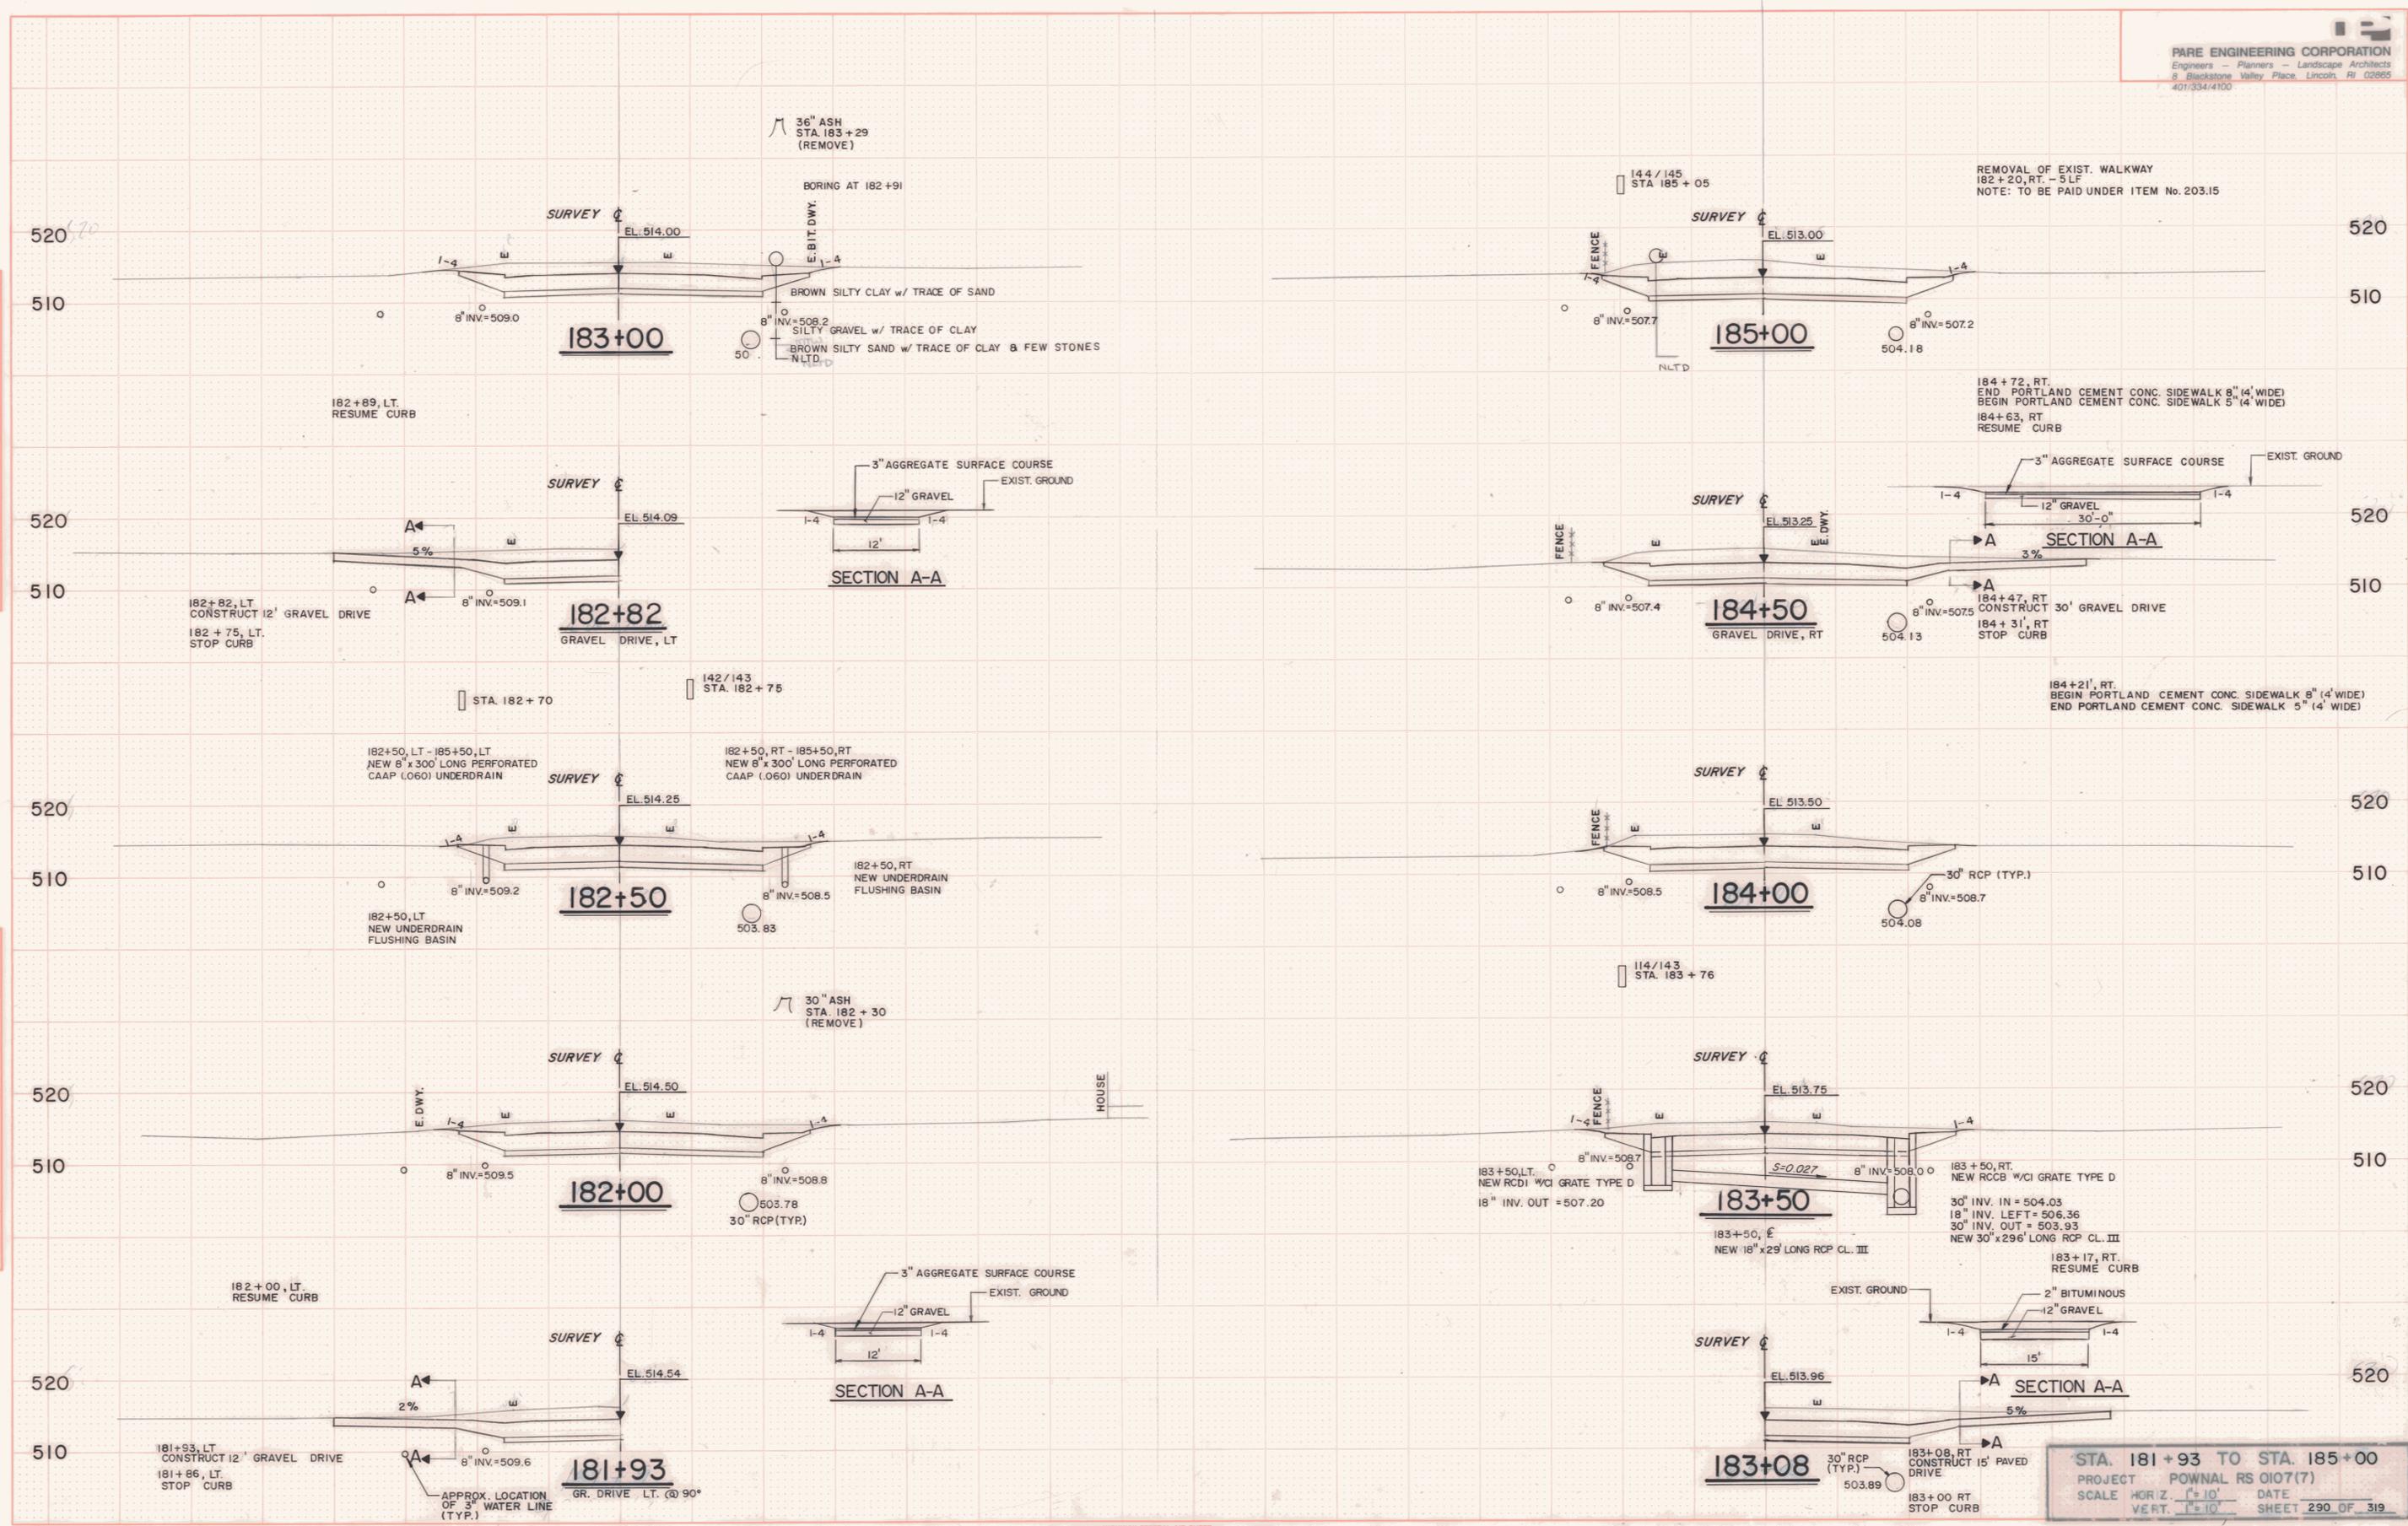

STA. 181+93 TO STA. 185+00
 PROJECT: POWNAL RS 0107(7)
 SCALE: HORIZ. 1"=10' DATE: _____
 VERT. 1"=10' SHEET 290 OF 319