


FINAL SURVEY BY DATE
 SURVEY PLOTTED BY DATE
 NOTE BOOK NO. _____
 TEMPLATE AREA CHECKED _____
 NO. _____

ORIGINAL SURVEY BY DATE
 SURVEY PLOTTED BY DATE
 NOTE BOOK NO. _____
 TEMPLATE AREA CHECKED _____
 NO. _____

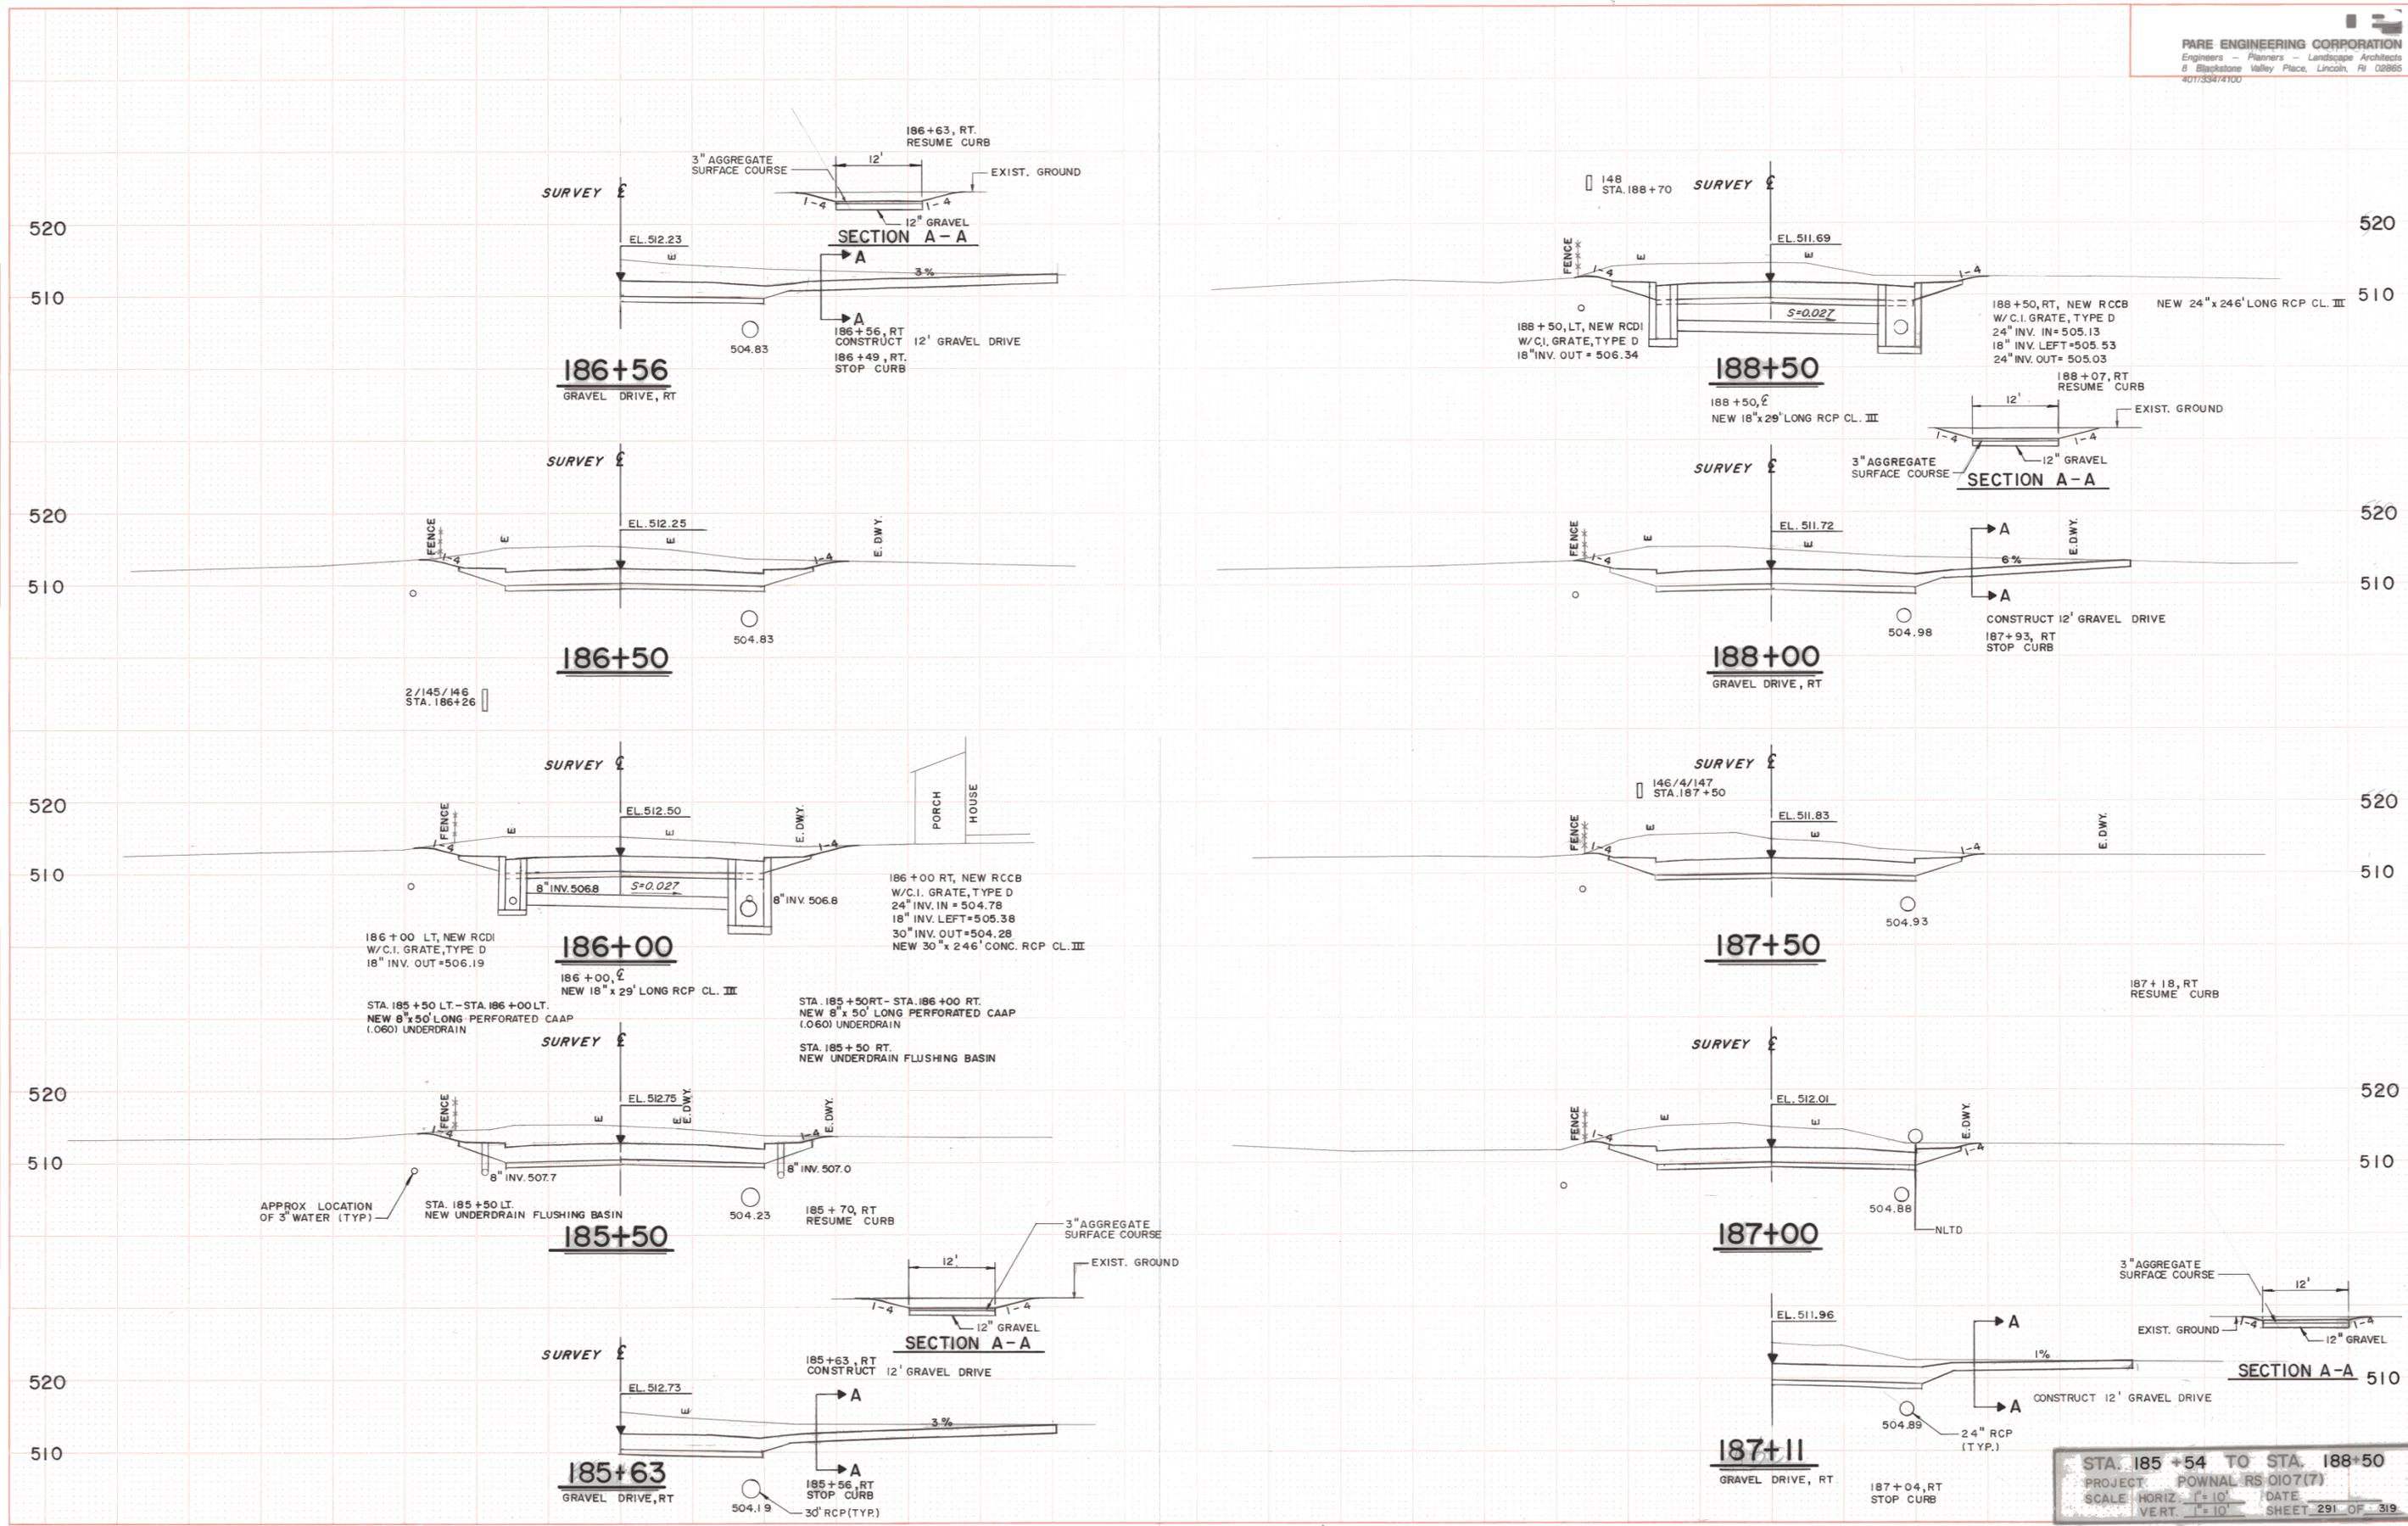

STA. 185+54 TO STA. 188+50
 PROJECT: POWNAL RS 0107(7)
 SCALE: HORIZ. 1"=10' DATE: _____
 VERT. 1"=10' SHEET 291 OF 319