


DATE	
BY	
REVISION	
NO.	
DESCRIPTION	

DATE	
BY	
REVISION	
NO.	
DESCRIPTION	

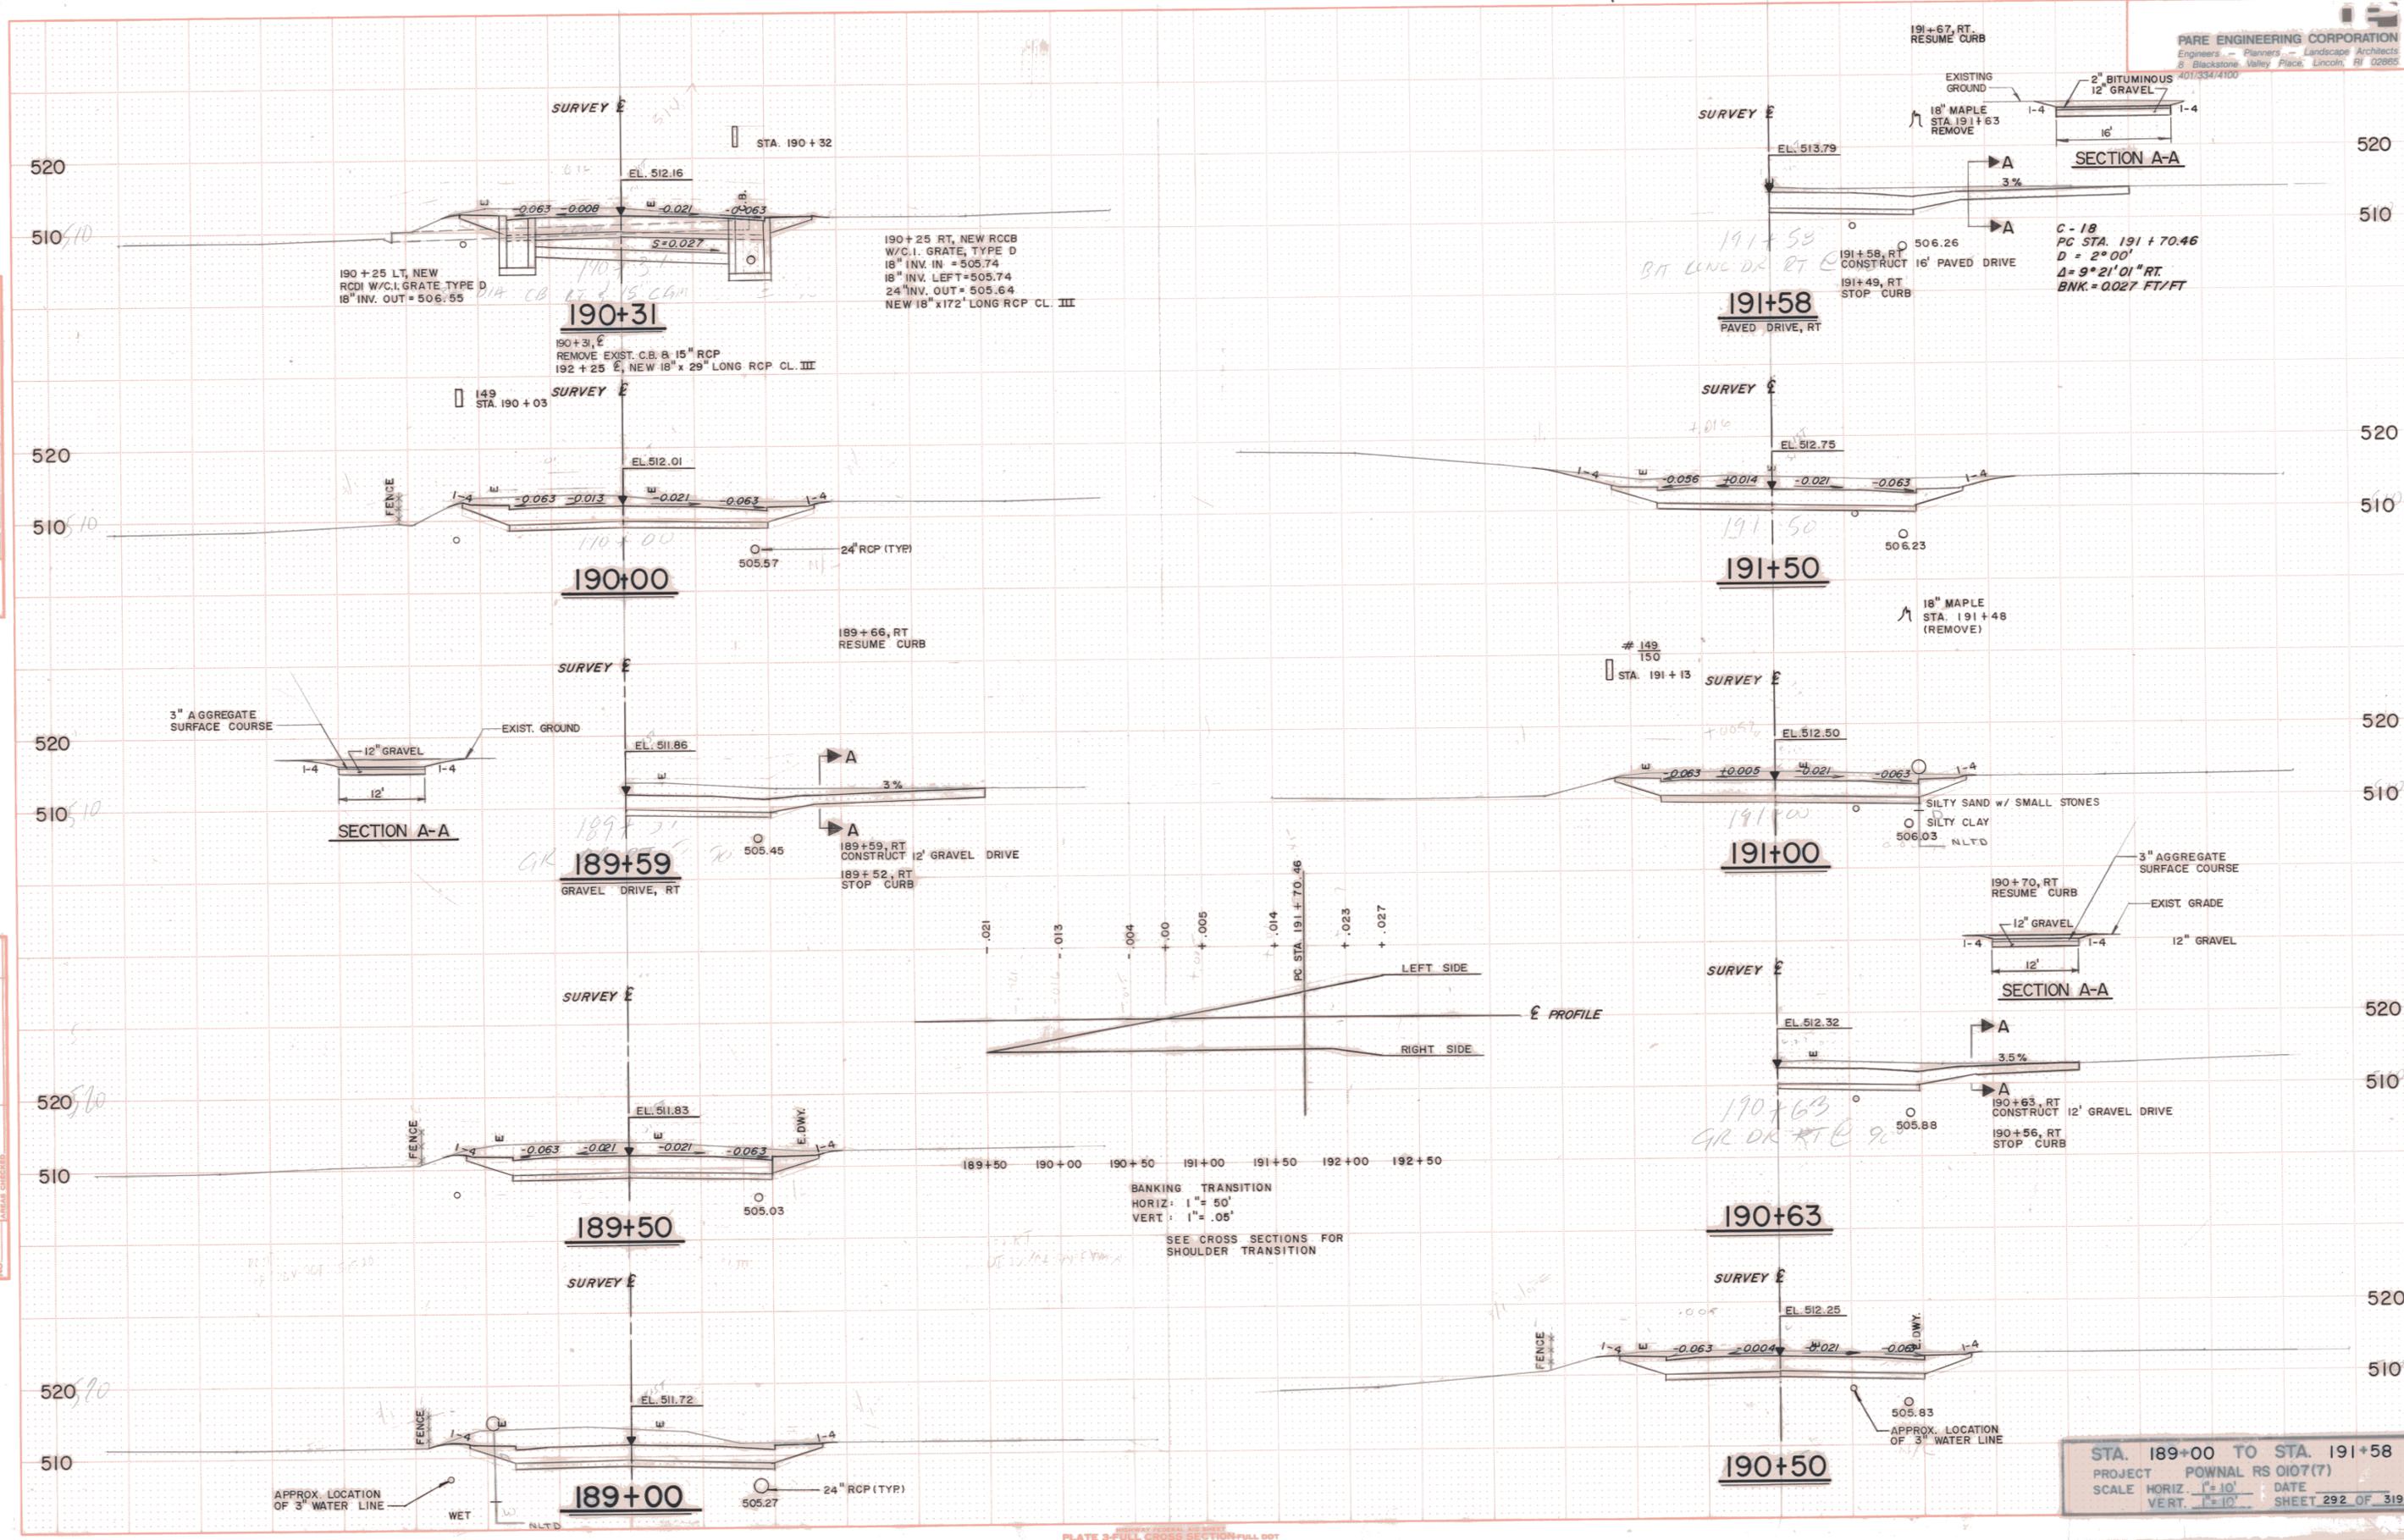

STA. 189+00 TO STA. 191+58
 PROJECT POWNAL RS 0107(7)
 SCALE HORIZ. 1" = 50'
 VERT. 1" = 10'
 DATE _____
 SHEET 292 OF 319